


	I	J	K	L	M	N	
--	---	---	---	---	---	---	--

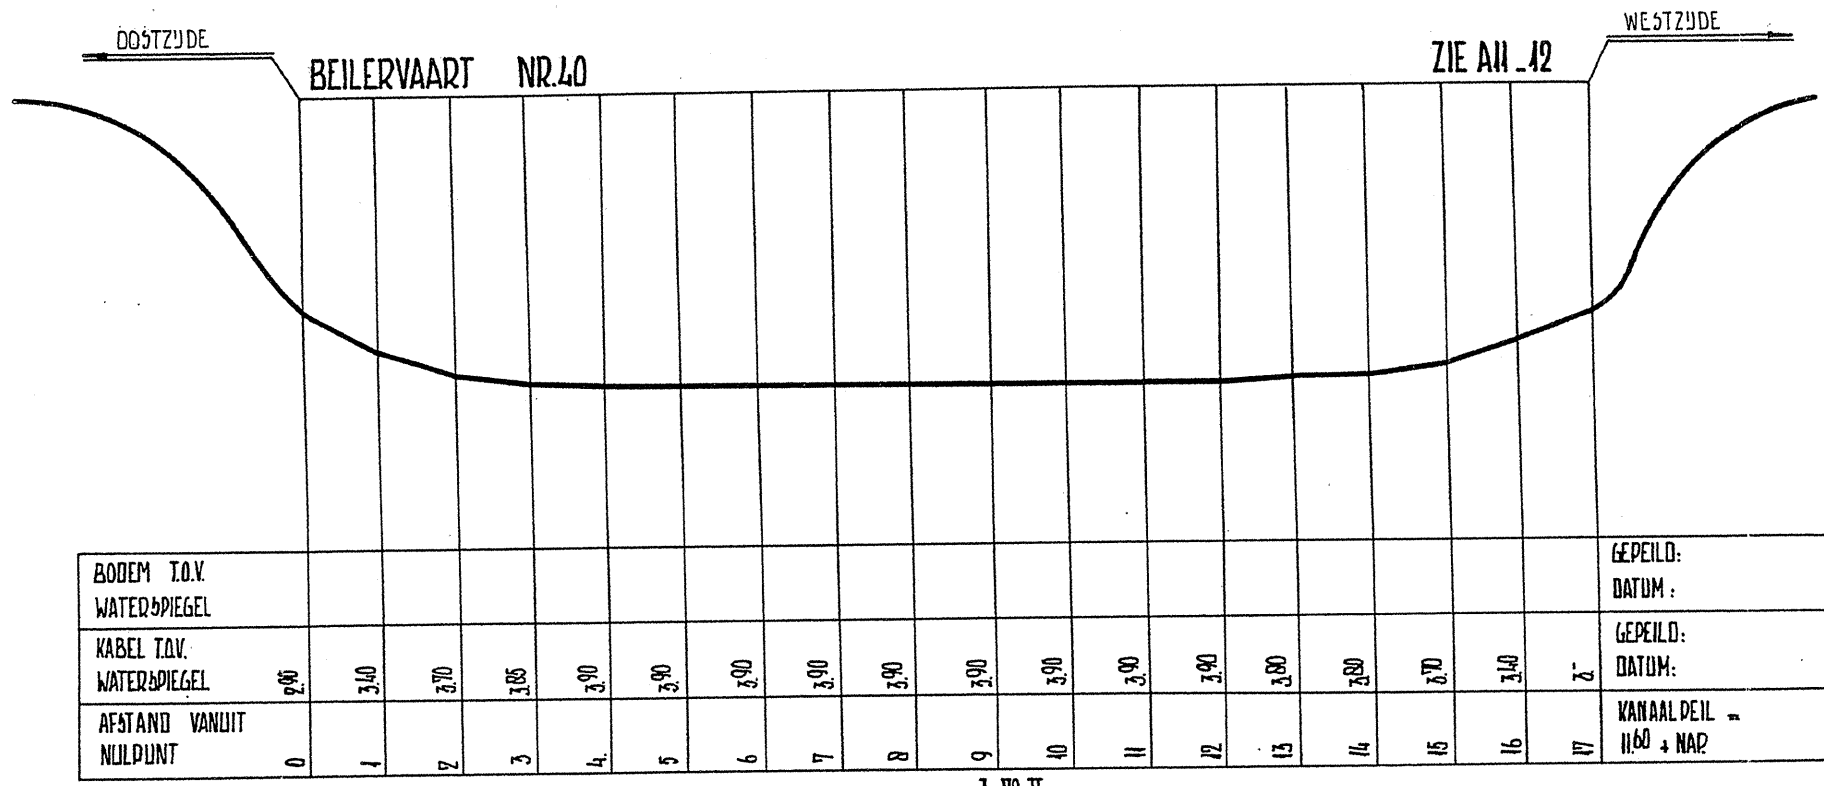

3x70 II
2250.54375 B