


O P Q R S T

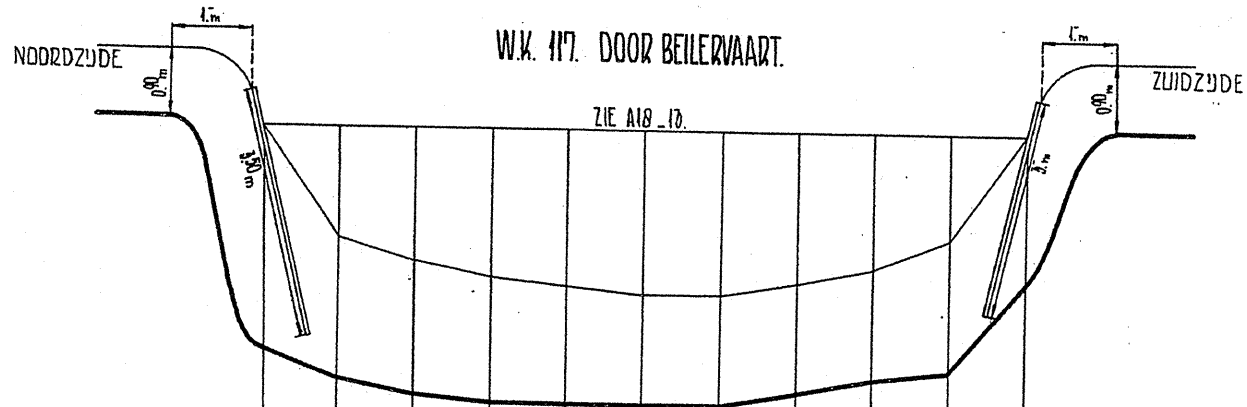

KABEL T.O.V. WATERPIEGEL.	3	240	250	270	—	—	370	350	330	320	2	GEPEILD: BEUKEMA
AFSTAND UIT NULPUNT.	0	1	2	3	4	5	6	7	8	9	10	PEIL:

3x120. AL.L. KABEL III

2270.54225 B