



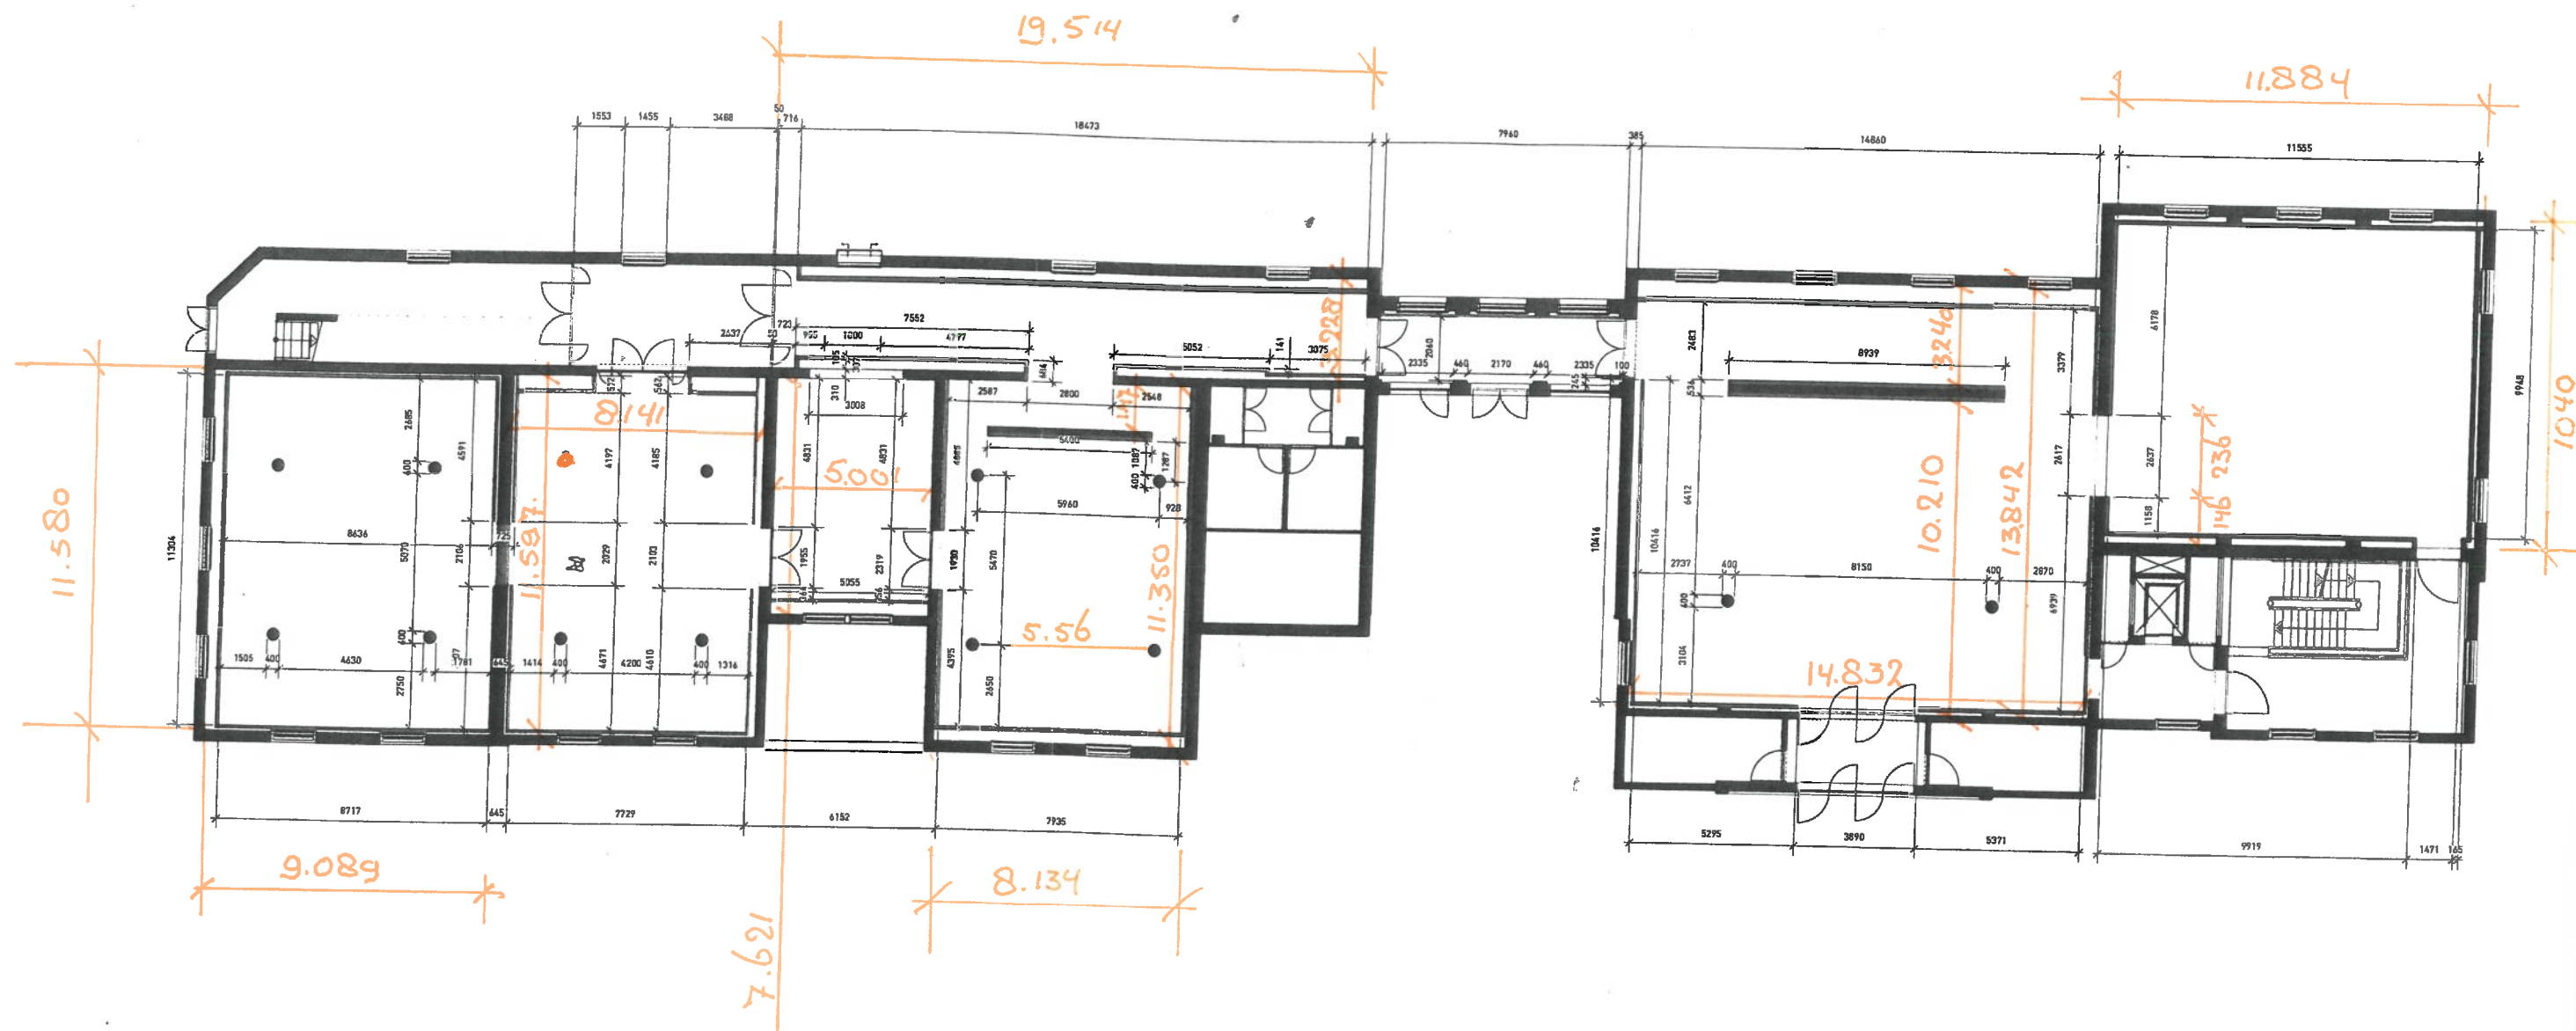

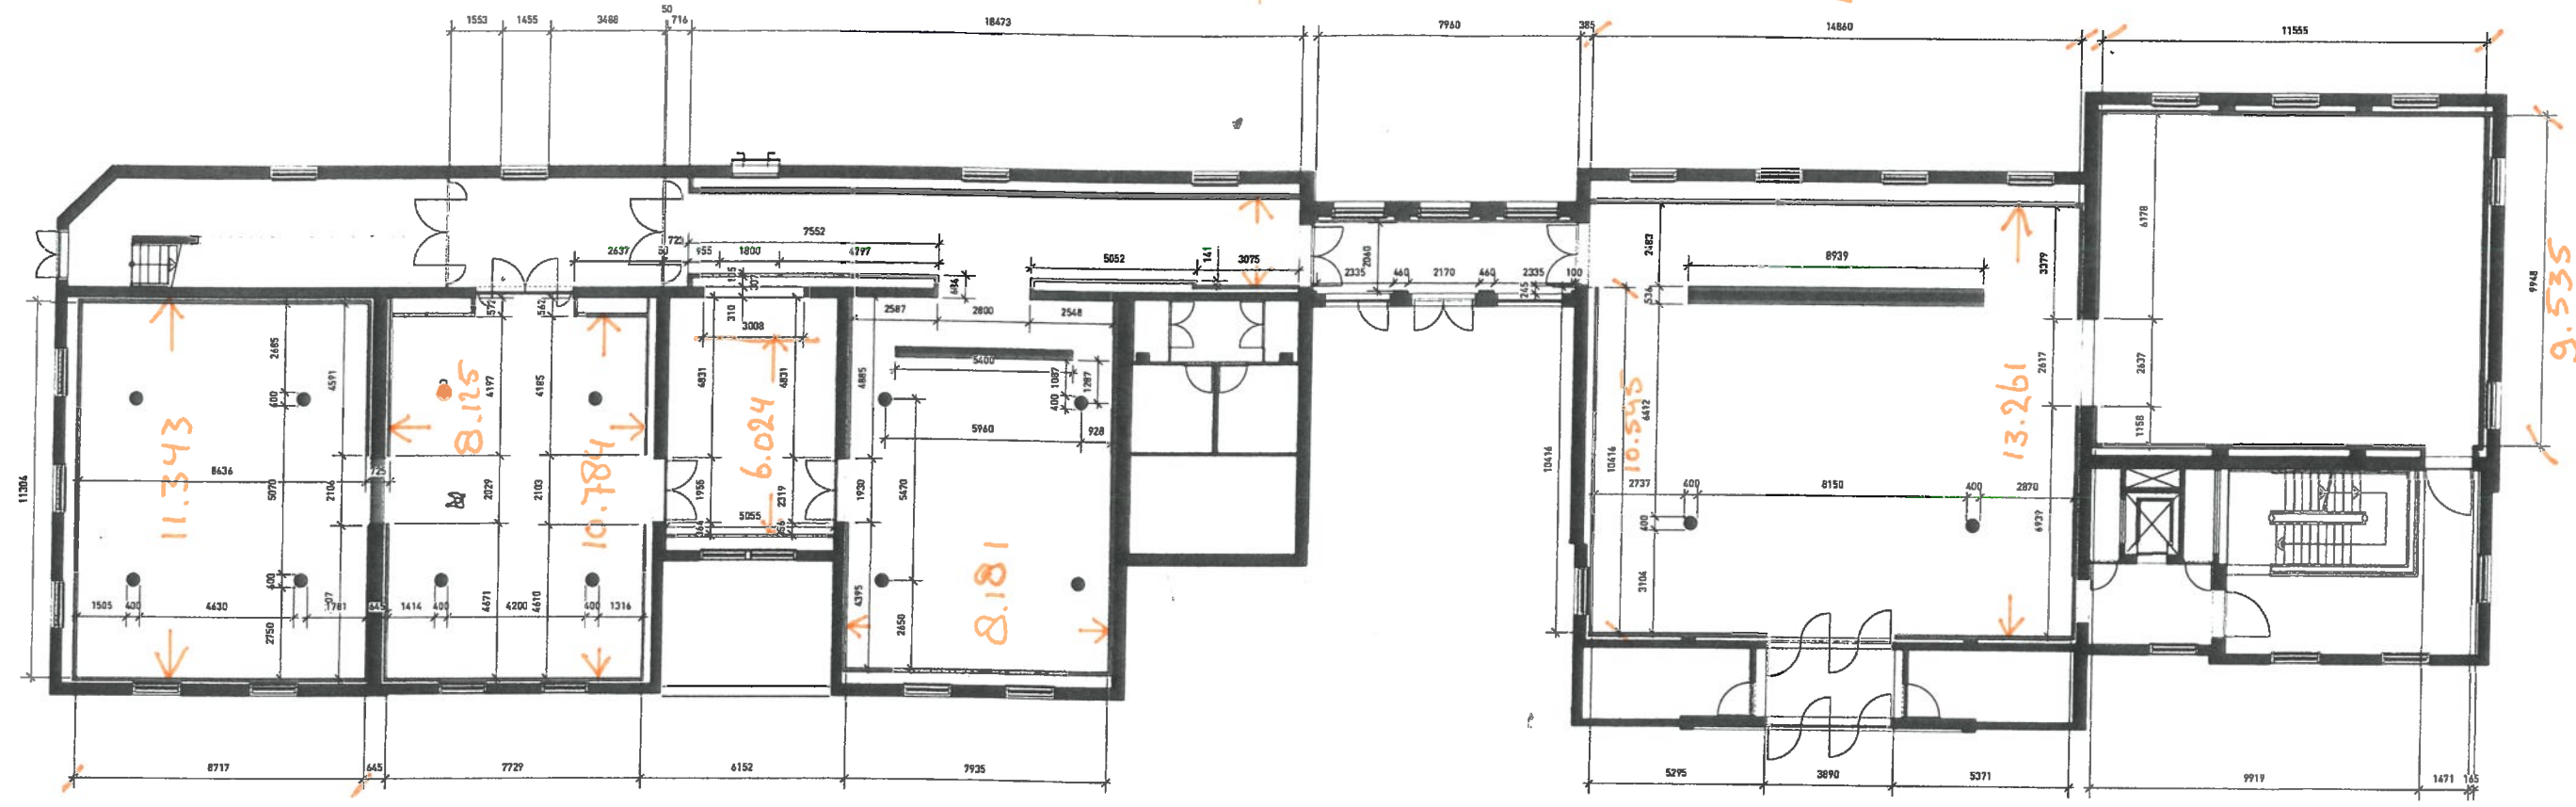

0720

 2.648

14.624

11690

9.535
B766

24-12-2014.