


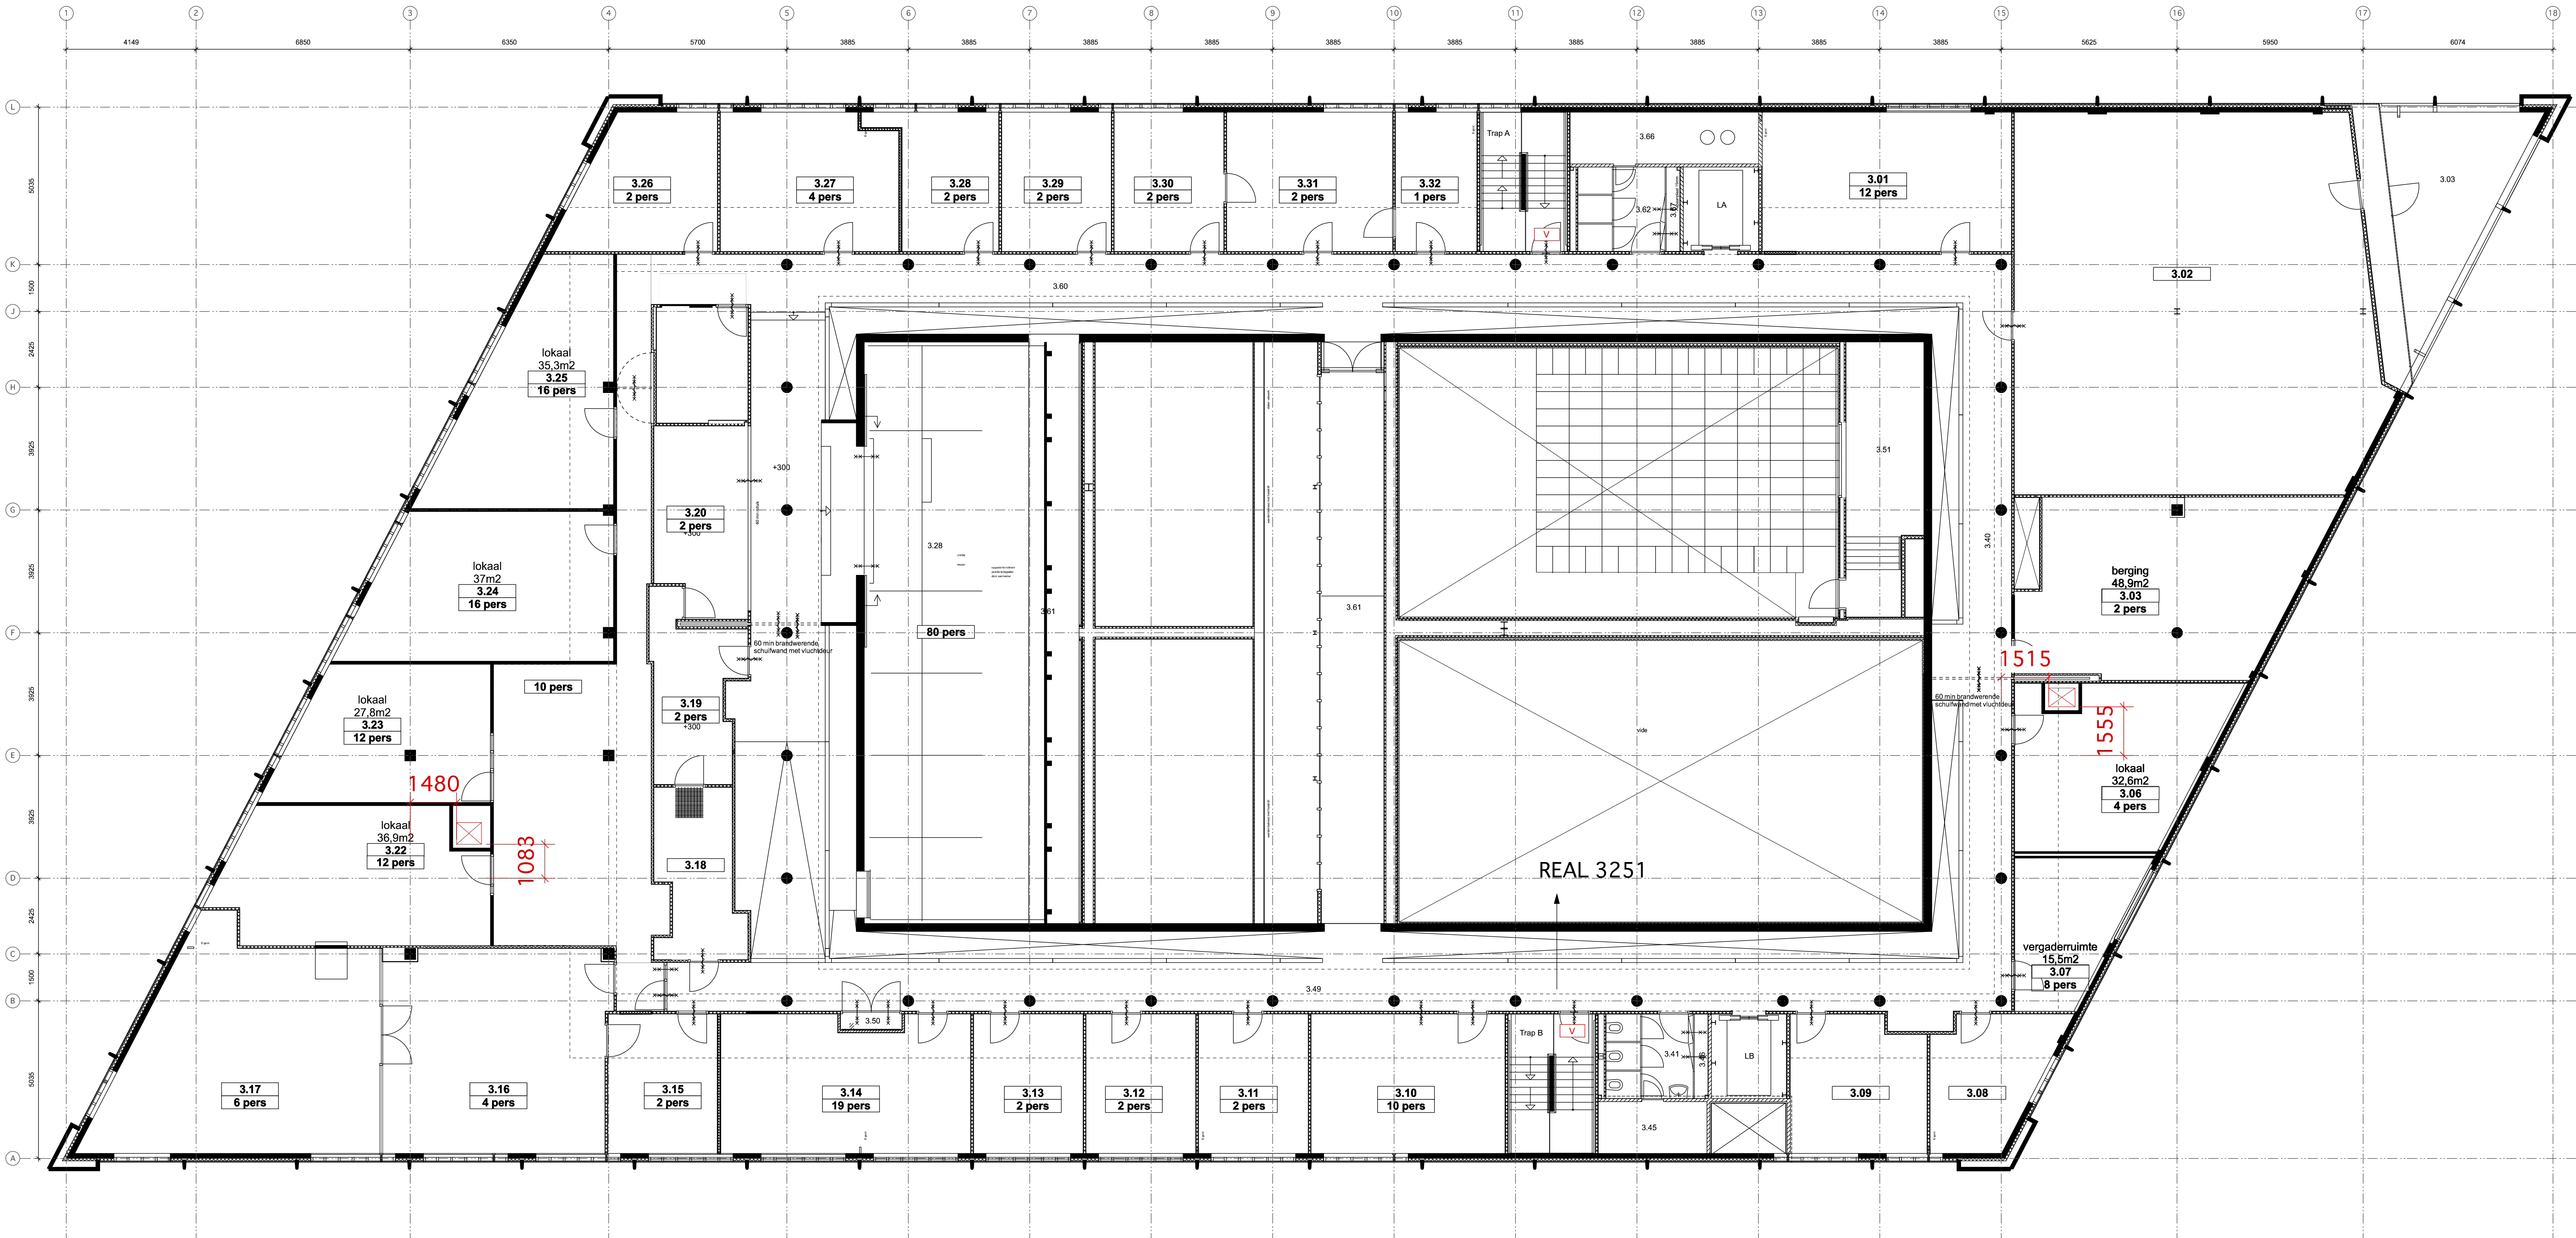

bk vloer = 11330 + P



