


datatransport	KL1010
datatransport	KL1011
datatransport	KL1049
datatransport	KL1051
gas hoge druk	KL1040
gas lage druk	KL1040
laagspanning	GM0392
laagspanning	KL1040
middenspanning	KL1040
riool over/onderdruk	GM0392
riool vrijval	GM0392
water	KL1100

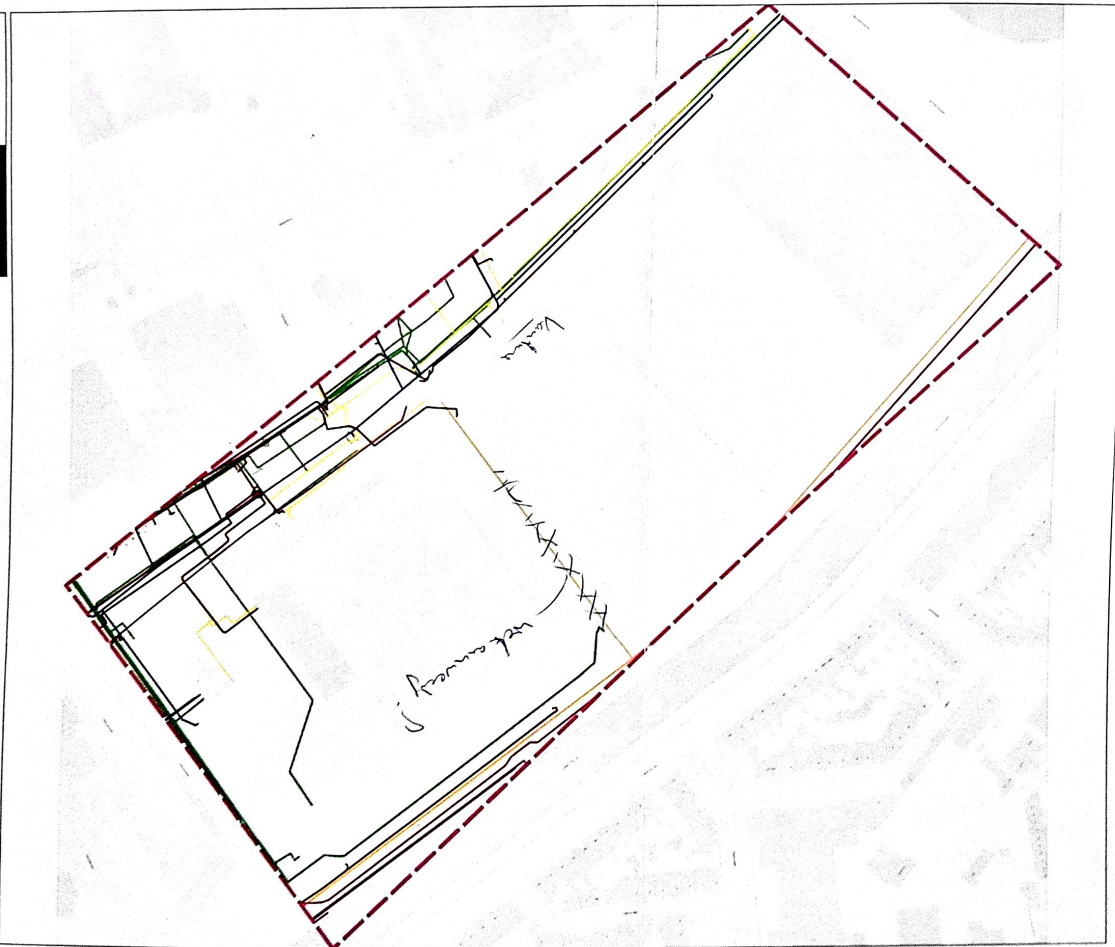

0 53 106 meter

linksonder: X: 104.499,0 Y: 491.507,0
rechtsboven: X: 104.876,0 Y: 491.906,0