


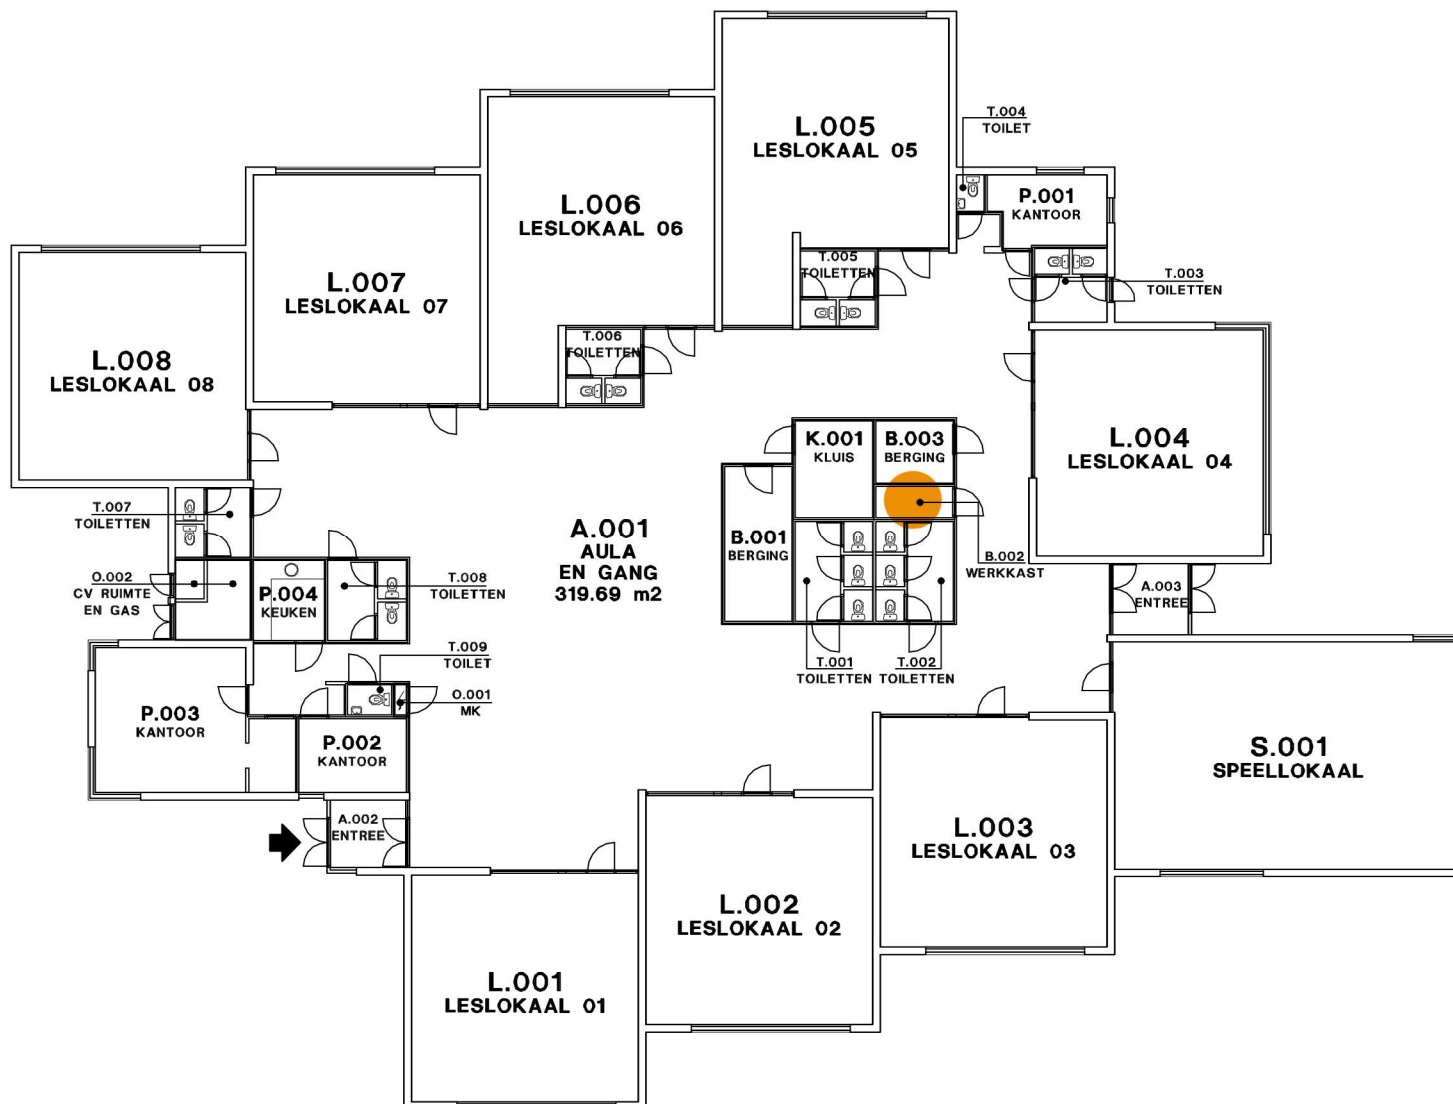

BouwAdviesNL

Postbus 15204, 1001 ME Amsterdam
Emmalaan 58, 3411 XJ Lopik

Tel. 0348 743 814

Fax 0840 031 979

info@banl.eu

www.banl.eu