


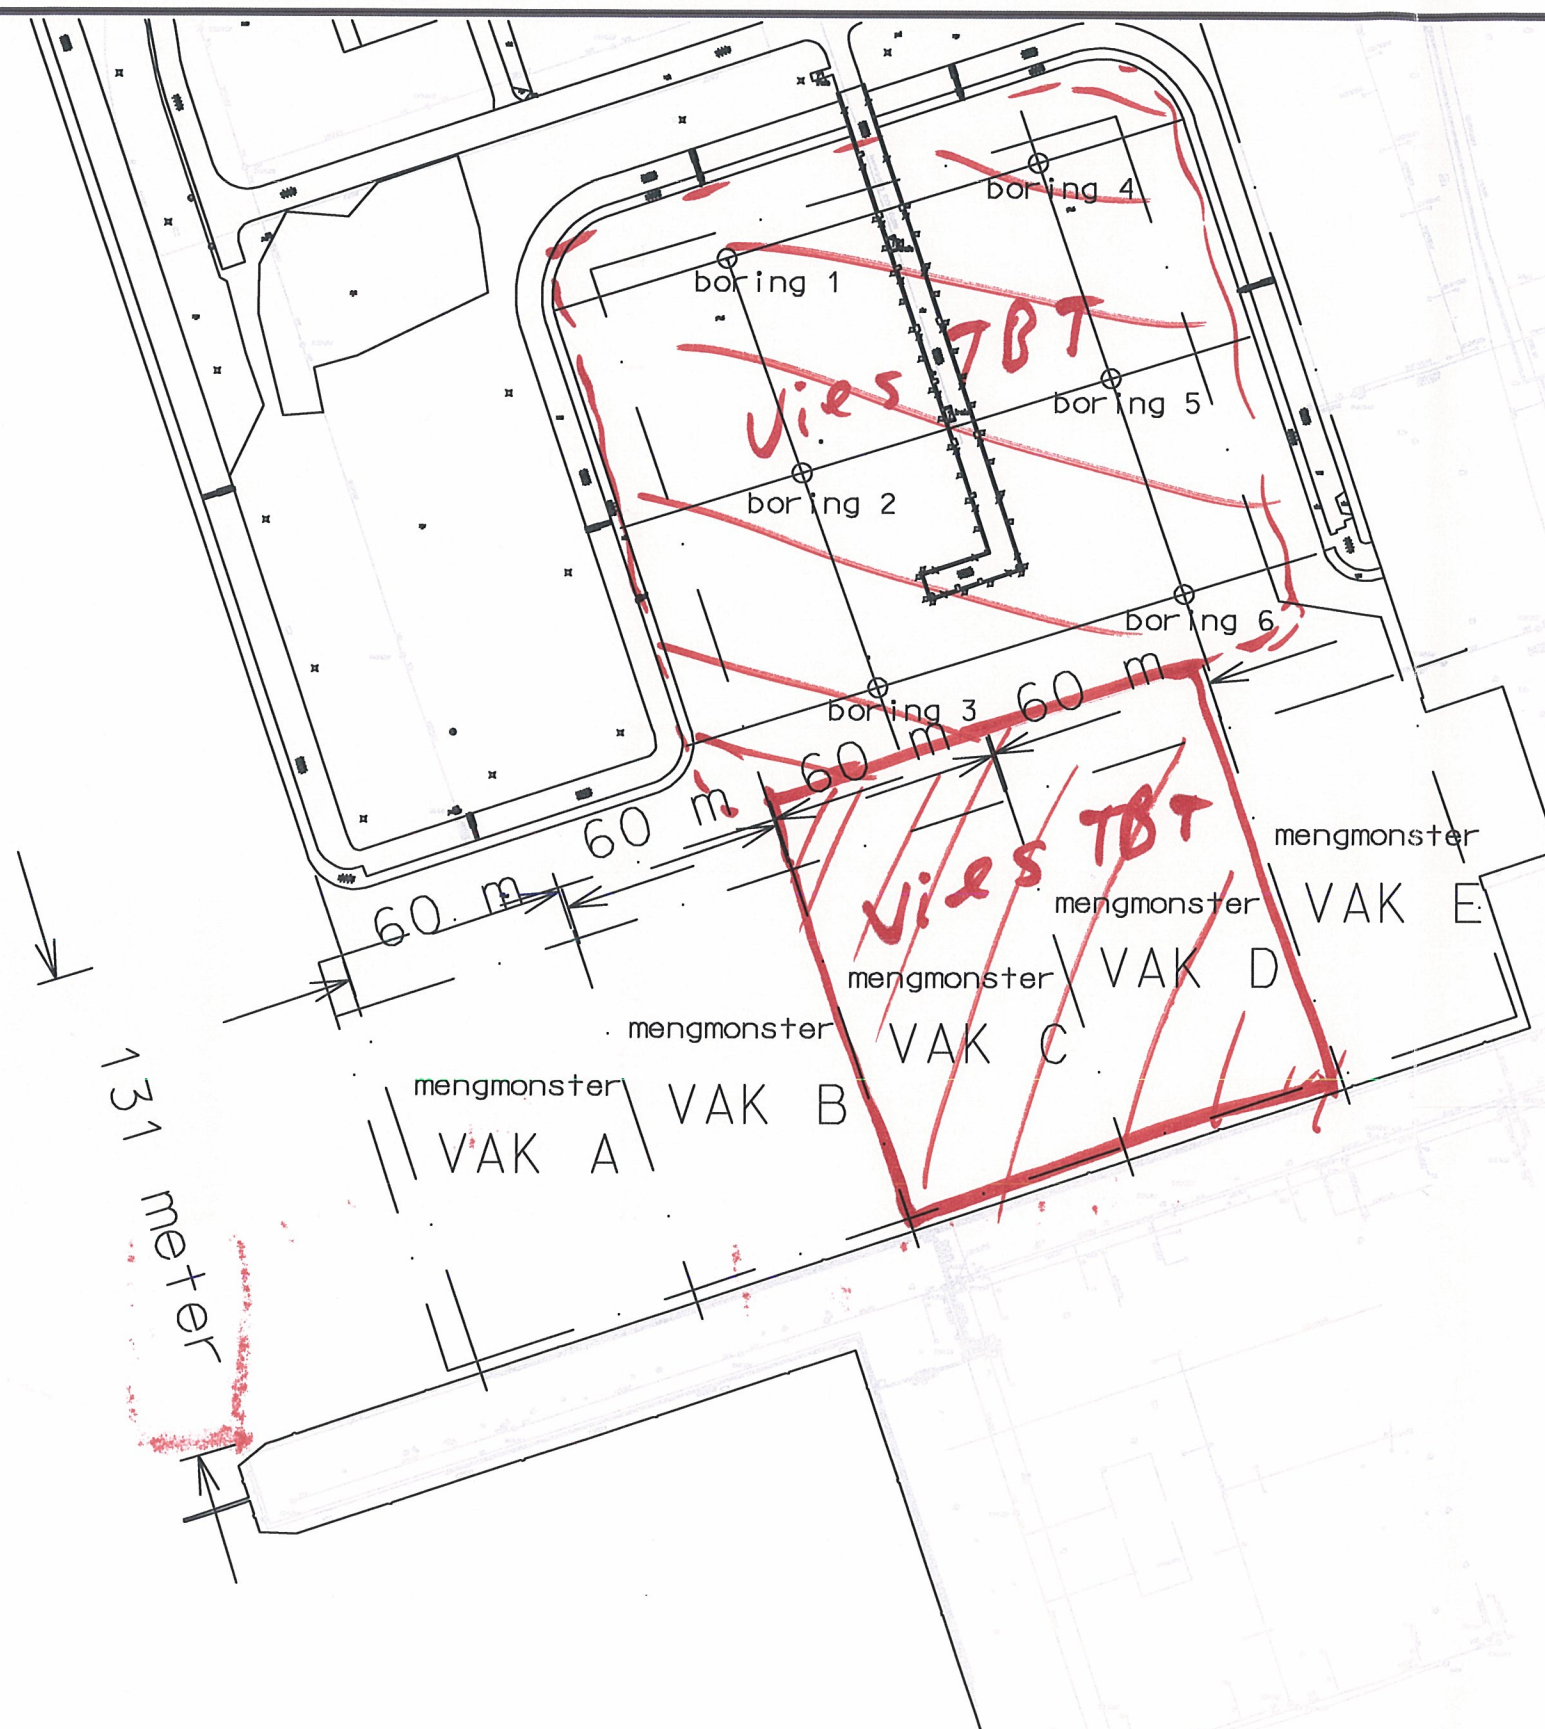

## LEGENDA

werkgrans

Doorgang naar Dok VI:

VAK

mengmonsters waterbodempaketaanalyse C3

Berghaven:

| bor ing   | x       | y       |
|-----------|---------|---------|
| bor ing 1 | 1152036 | 5528747 |
| bor ing 2 | 1152236 | 5528184 |
| bor ing 3 | 1152436 | 5527618 |
| bor ing 4 | 1152857 | 5529003 |
| bor ing 5 | 1153052 | 5528435 |
| bor ing 6 | 1153246 | 5527867 |

UDM west B.V.

Kantoor Rijswijk  
070-319 79 90Laan van Zuidhoorn 59  
2289 DC Rijswijk

Get.: GJB

Datum: 02-07-2009

Gec.:

Datum:

Schaal 1: 2.000

SITUATIETEKENING MET BOORPUNTEN

0m 20 40 60 80 100m

MILIEUKUNDIG WATERBODEMONDERZOEK  
BERGHAVEN EN DOK VI TE DEN HELDER

Opdr.: 09-05-0134

Bijl.: 1