

Beheersing Japanse Duizendknoop, locatie 45




3 X: 114754,1310
Y: 502210,6198

2 X: 114748,5747
Y: 502196,9276

1 X: 114740,8356
Y: 502169,7416

Legenda

 Japanse duizendknoop

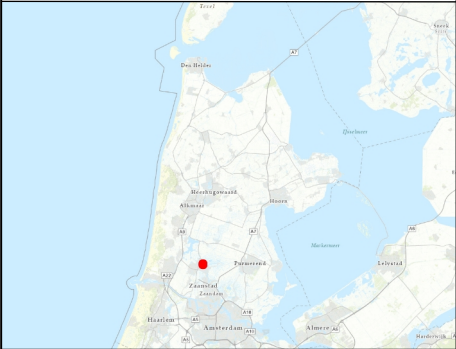

Weromerie 21 Wormer

Auteur: HHNK

Datum: 09-10-2023



Centrale locatie HHNK
Postbus 250
1700 AG Heerhugowaard

1:1.500

