



An aerial photograph of a rural landscape. A paved road runs diagonally from the bottom left towards the top right. To the left of the road is a large green field with visible plowing patterns. To the right of the road is a smaller green field and a brown, possibly harvested or fallow, field. In the upper right corner, there is a cluster of buildings, including a large barn with a dark roof and several smaller structures. A location marker with the number '1' in a white circle is placed on the road. A black callout box next to the marker contains the text: X: 115521,5069 Y: 504432,1777.

 Japanse duizendknoop

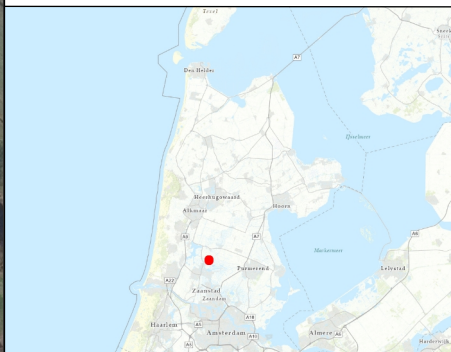

Japanse duizendknoop

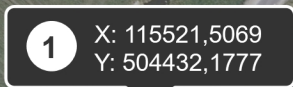

Auteur: HHNK
Datum: 09-10-2023



hoogheemraadschap
**Hollands
Noorderkwartier**

Centrale locatie HHNK
Postbus 250
1700 AG Heerhugowaard

1:1.500



15 Meters

