
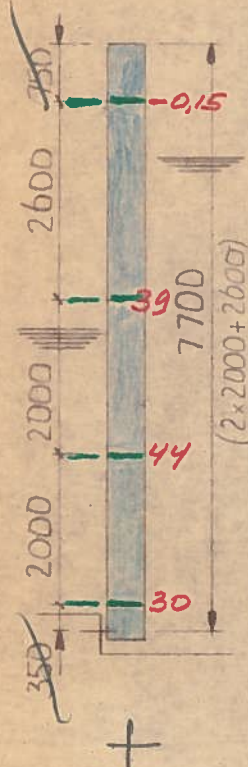
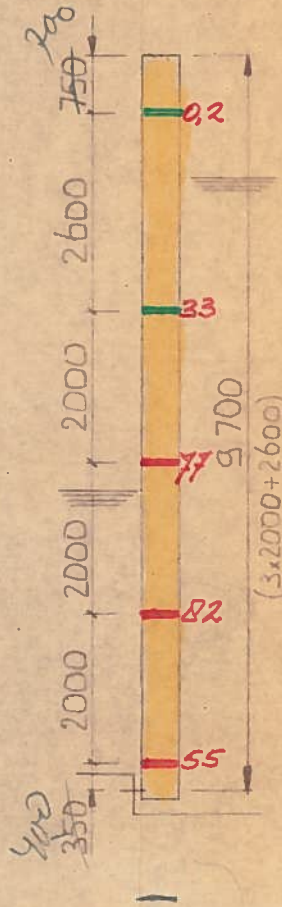



HOOGTE	
2.300	
2.000	○
1.900	+
1.700	+
1.700	×
1.200	
0.550	-
0.000	○
0.550	-
1.700	×
3.000	
5.500	

EMPEL BERLICUM SCHIJNDEL ERP AARLE-RIJTEL

WATERBELASING OP REGE

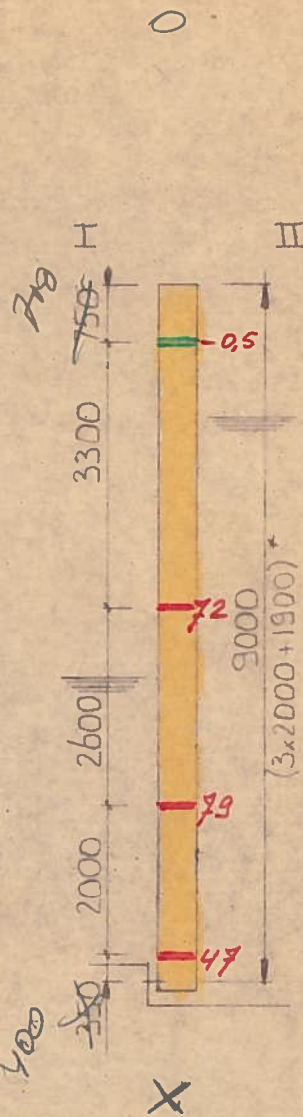

- = FLENS 200x10 LYF 690x10 (900x10)
- = FLENS 300x15 LYF 690x10 (900x10)
- = FLENS 400x20 LYF 900x12
- = FLENS 400x20 LYF 690x10

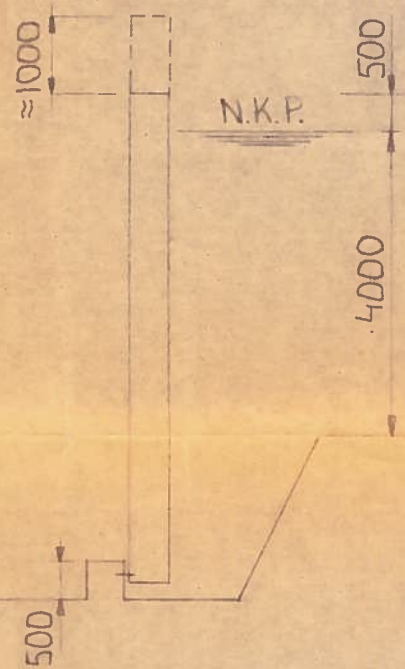

SLUIS