

SLUIS G (LB)

SLUIS H (LB)


SLUIS I (LB)

PANHEEL

15

16

GEEN SCHUTGATE

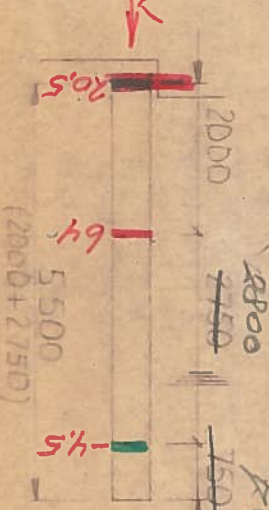

REGELS IN KN/M'

HELMOND

SOMEREN

SLUIS G

SLUIS H

SLUIS I

PANHEEL (HDOG)

PANHEEL (LAAG)

5/16/80