
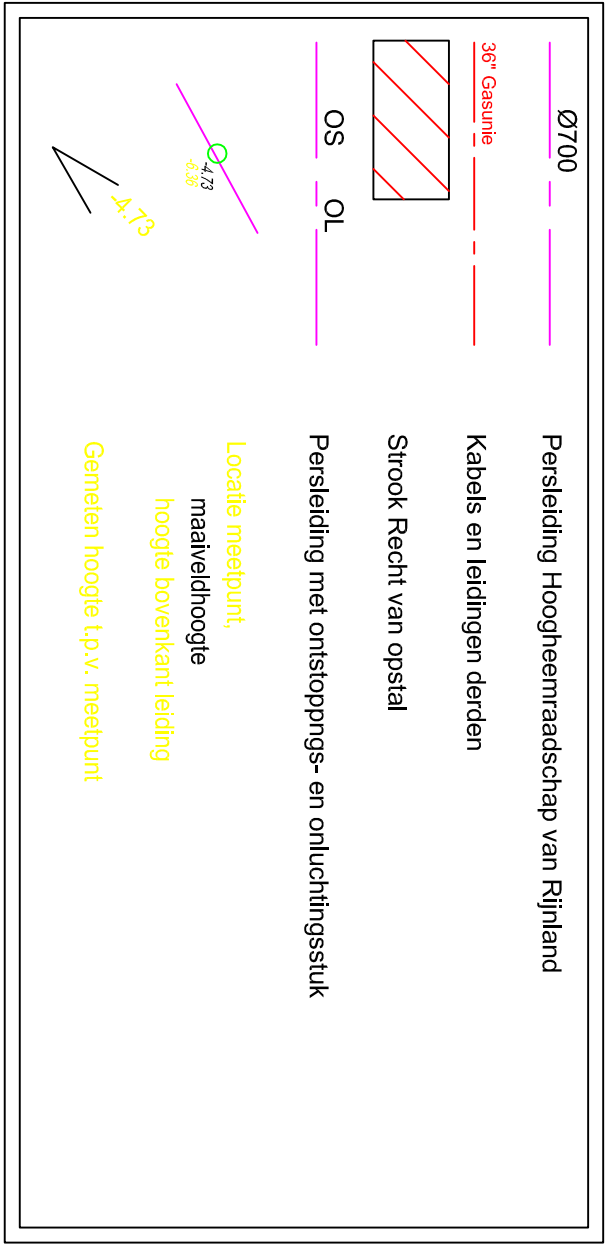
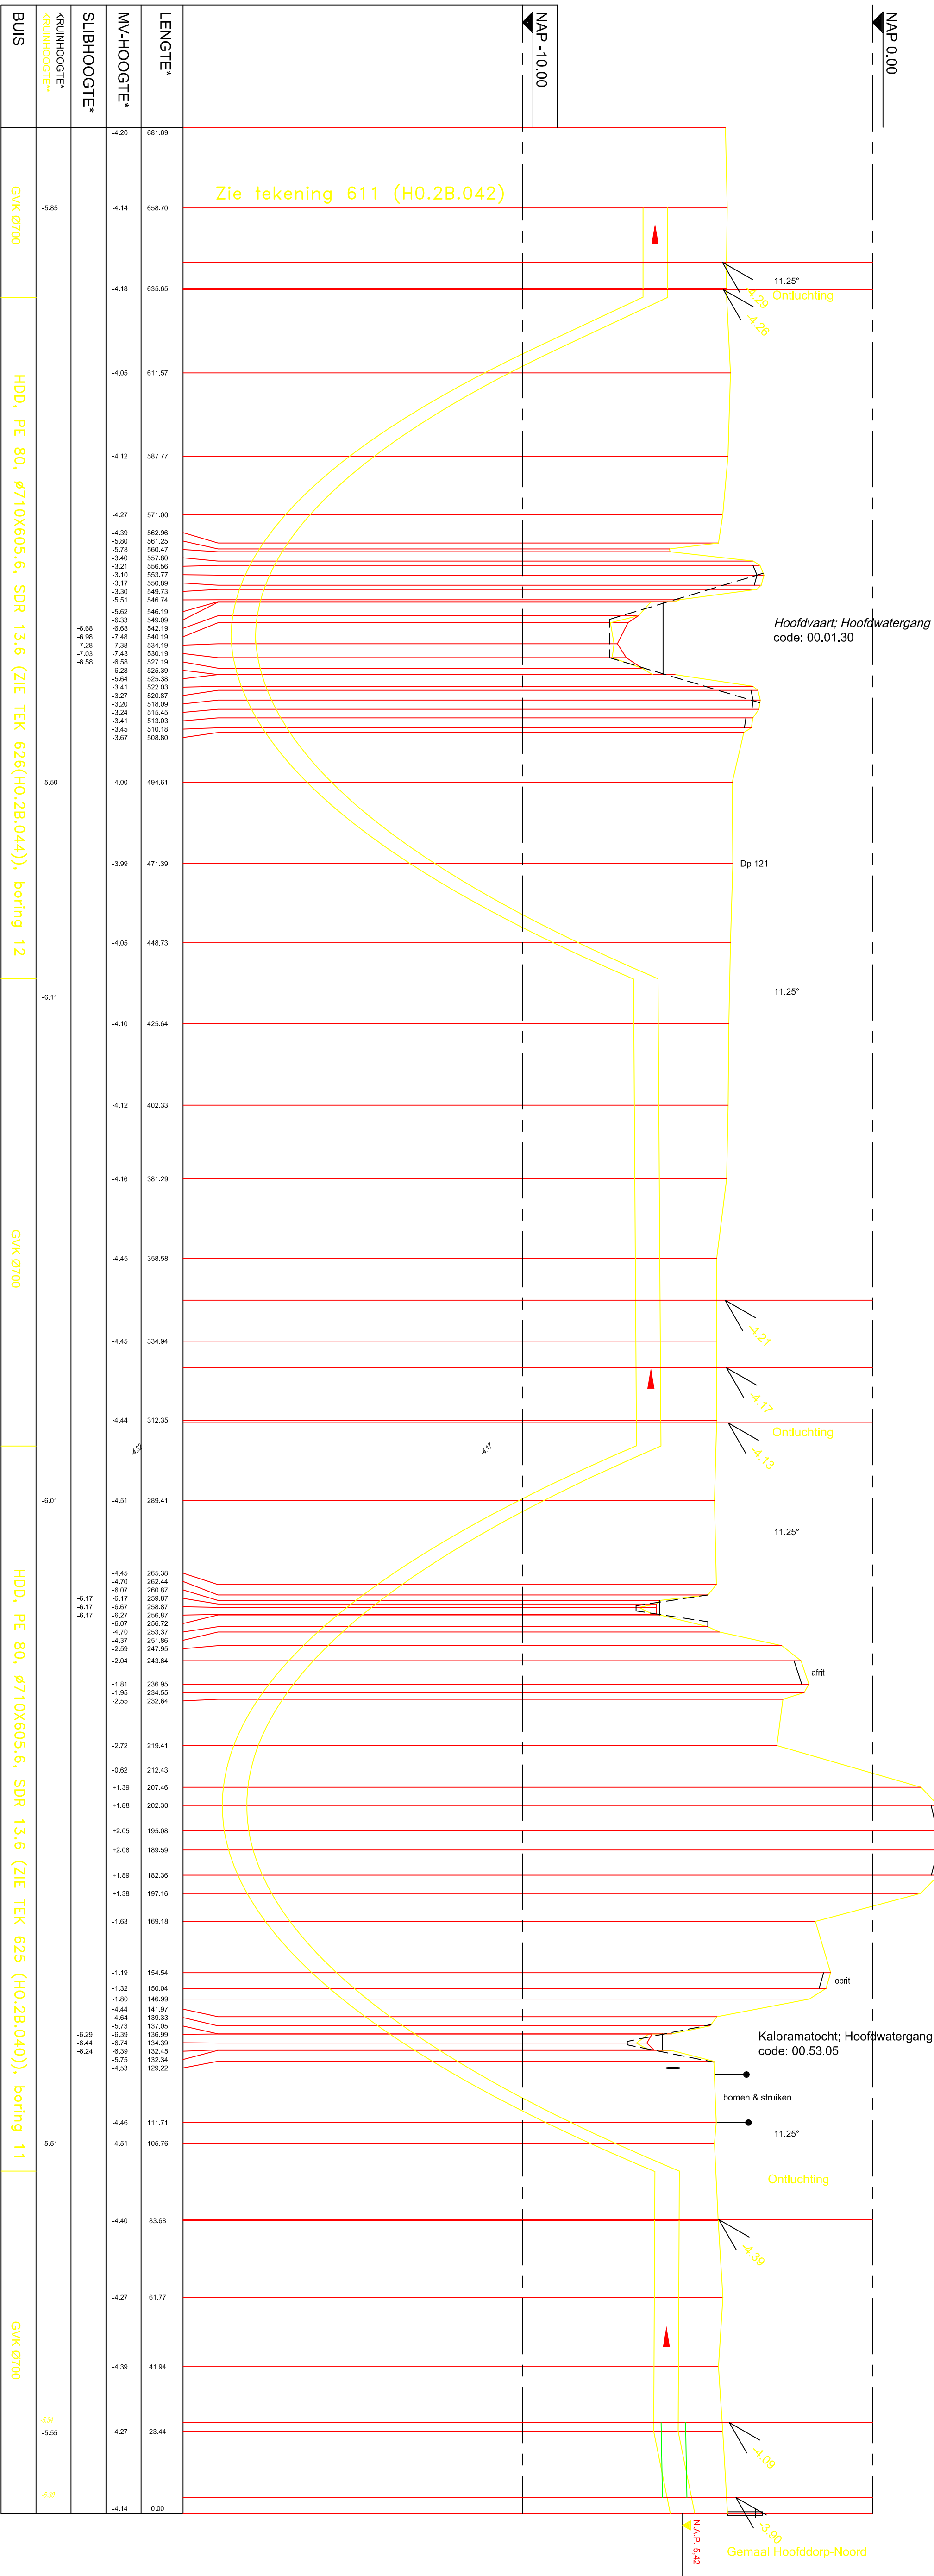


EIGENAAR	Gemeente Haarlemmermeer Postbus 250 2130 AG HOOFDDORP	Maatschappij Groot Haarlemmermeer	Gemeente Haarlemmermeer Postbus 250 2130 AG HOOFDDORP	Postbus 250 2050 AE OVERVEEN	Gemeente Haarlemmermeer Postbus 250 2130 AG HOOFDDORP	Landbouwschap van Rijland Postbus 156 2300 AD LEIDEN
PERCEELNR.	67	98	67	68	68	108
SECTIE	Gemeente HAARLEMMEER Serie AK kaart 10					
OPMERKINGEN	Rijckland 201_189					

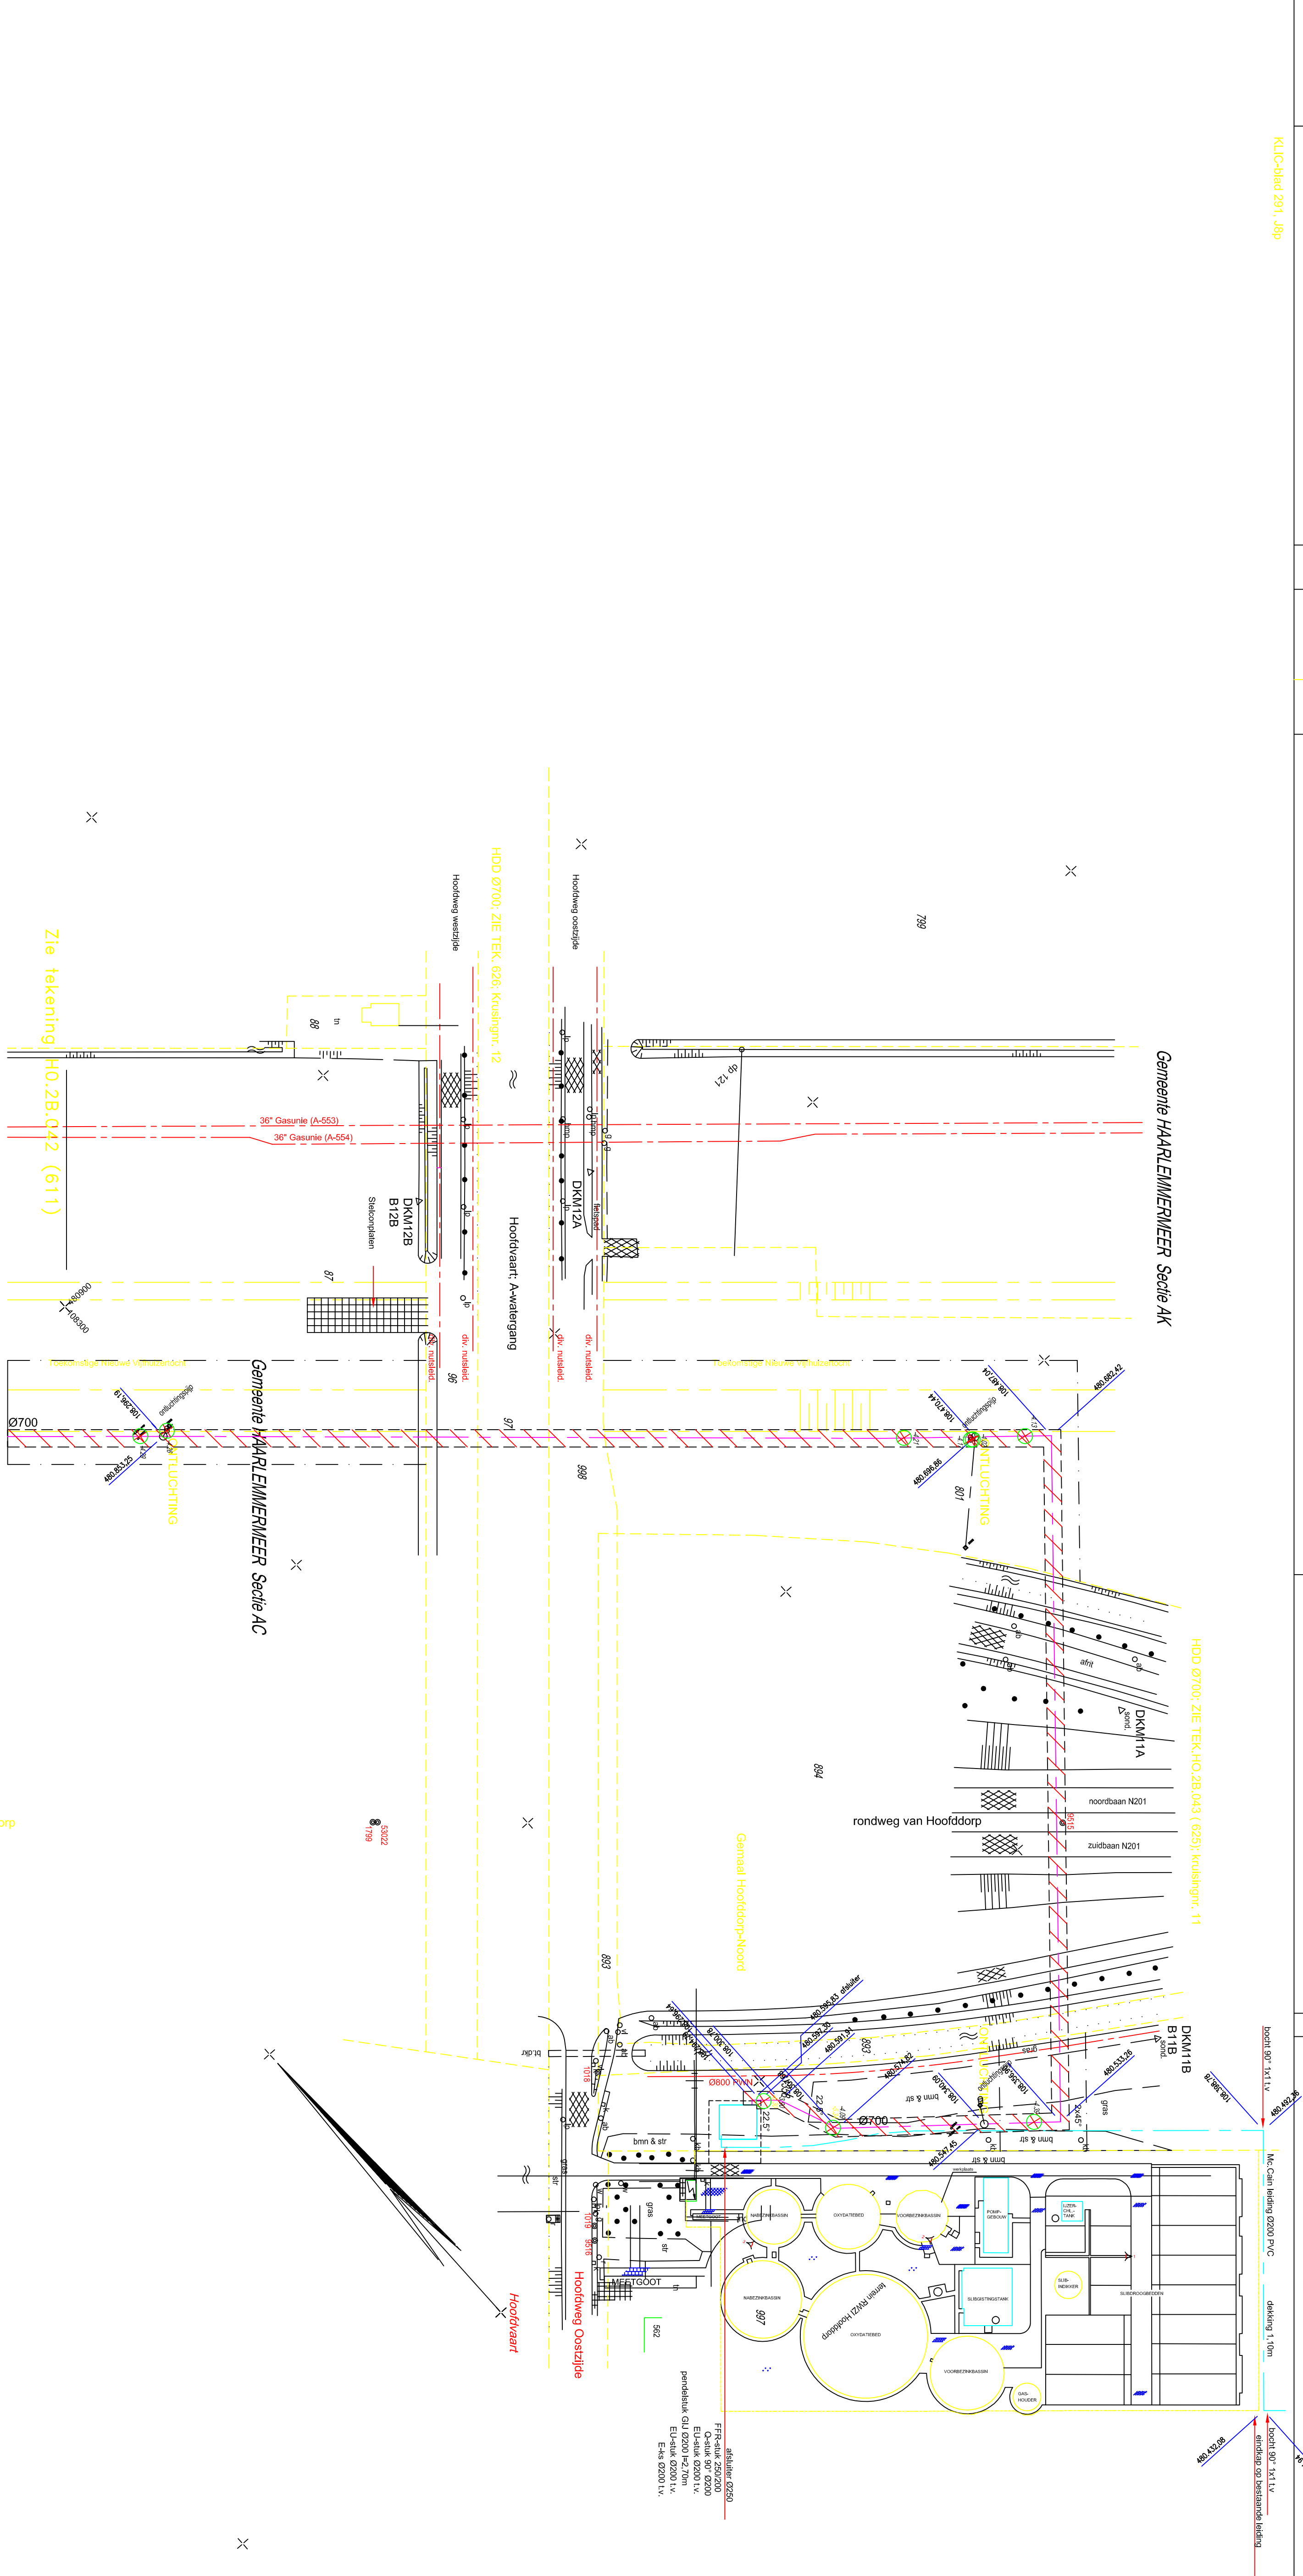

RPS		BK4 Adviesbureau		RPS		BK4 Adviesbureau		-----	--	------------------	--	-----	--	------------------	--	