


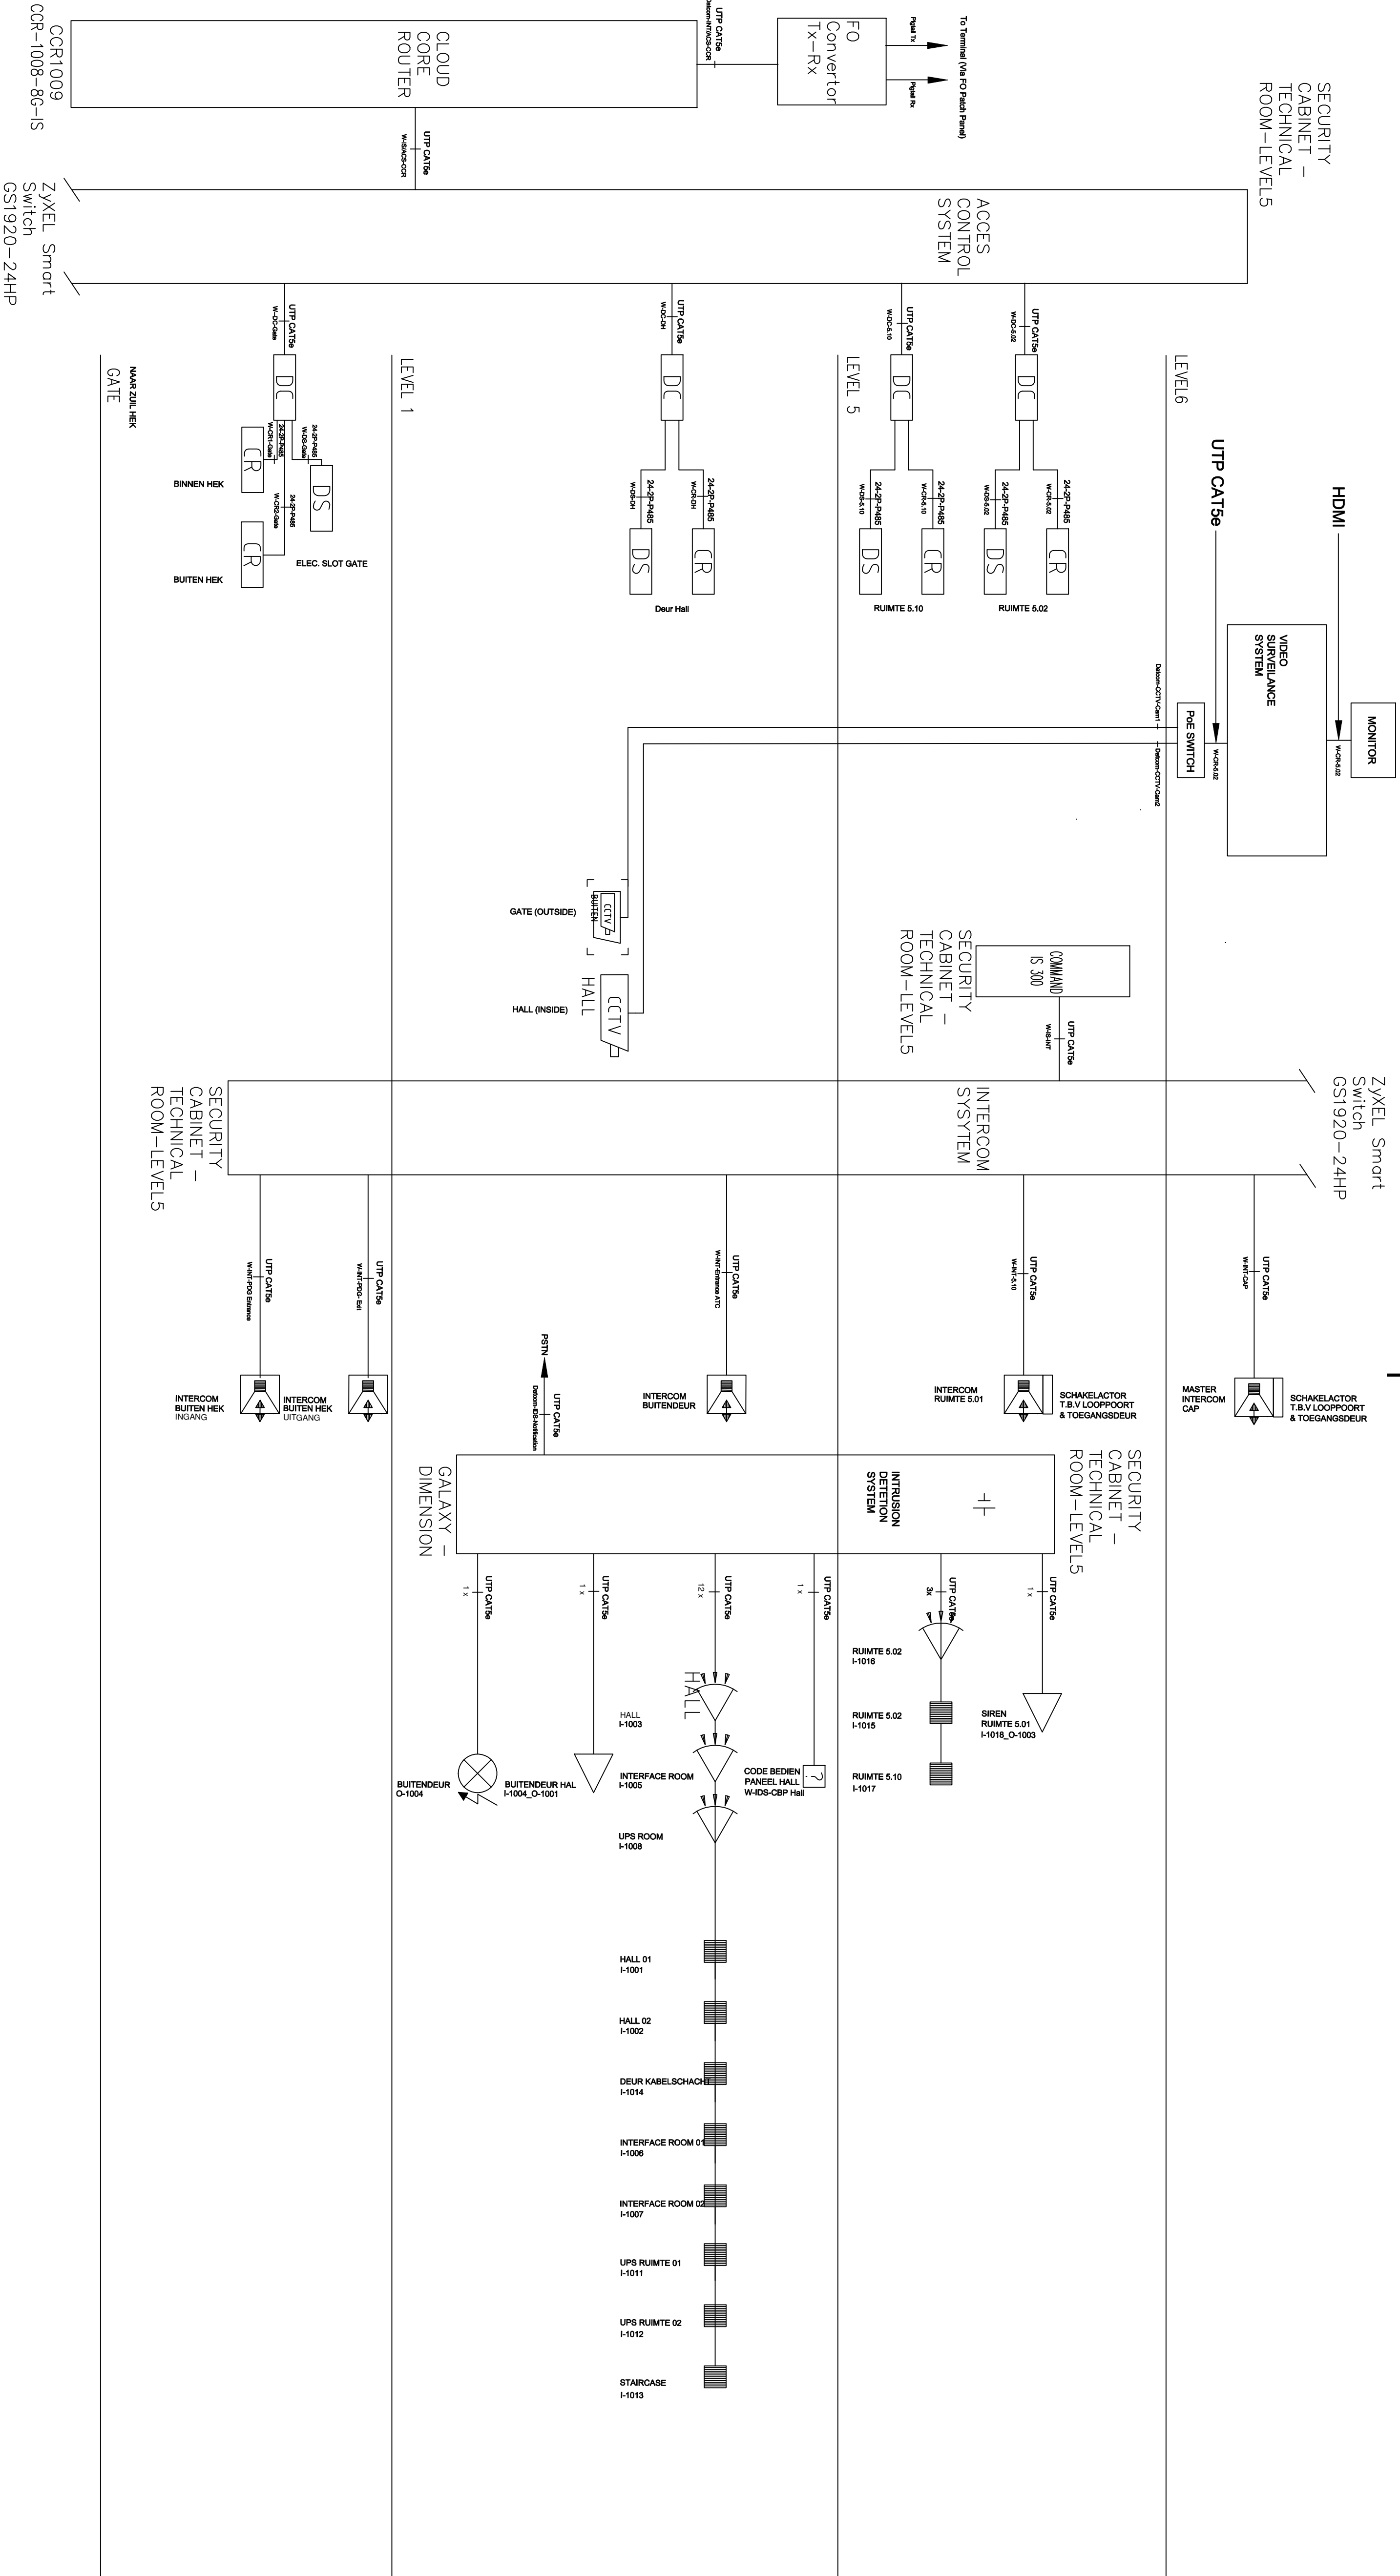

	CARD READER
	BALANCED MAGNETIC SWITCH (DOOR CONTACT)
	CODE PANEL INTRUSION DETECTION SYSTEM
	MOTION DETECTION WITH ANTI-MASKING INTRUSION DETECTION SYSTEM
	CCTV CAMERA OUTDOOR
	CCTV CAMERA INDOOR
	INTERCOM STATION
	PULSE SWITCH

C	T toevoegen kabelnummering - update equipments as-built	JYC	20-04-2018	JYC
B	As-built n.a.v. opmerkingen JYC	UG	18-04-2016	JYC
A	As Built	HYP	09-12-2015	MKN
Wfs. Omschrijving		Gevraagd	Datum	Goedgekeurd
PROJECT				
Luchthavens Caribisch Nederland- Bonaire				
OPDRACHTGEVER				
Rijkswaterstaat				
AANNEMER				
 VAN BOEKEEL				
TEKENING				
Luchthaven - Bonaire nr. 214223-TM-506-871 INTERCOM EN BEVEILIGING As Built				
get.: HYP		projectnummer: 214223		status: DEFINITIEF
Vrijgave: zie tekeninglijst		formaat: schaa.		tekeningennummer: 214223-TM-506-871
datum: 18-04-2016		nvt		B