


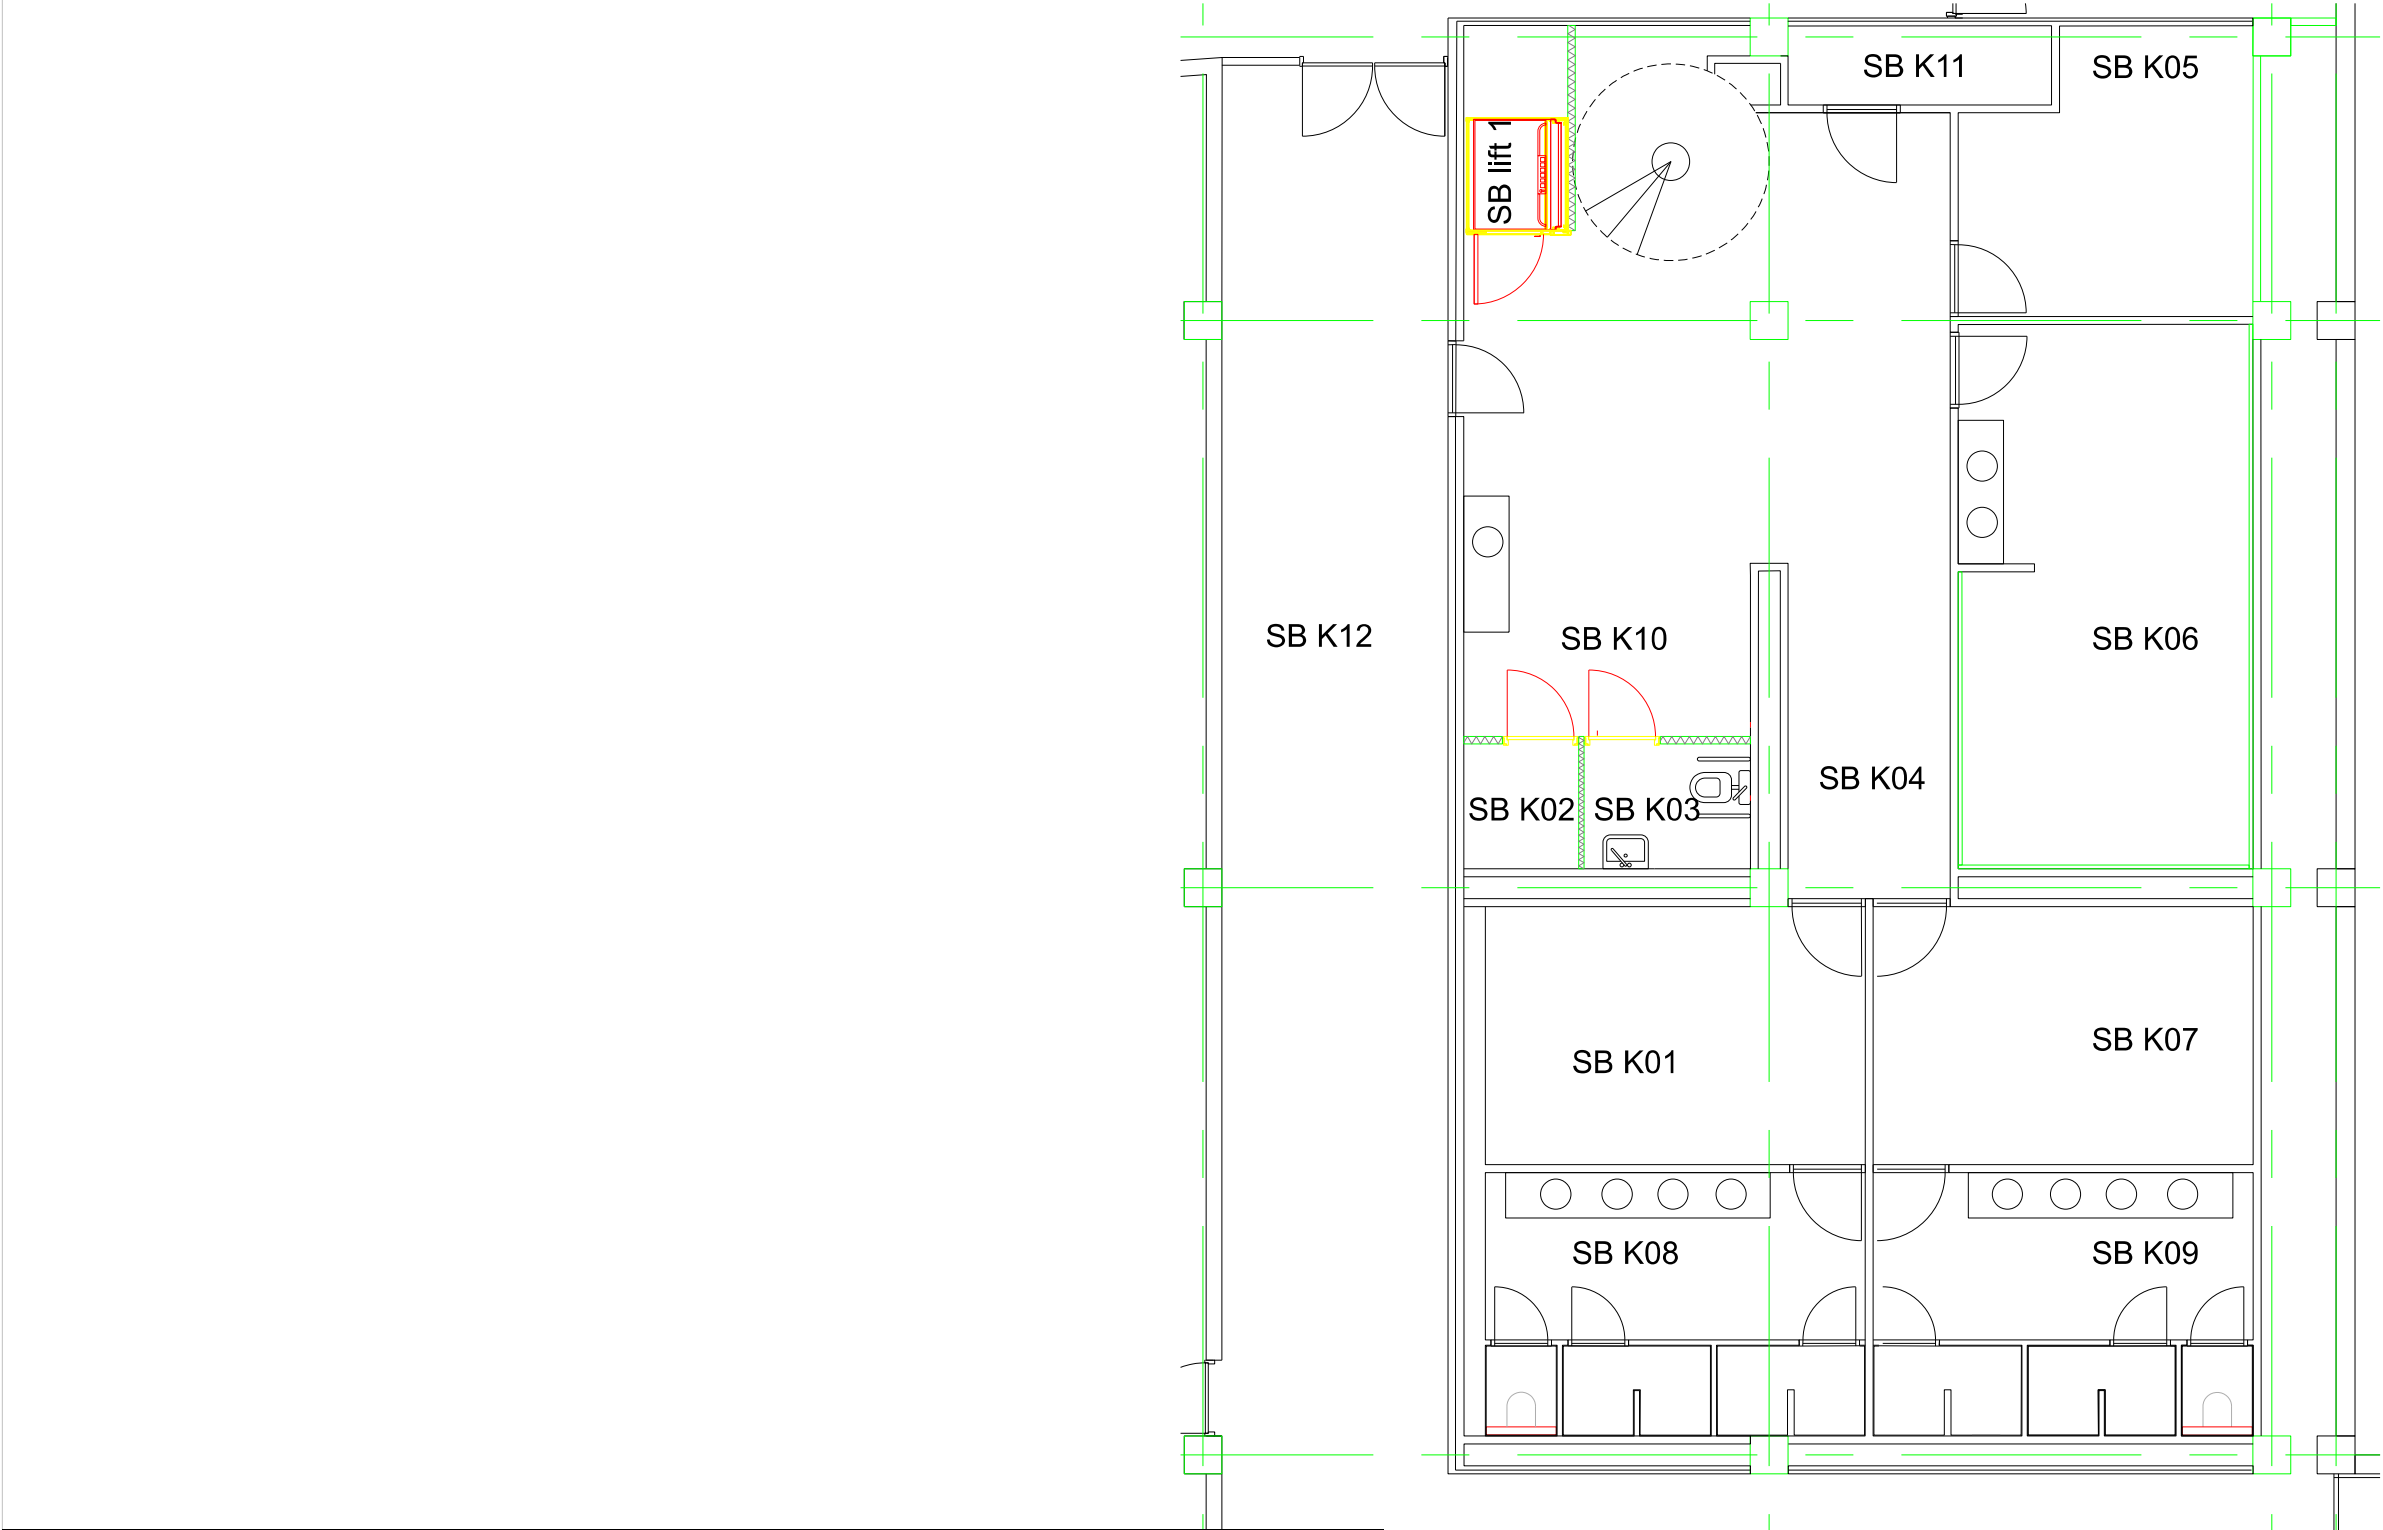

Verdieping	Ruimtenr	Functie	opp m²
kelder	SB-K01	Kleedkamer multifunctioneel	17,15
kelder	SB-K02	Washok	2,5
kelder	SB-K03	MIVA	3,6
kelder	SB-K04	Gang	25
kelder	SB-K05	Kantoor multifunctioneel	13,35
kelder	SB-K06	Kleedkamer multifunctioneel	27,15
kelder	SB-K07	Kleedkamer multifunctioneel	17,15
kelder	SB-K08	Sanitair douches en toilet	17,4
kelder	SB-K09	Sanitair douches en toilet	17,4
kelder	SB-K10	Pantry (incl spiltrap m.b.t. m2)	31
kelder	SB-K11	Technische ruimte	3,64
kelder	SB-K12	Vluchtgang richting parkeergarage	96,2

wijzigingen	Omschrijving:	Datum:	Omschrijving:	Datum:
NATIONALE OPERA & BALLET Waterlooplei 22 1011 PG Amsterdam The Netherlands Postbus 10822 1001 RH Amsterdam www.operaballet.nl		Facilitair & Gebouw		
		object: Studio Boekman kelder		
		tekeningsort: Plattegrond	formaat: A3	
		schaal: 1:100	datum: 10-10-2023	verdieping: kelder
		getekend: JK	revisie:	bladnr: van: