



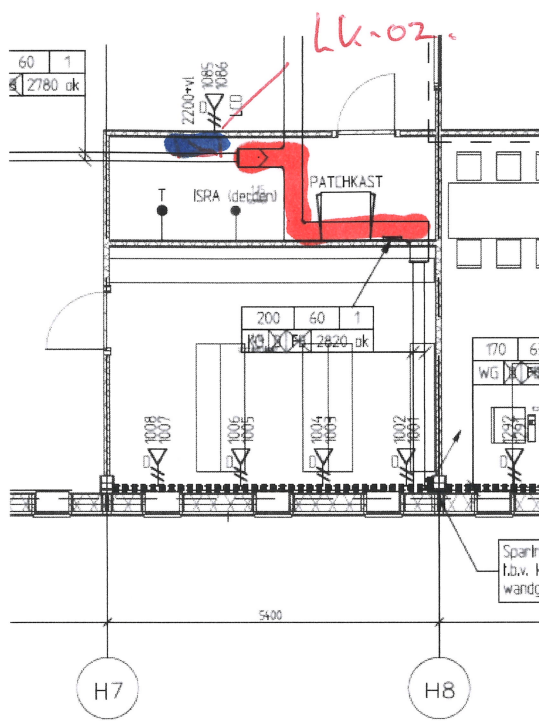

1^{ste} verdieping

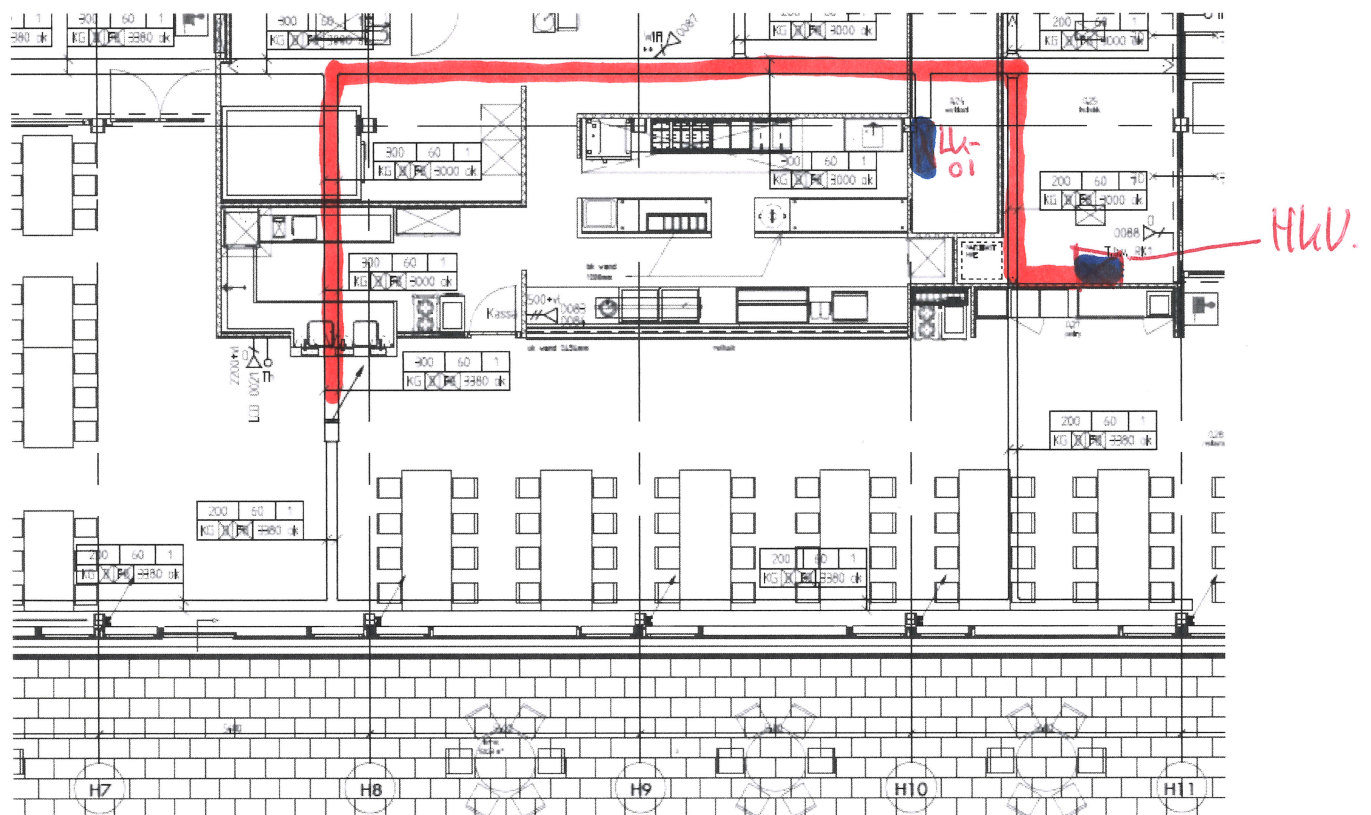

Begane grond