


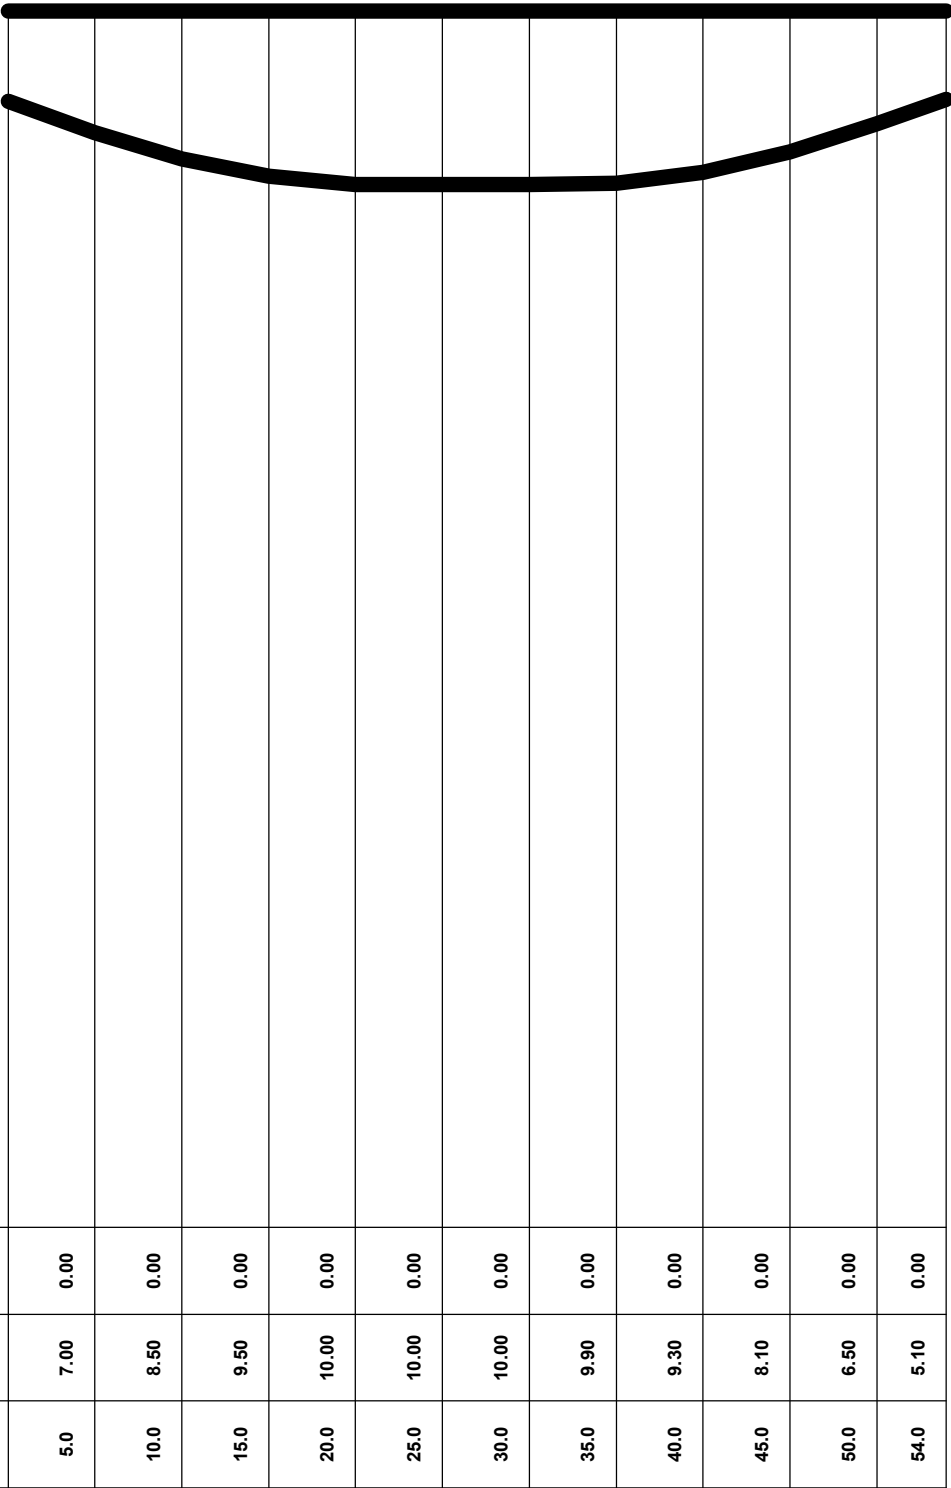

BORINGNR:775
PEILDATUM:12-05-14
L SCHAAL:1:500
H SCHAAL:1:500

Bodem t.o.v. Referentievlak	0.00	0.00	0.00	0.00	0.00	0.00	0.00	0.00	0.00	0.00	0.00	0.00
Kabel t.o.v. Referentievlak	5.20	7.00	8.50	9.50	10.00	10.00	10.00	9.90	9.30	8.10	6.50	5.10
Afstand uit het nulpunt	0.0	5.0	10.0	15.0	20.0	25.0	30.0	35.0	40.0	45.0	50.0	54.0