





Adres : Plasweg 6
Plaats : Waddinxveen
Datum : 30-10-2018

Maaiveld

	x	y	z		x	y	z
108	103.336.122	450.535.963	-5.756	110	103.343.823	450.528.847	-5.657

Lengte = 11 m1

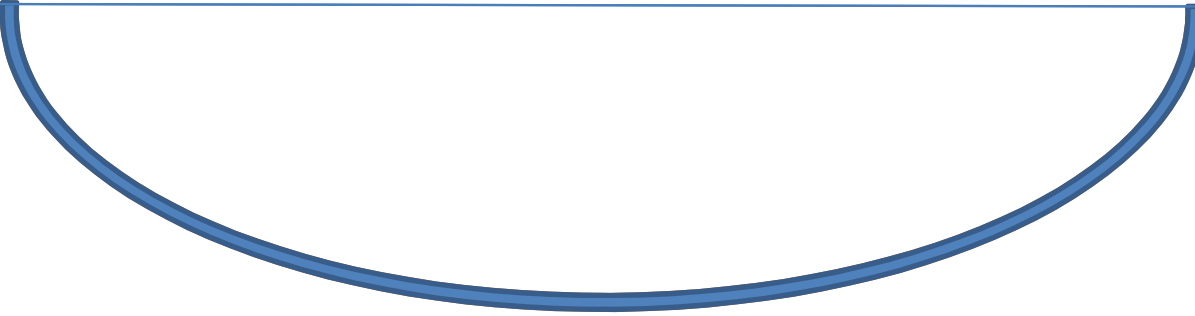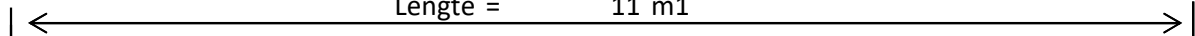

Zinker PE :
D(mm) : 110

Diepte (m) : 2,36

Boogstraal (°) : R8
Intredehoek (°) : 50