


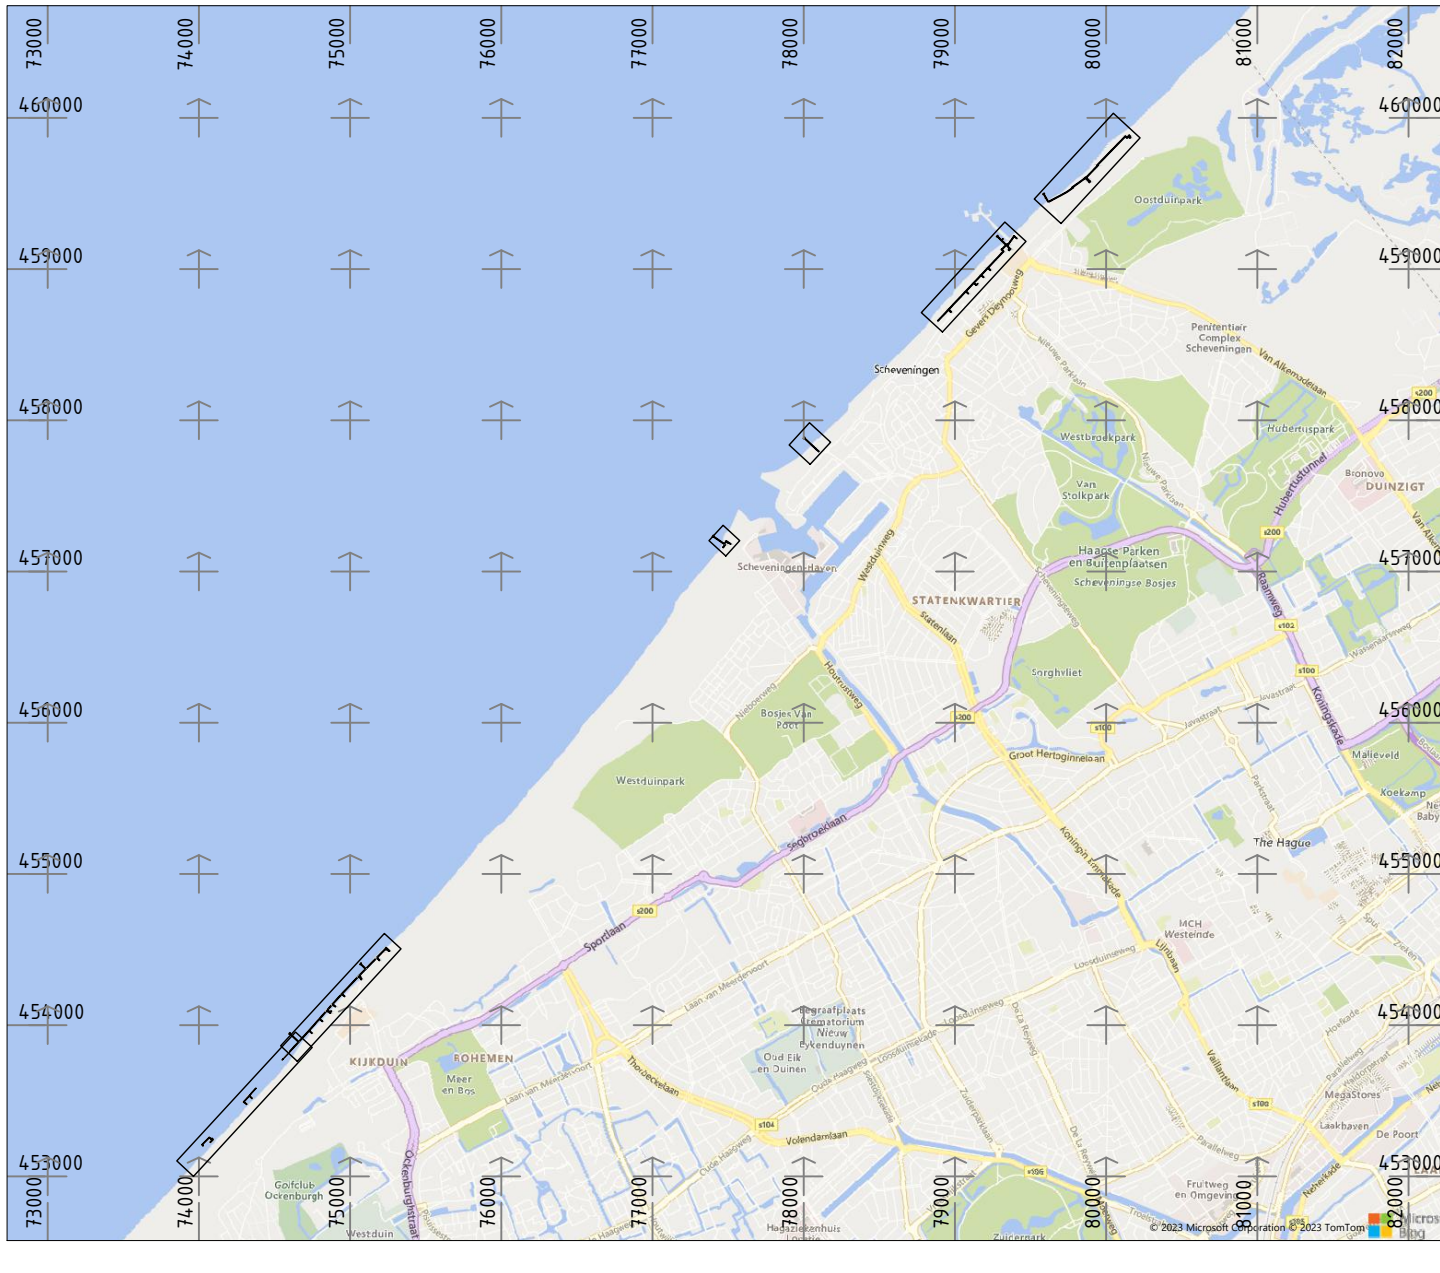

Maatvoering in meters
Hoogtematen in meters t.o.v. N.A.P.
Matenmaten in millimeters

0 20 40 60 80 100m
1:1000

**unihorn**
verbinders in infra

Unihorn bv
Postbus 58
1634 EA Scharwoude
info@unihorn.nl
unihorn.nl

Vestiging Scharwoude
1634 EA Scharwoude
0220-547650

Geodata & Monitoring

Milieu

Ontwerp

Verderingen

Asset Management

Opdrachtgever : STRUKTON WEGEN & BETON									
Project : SCHEVENINGEN									
Onderwerp : INMETING STELCONPLATEN									
Projectnummer: 3905-230324-01	Tekeningnummer: 3D-INM-06001	Bestandsnummer: -	Schaal: 1:1000	Formaat: A0	Blad: 01	Van: 01	Documenttype: TEKENING	Status: DEFINITIEF	
Bekend door: S. VAN DER WERF		Gecontroleerd door: -		Geautoriseerd door: -		Eerste uitgegafte: 22-11-2023			
						Documentnummer: 230324-01-3D-INM-06001			