


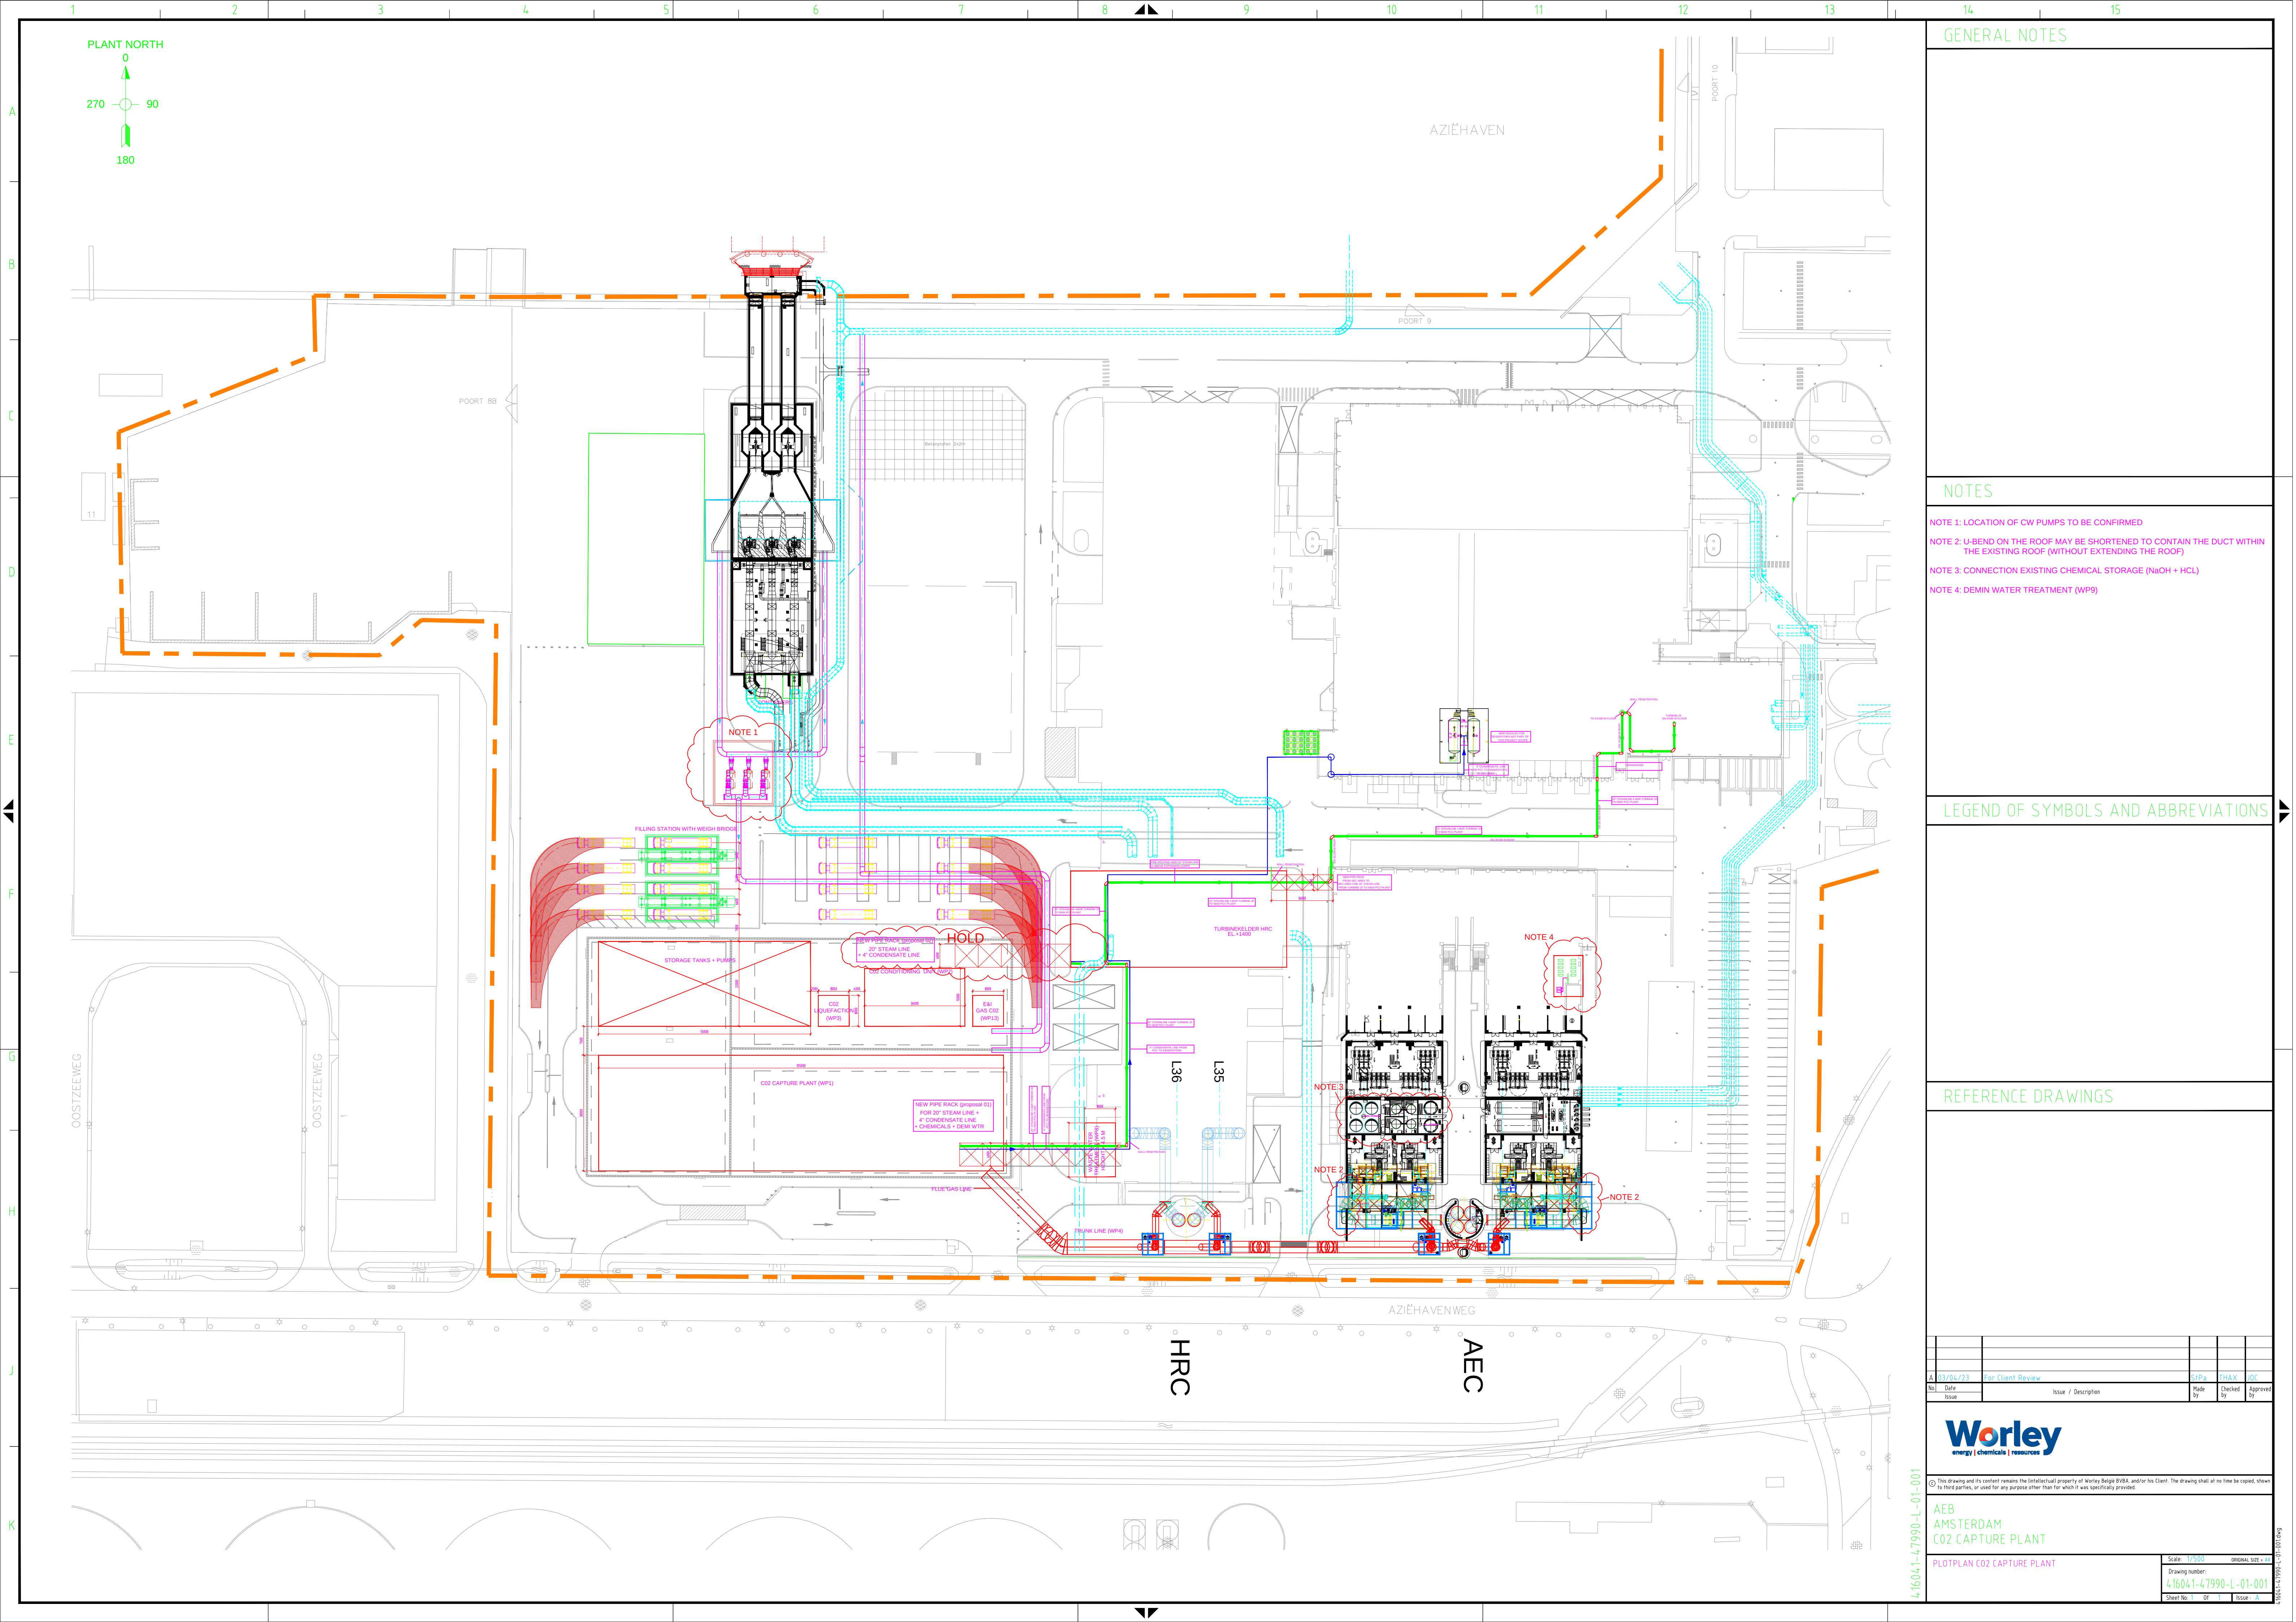

GENERAL NOTES

NOTES

- NOTE 1: LOCATION OF CW PUMPS TO BE CONFIRMED
- NOTE 2: U-BEND ON THE ROOF MAY BE SHORTENED TO CONTAIN THE DUCT WITHIN THE EXISTING ROOF (WITHOUT EXTENDING THE ROOF)
- NOTE 3: CONNECTION EXISTING CHEMICAL STORAGE (NaOH + HCL)
- NOTE 4: DEMIN WATER TREATMENT (WP9)

LEGEND OF SYMBOLS AND ABBREVIATIONS

REFERENCE DRAWINGS

No.	Date	Issue	Issue / Description	Drawn By	Checked By	Approved By
1	02/04/23		For Client Review	CLP	THAN	JRC



AEB
AMSTERDAM
CO2 CAPTURE PLANT

PLDTPLAN CO2 CAPTURE PLANT

Scale	1:7500	ORIGINAL SIZE	A0
Drawing number	4.1604.1-4.7990-L-01-001		
Sheet No.	01	Issue	01