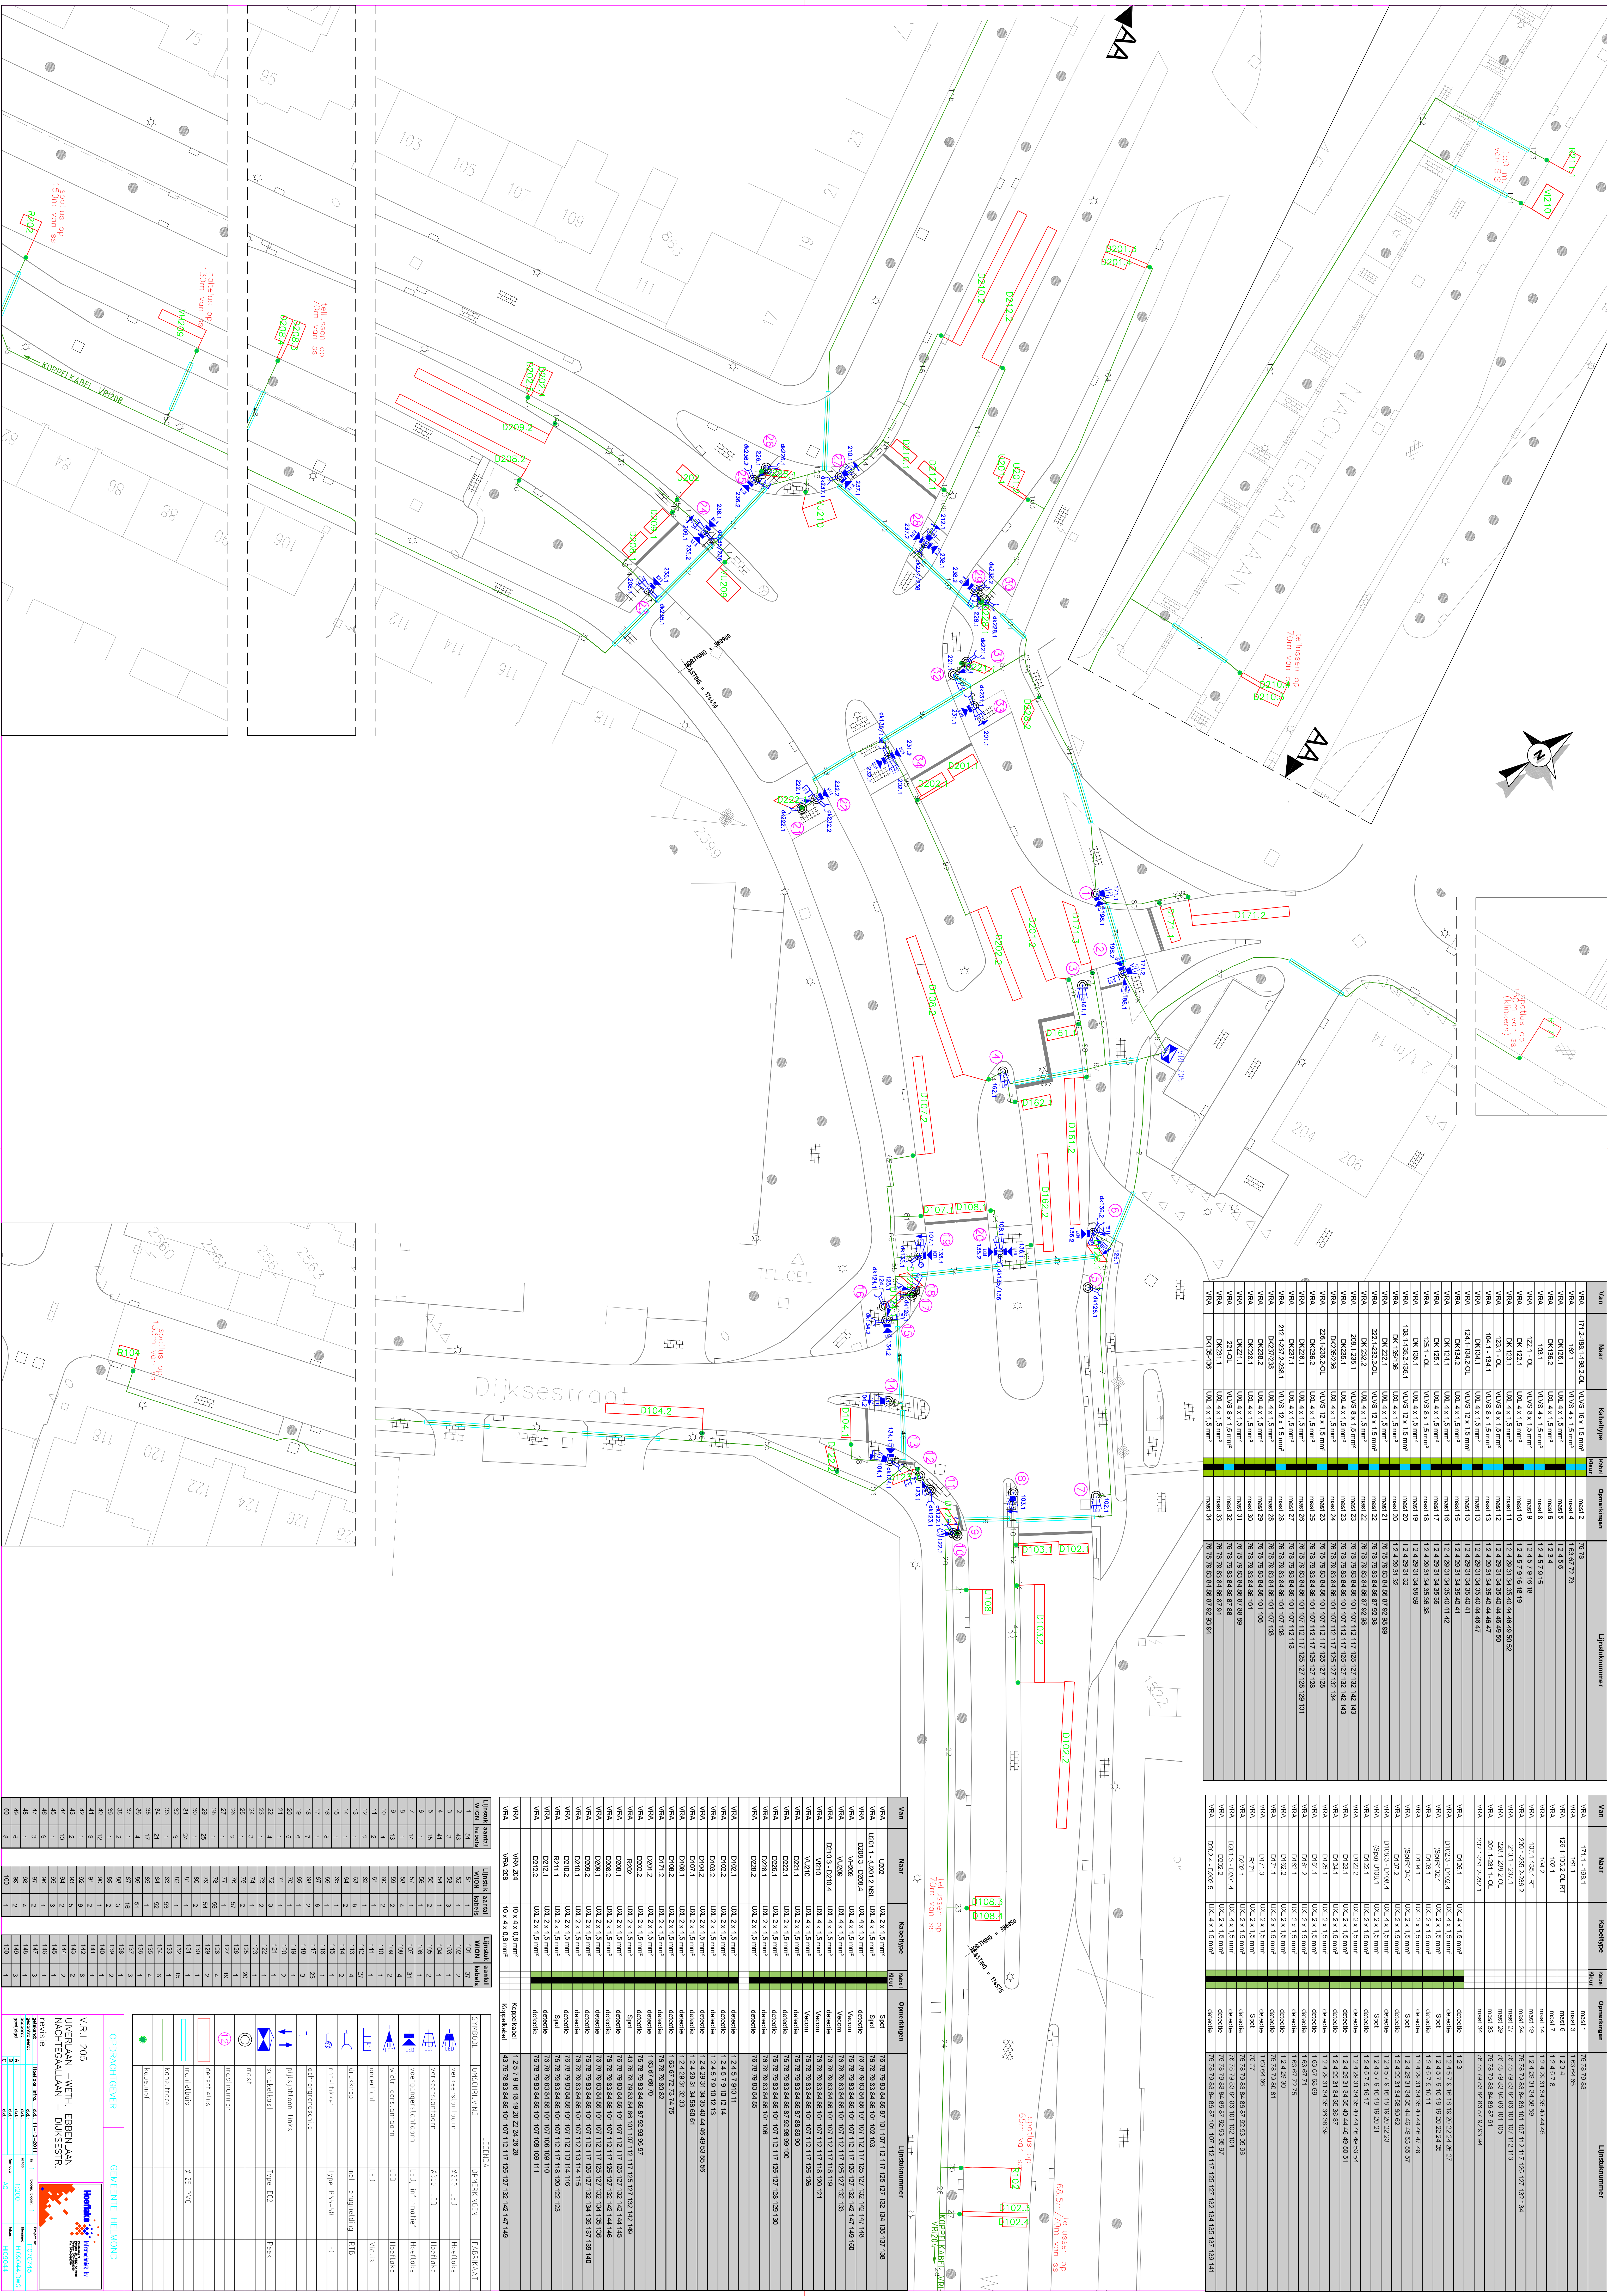


[illegible][illegible][illegible][illegible]