


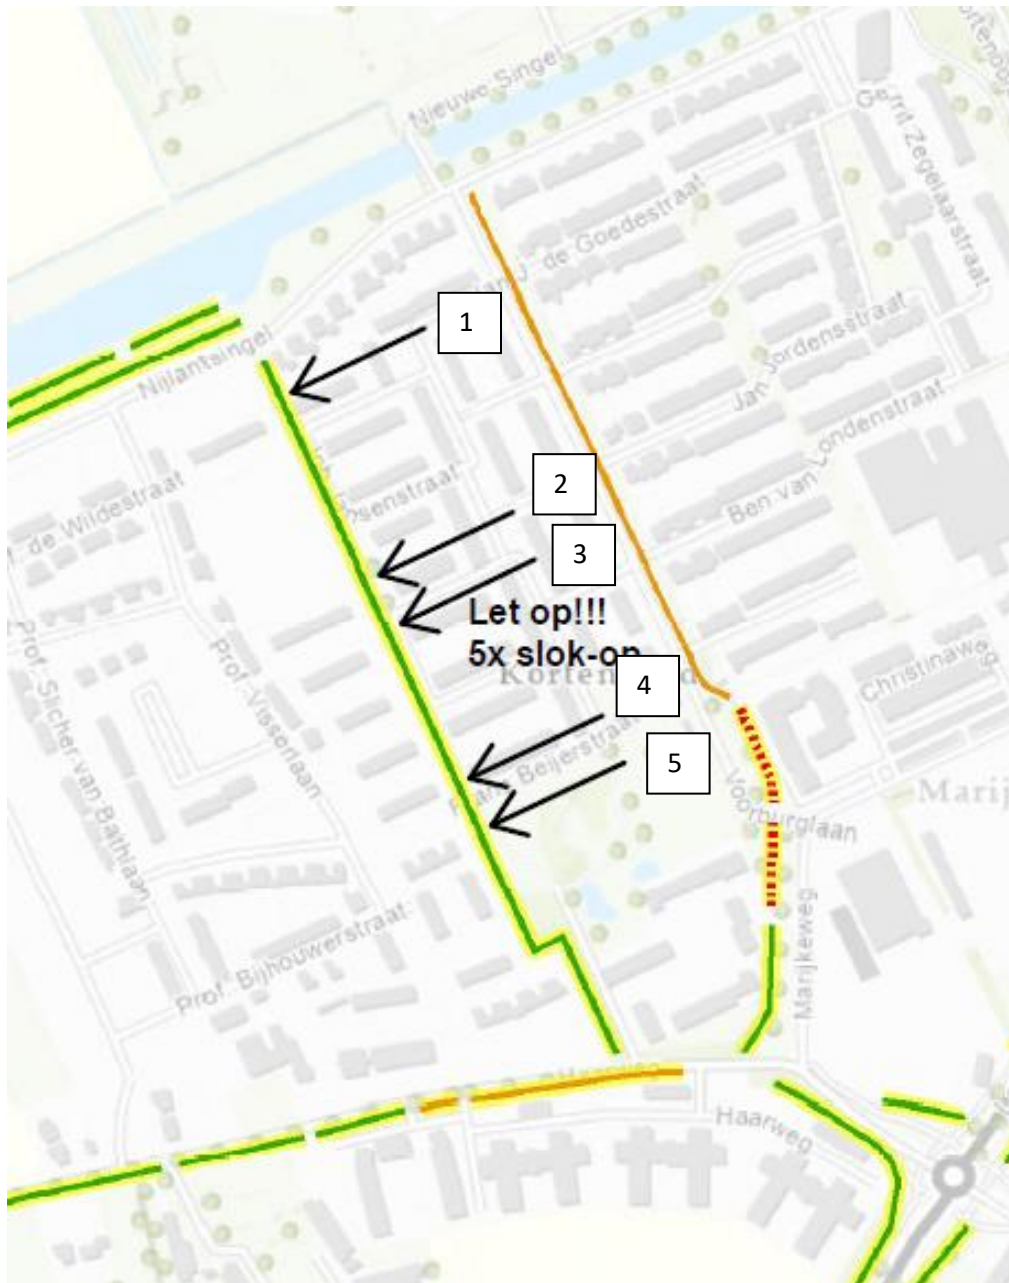

Num. 1= Slokop.

Num. 2= Rooster in de bodem.

Num. 3= Rooster in de bodem.

Num. 4= Rooster in de bodem.

Num. 5= Slokop.