


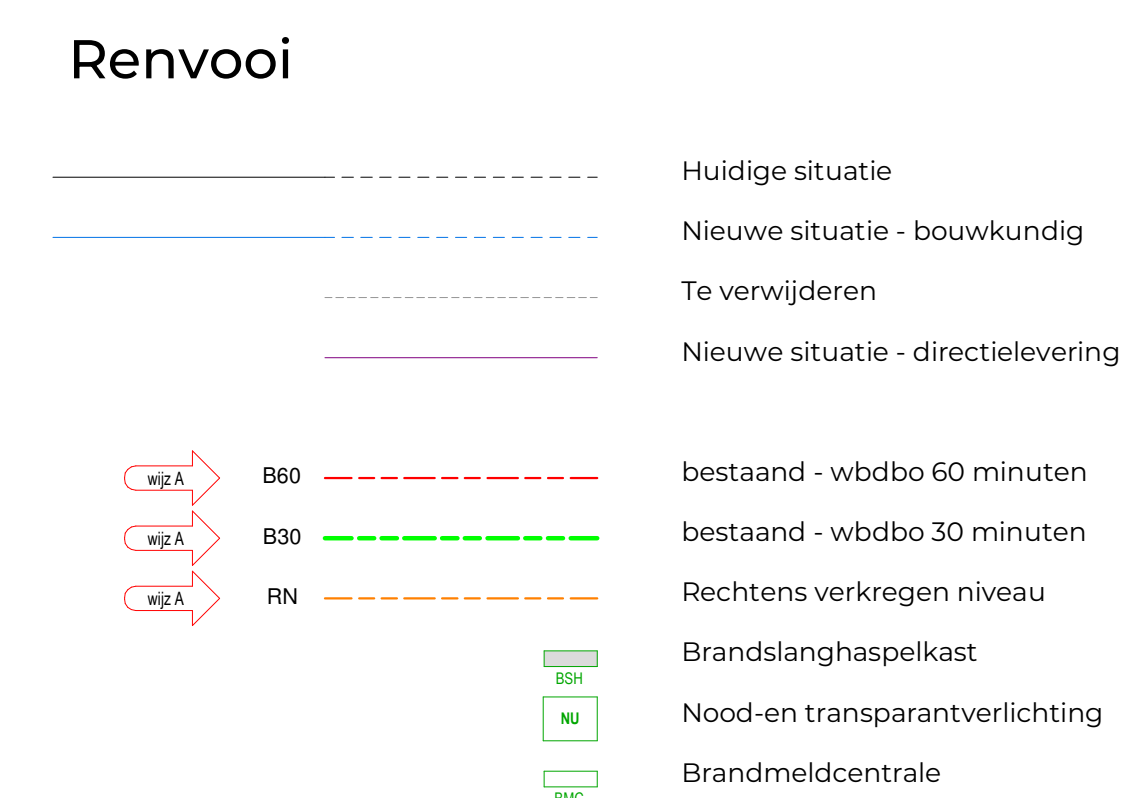

Datum
5 april 2024
13 mei 2024 - wijz A