


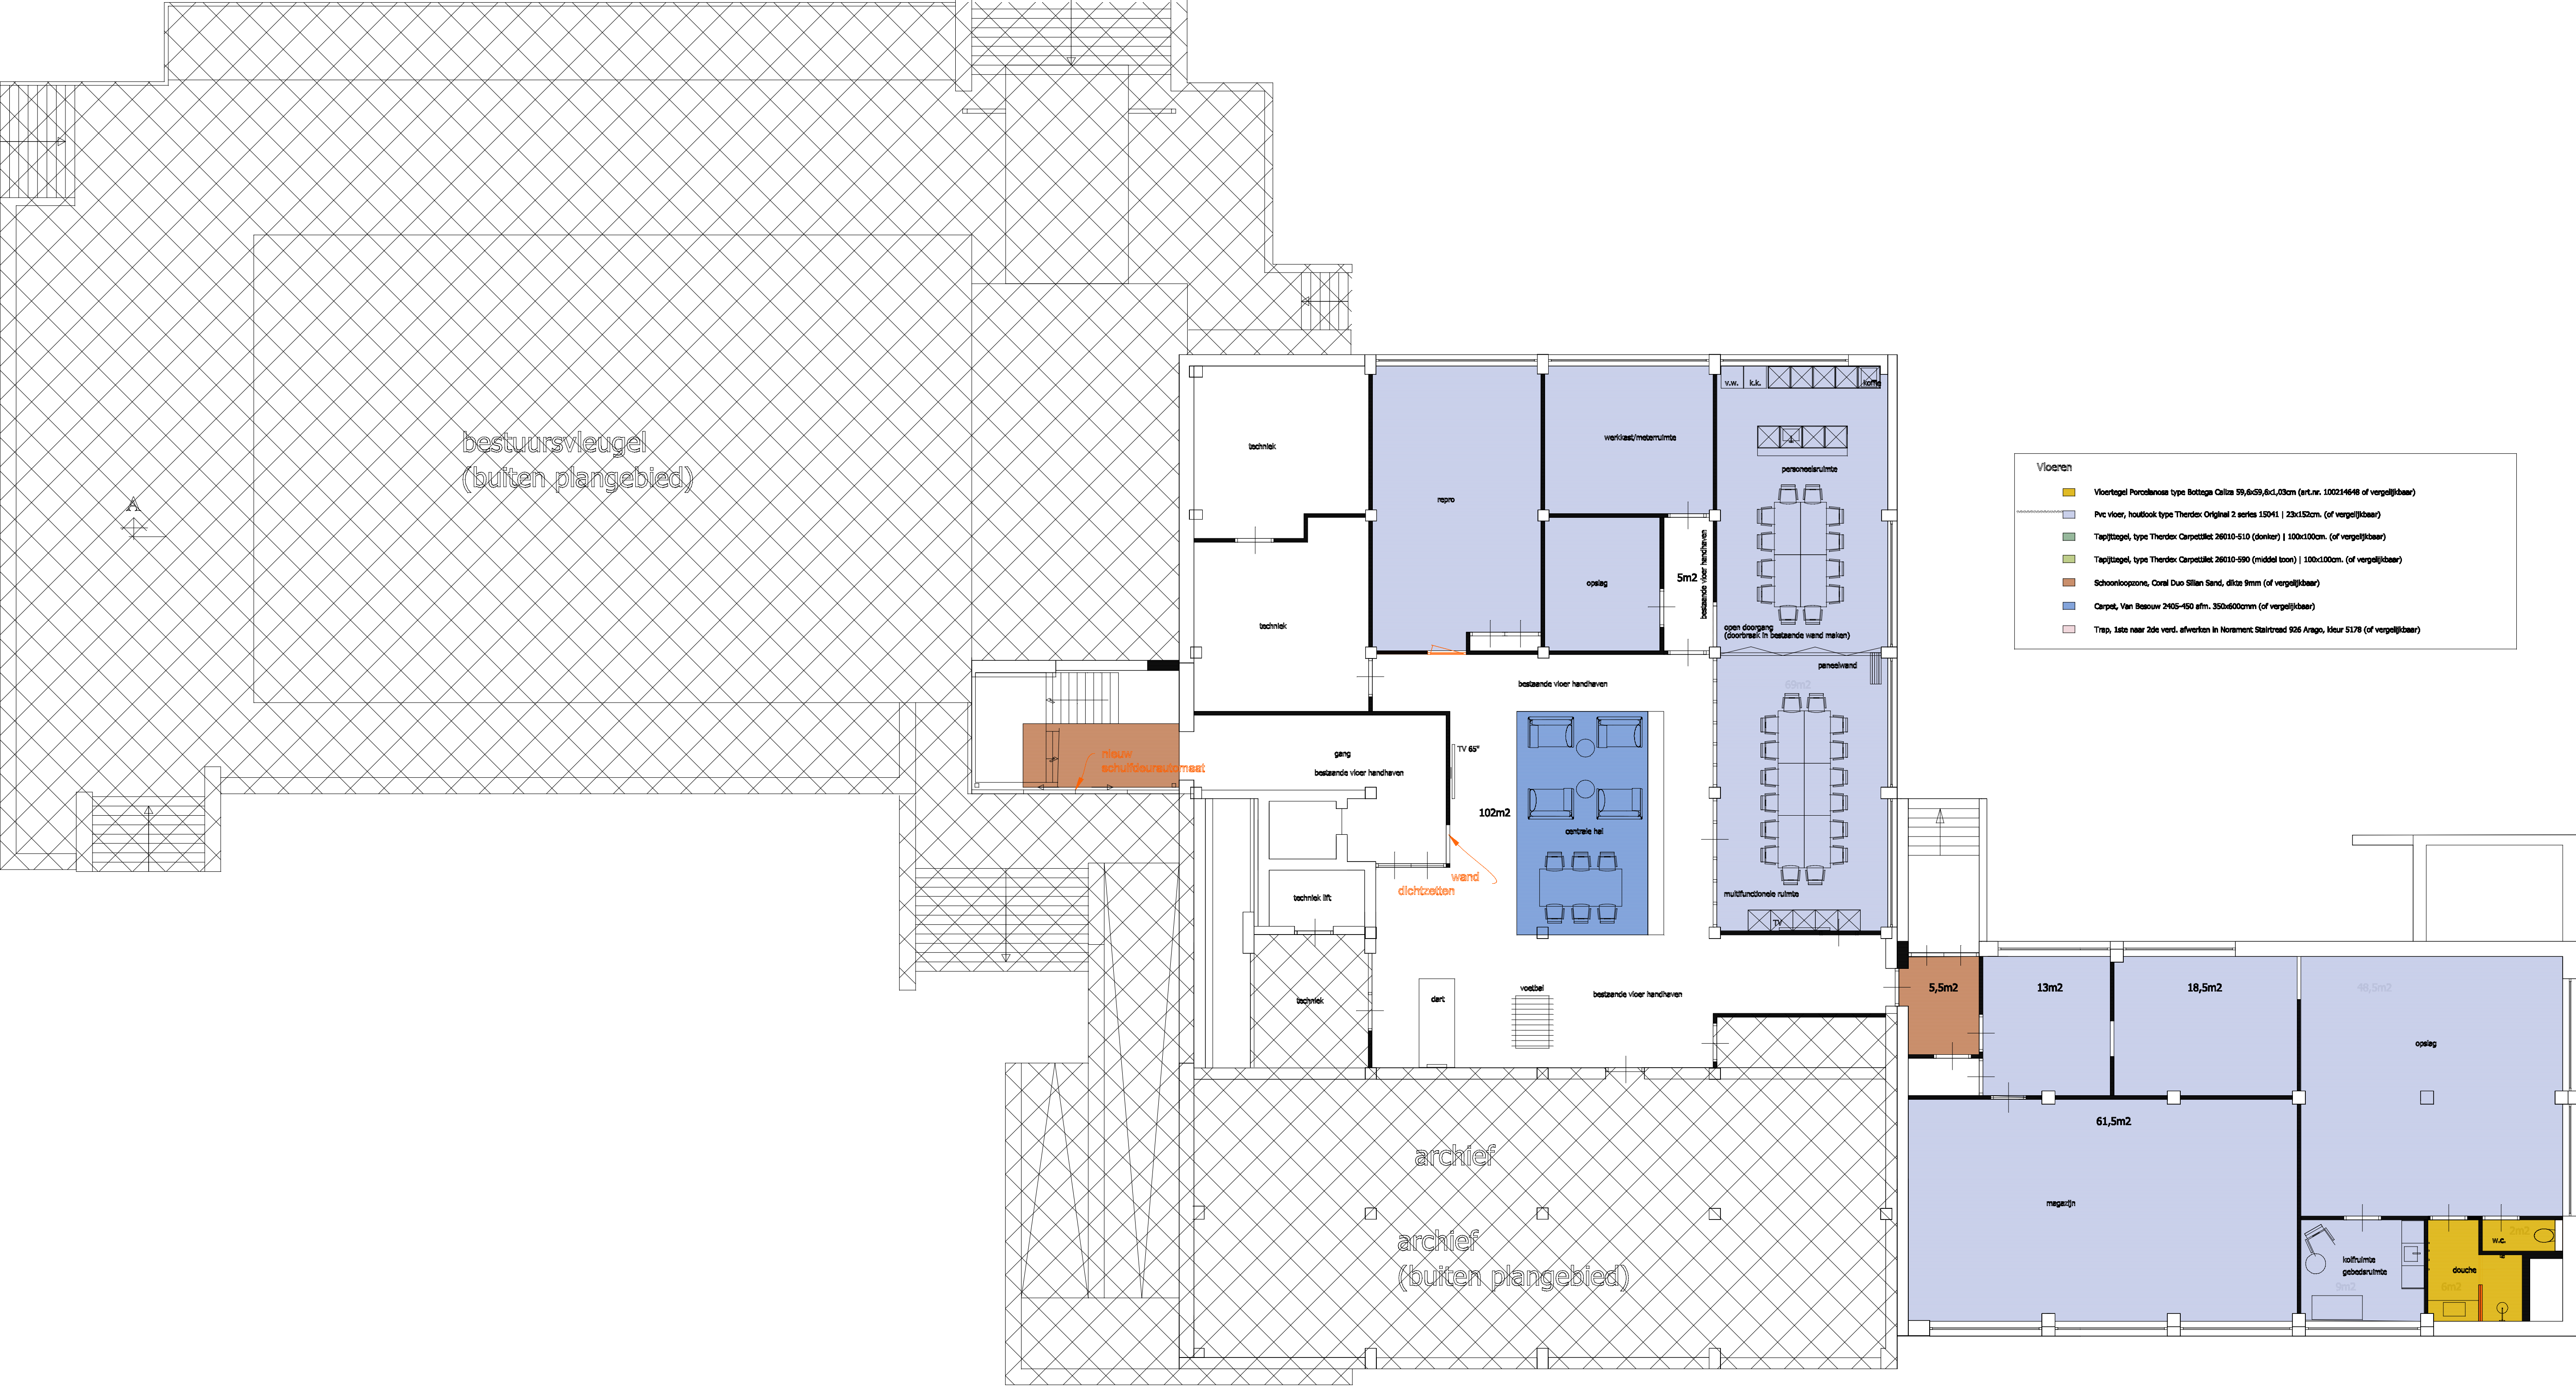

-SOUTERRAIN -