


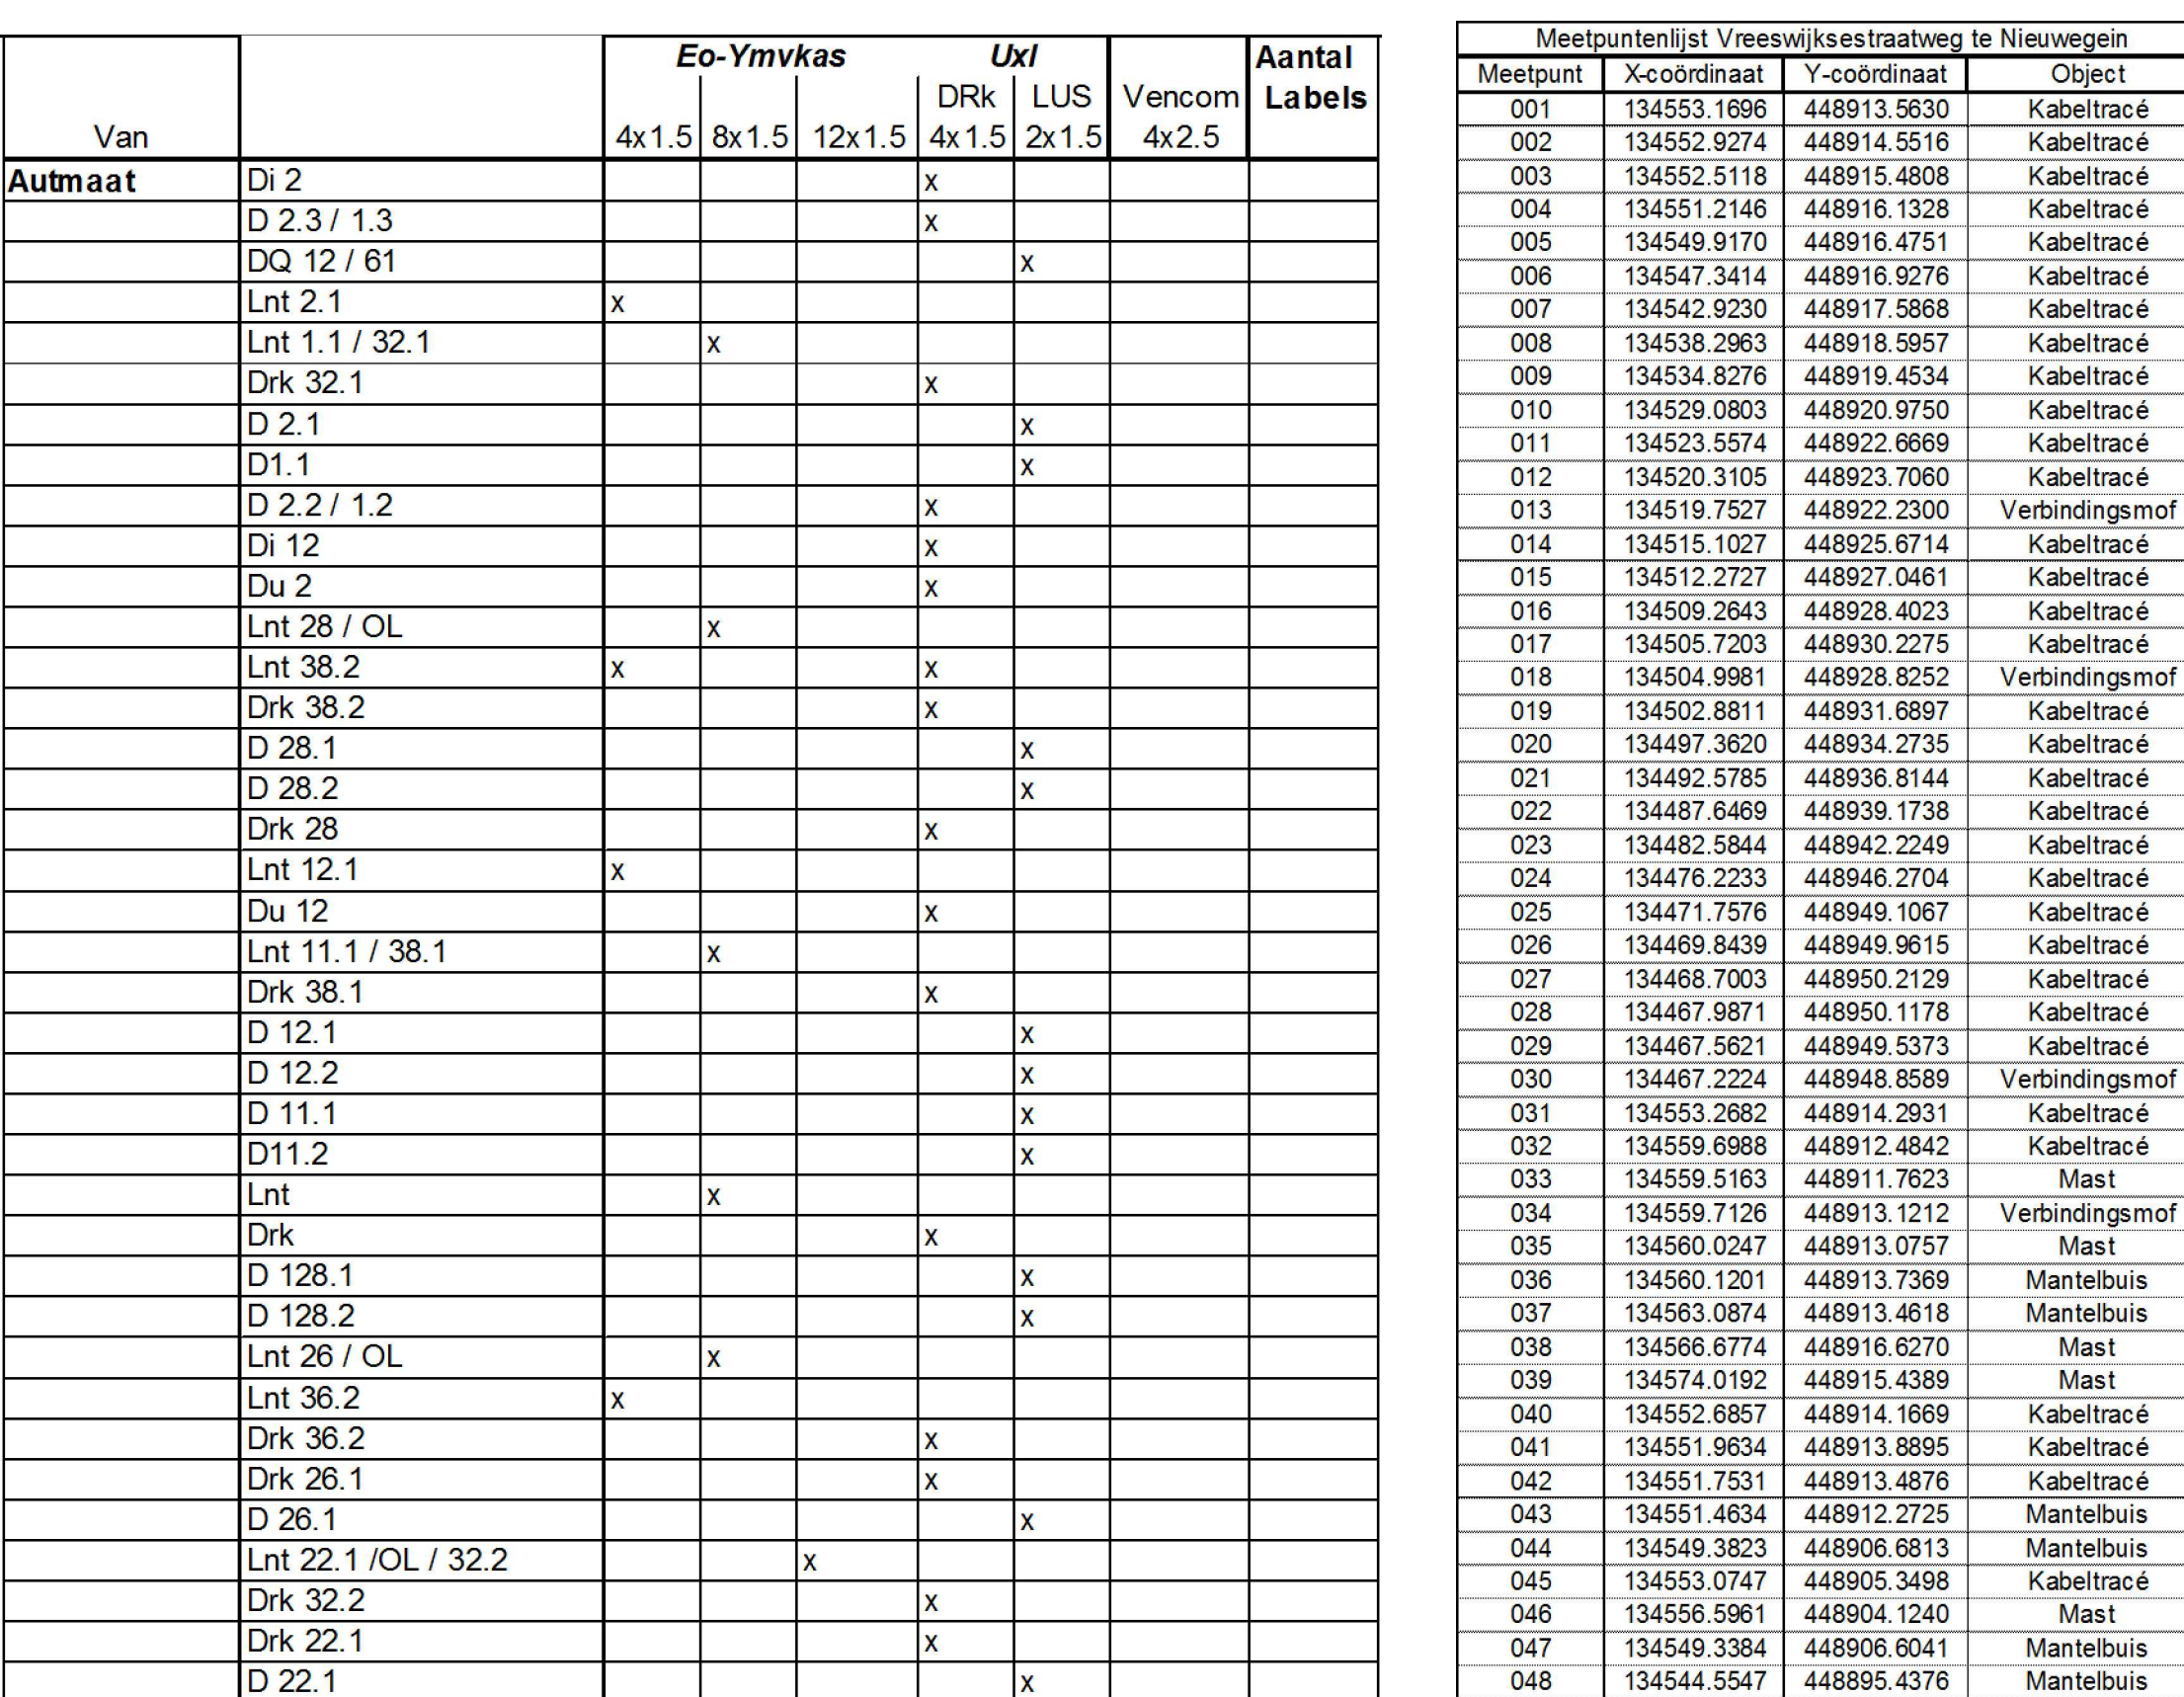

Van		Eo-Yvmvaks				Uxi		Vencom 4x2,5	Aantal Labels
		4x1,5	8x1,5	12x1,5	DRK 4x1,5	US 2x1,5			
Autmaat	Di 2				x				
	D 2,3 / 1,3				x				
	DO 12 / 61					x			
	Lnt 2,1	x							
	Lnt 1,1 / 32,1		x						
	DRK 32,1								
	D 2,1				x	x			
	D1,1						x		
	D 2,2 / 1,2				x				
	Di 12								
	Du 2								
	Lnt 28 / OL		x						
	Lnt 38,2		x						
	DRK 38,2				x	x			
	D 28,1								
	D 28,2						x		
	DRK 28,2								
	Lnt 12,1		x						
	Du 12								
	Lnt 11,1 / 38,1		x						
	DRK 38,1								
	D 12,1					x			
	D 11,2						x		
	D 12,2								
	D 12,1								
	Lnt		x						
	DRK					x			
	D 128,1								
	D 128,2								
	DRK 32,2					x			
	DRK 22,1						x		
	D 22,1								


LEGENDA	
	Kabeltracé
	Verbindingsmof
	Mantelbuis
	Verkeerslichtmast
000.0.0 	Massaluis
05000.0 	Selectieve luis
010.0.0 	Netwerk tellus inmelden
000.0.0 	Netwerk tellus uitmelden
	Meetpunt
	Kost verkeersregaltoestel met plaats deur
	Ingemeten topo