


WW1-1302-1 R

+ 7200

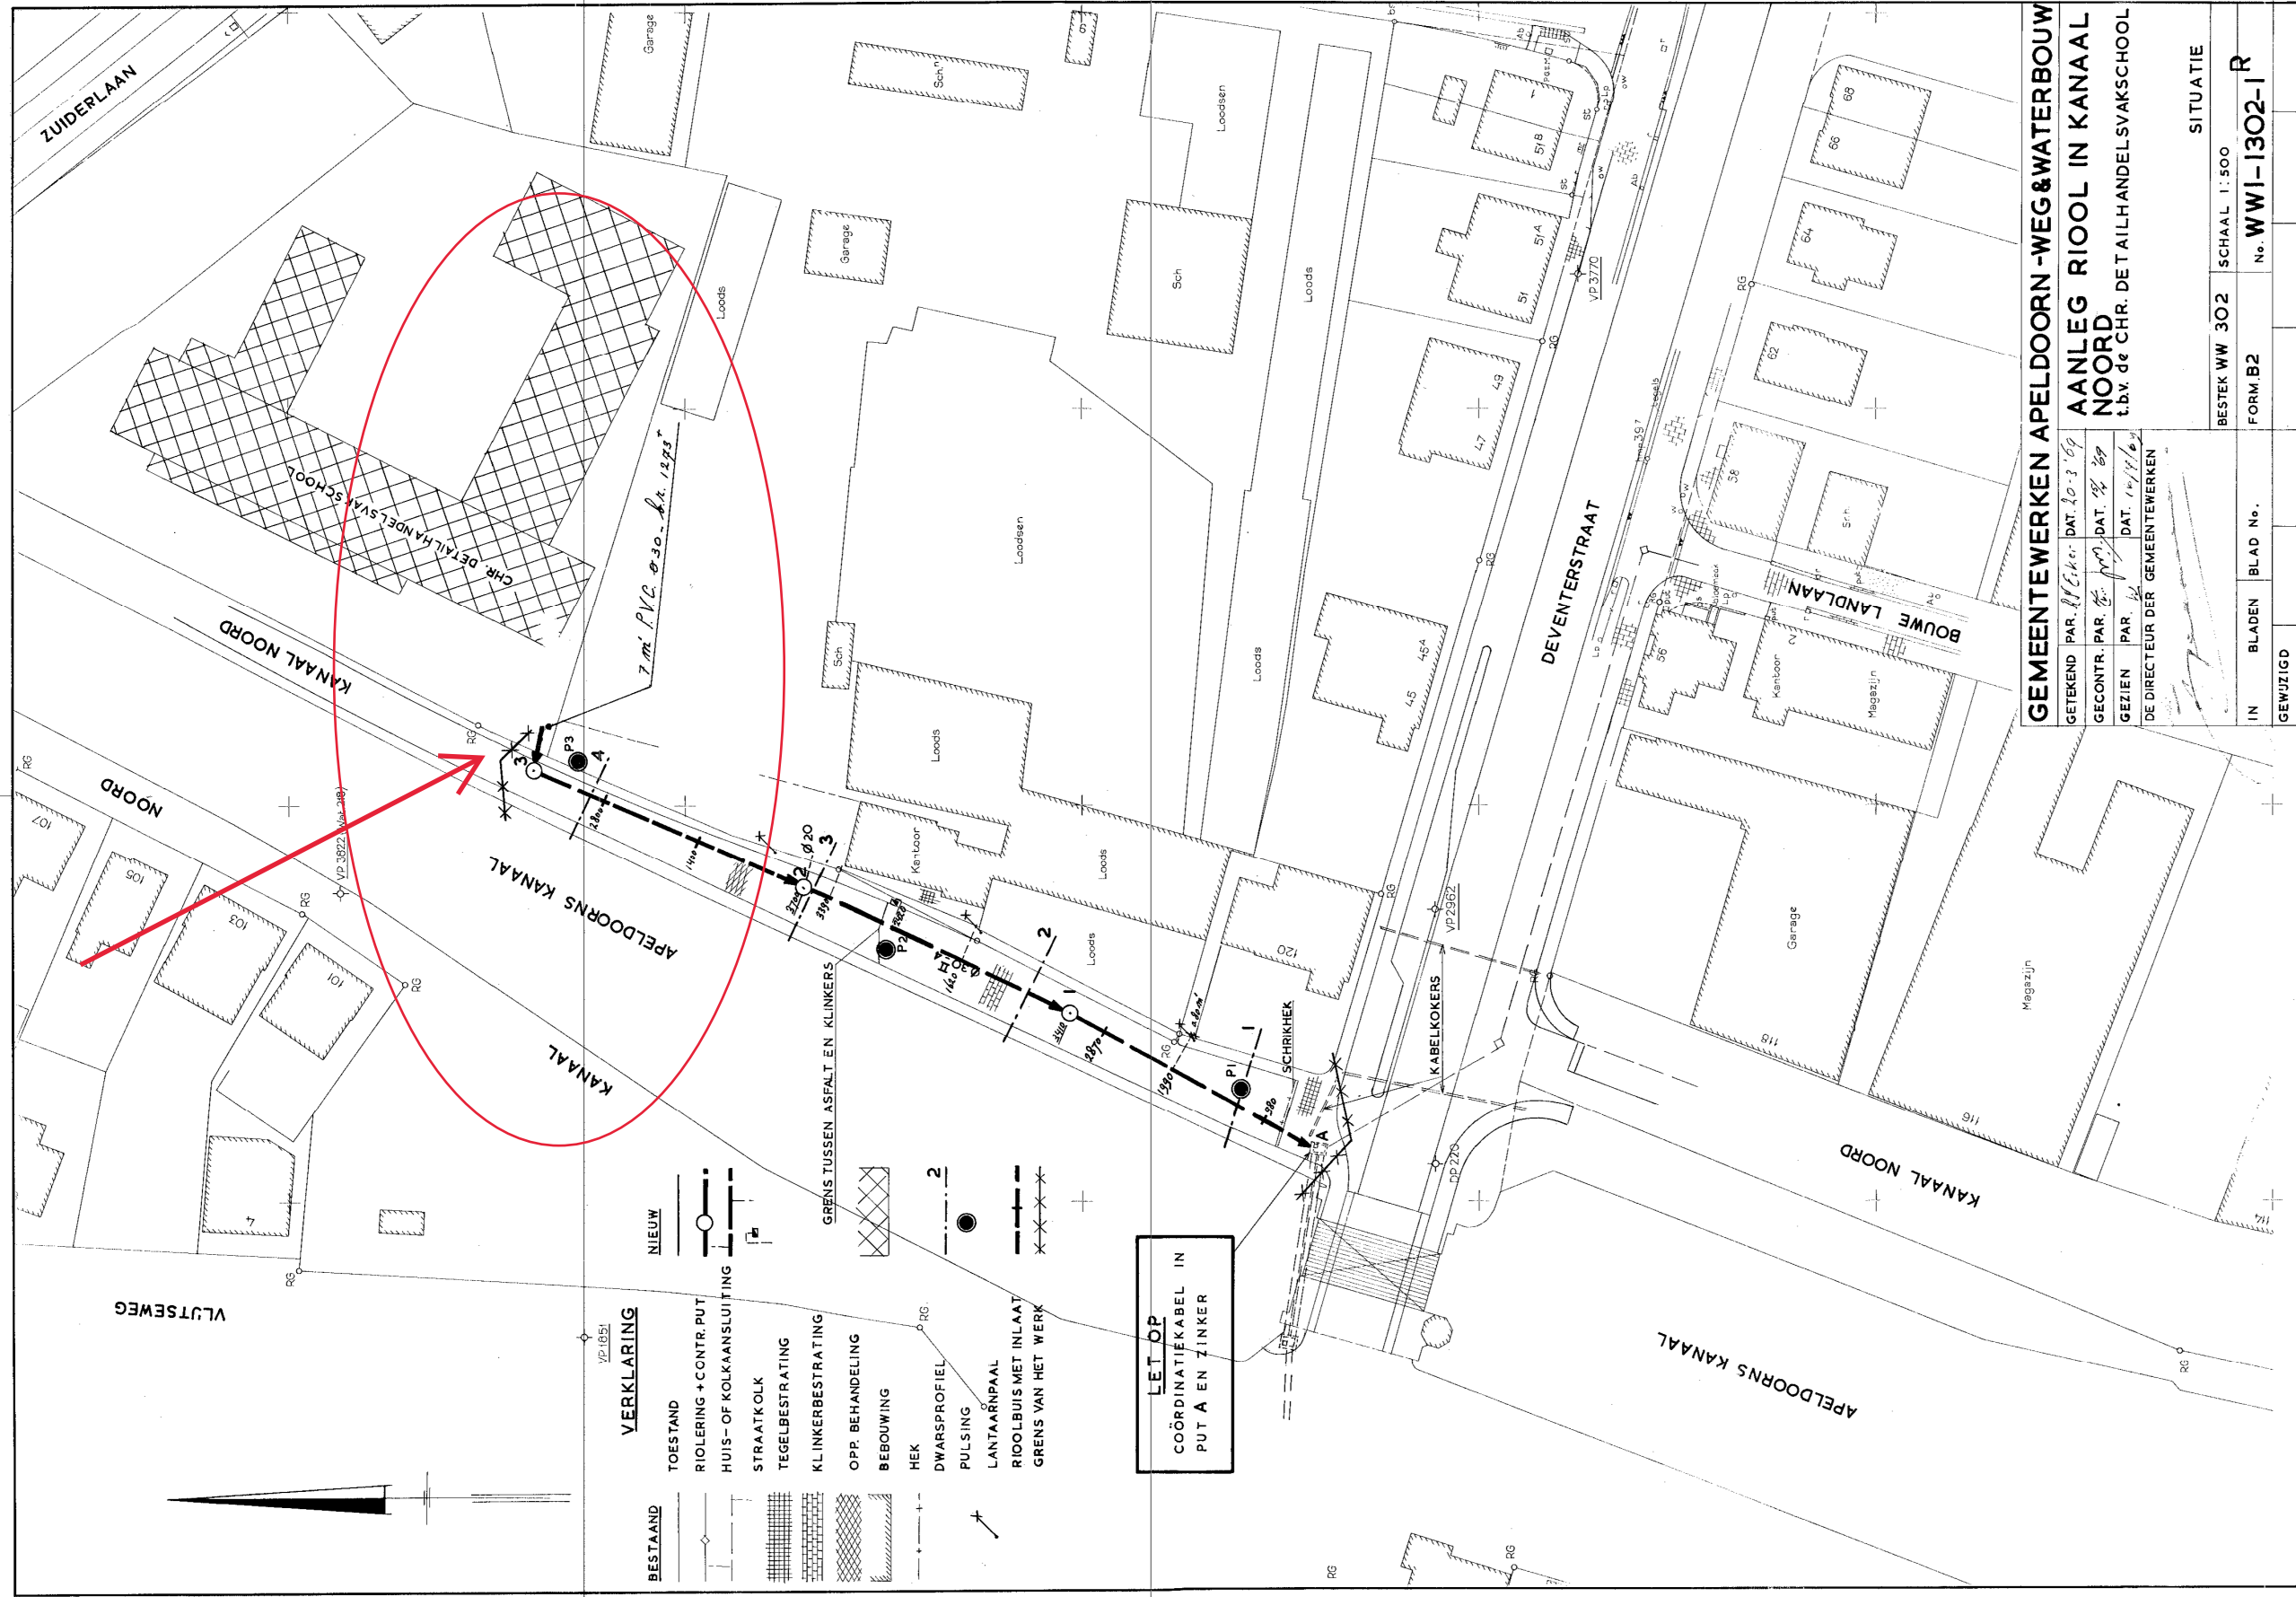

0214 0038