
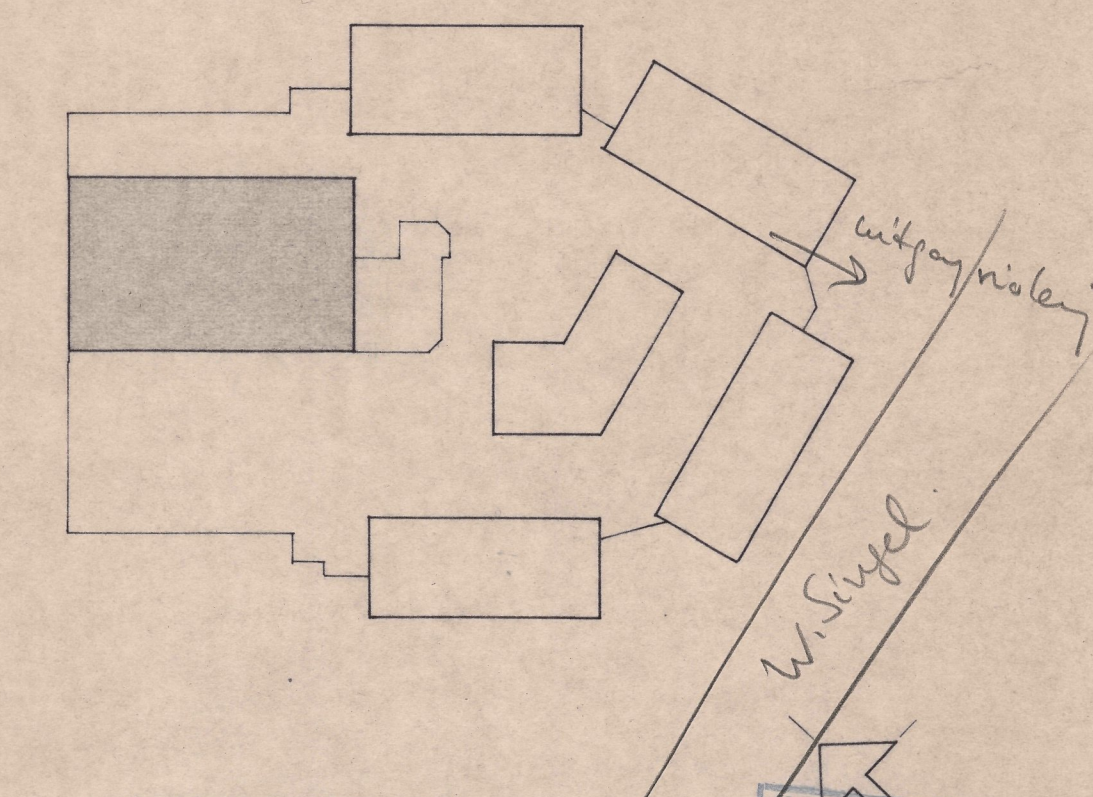


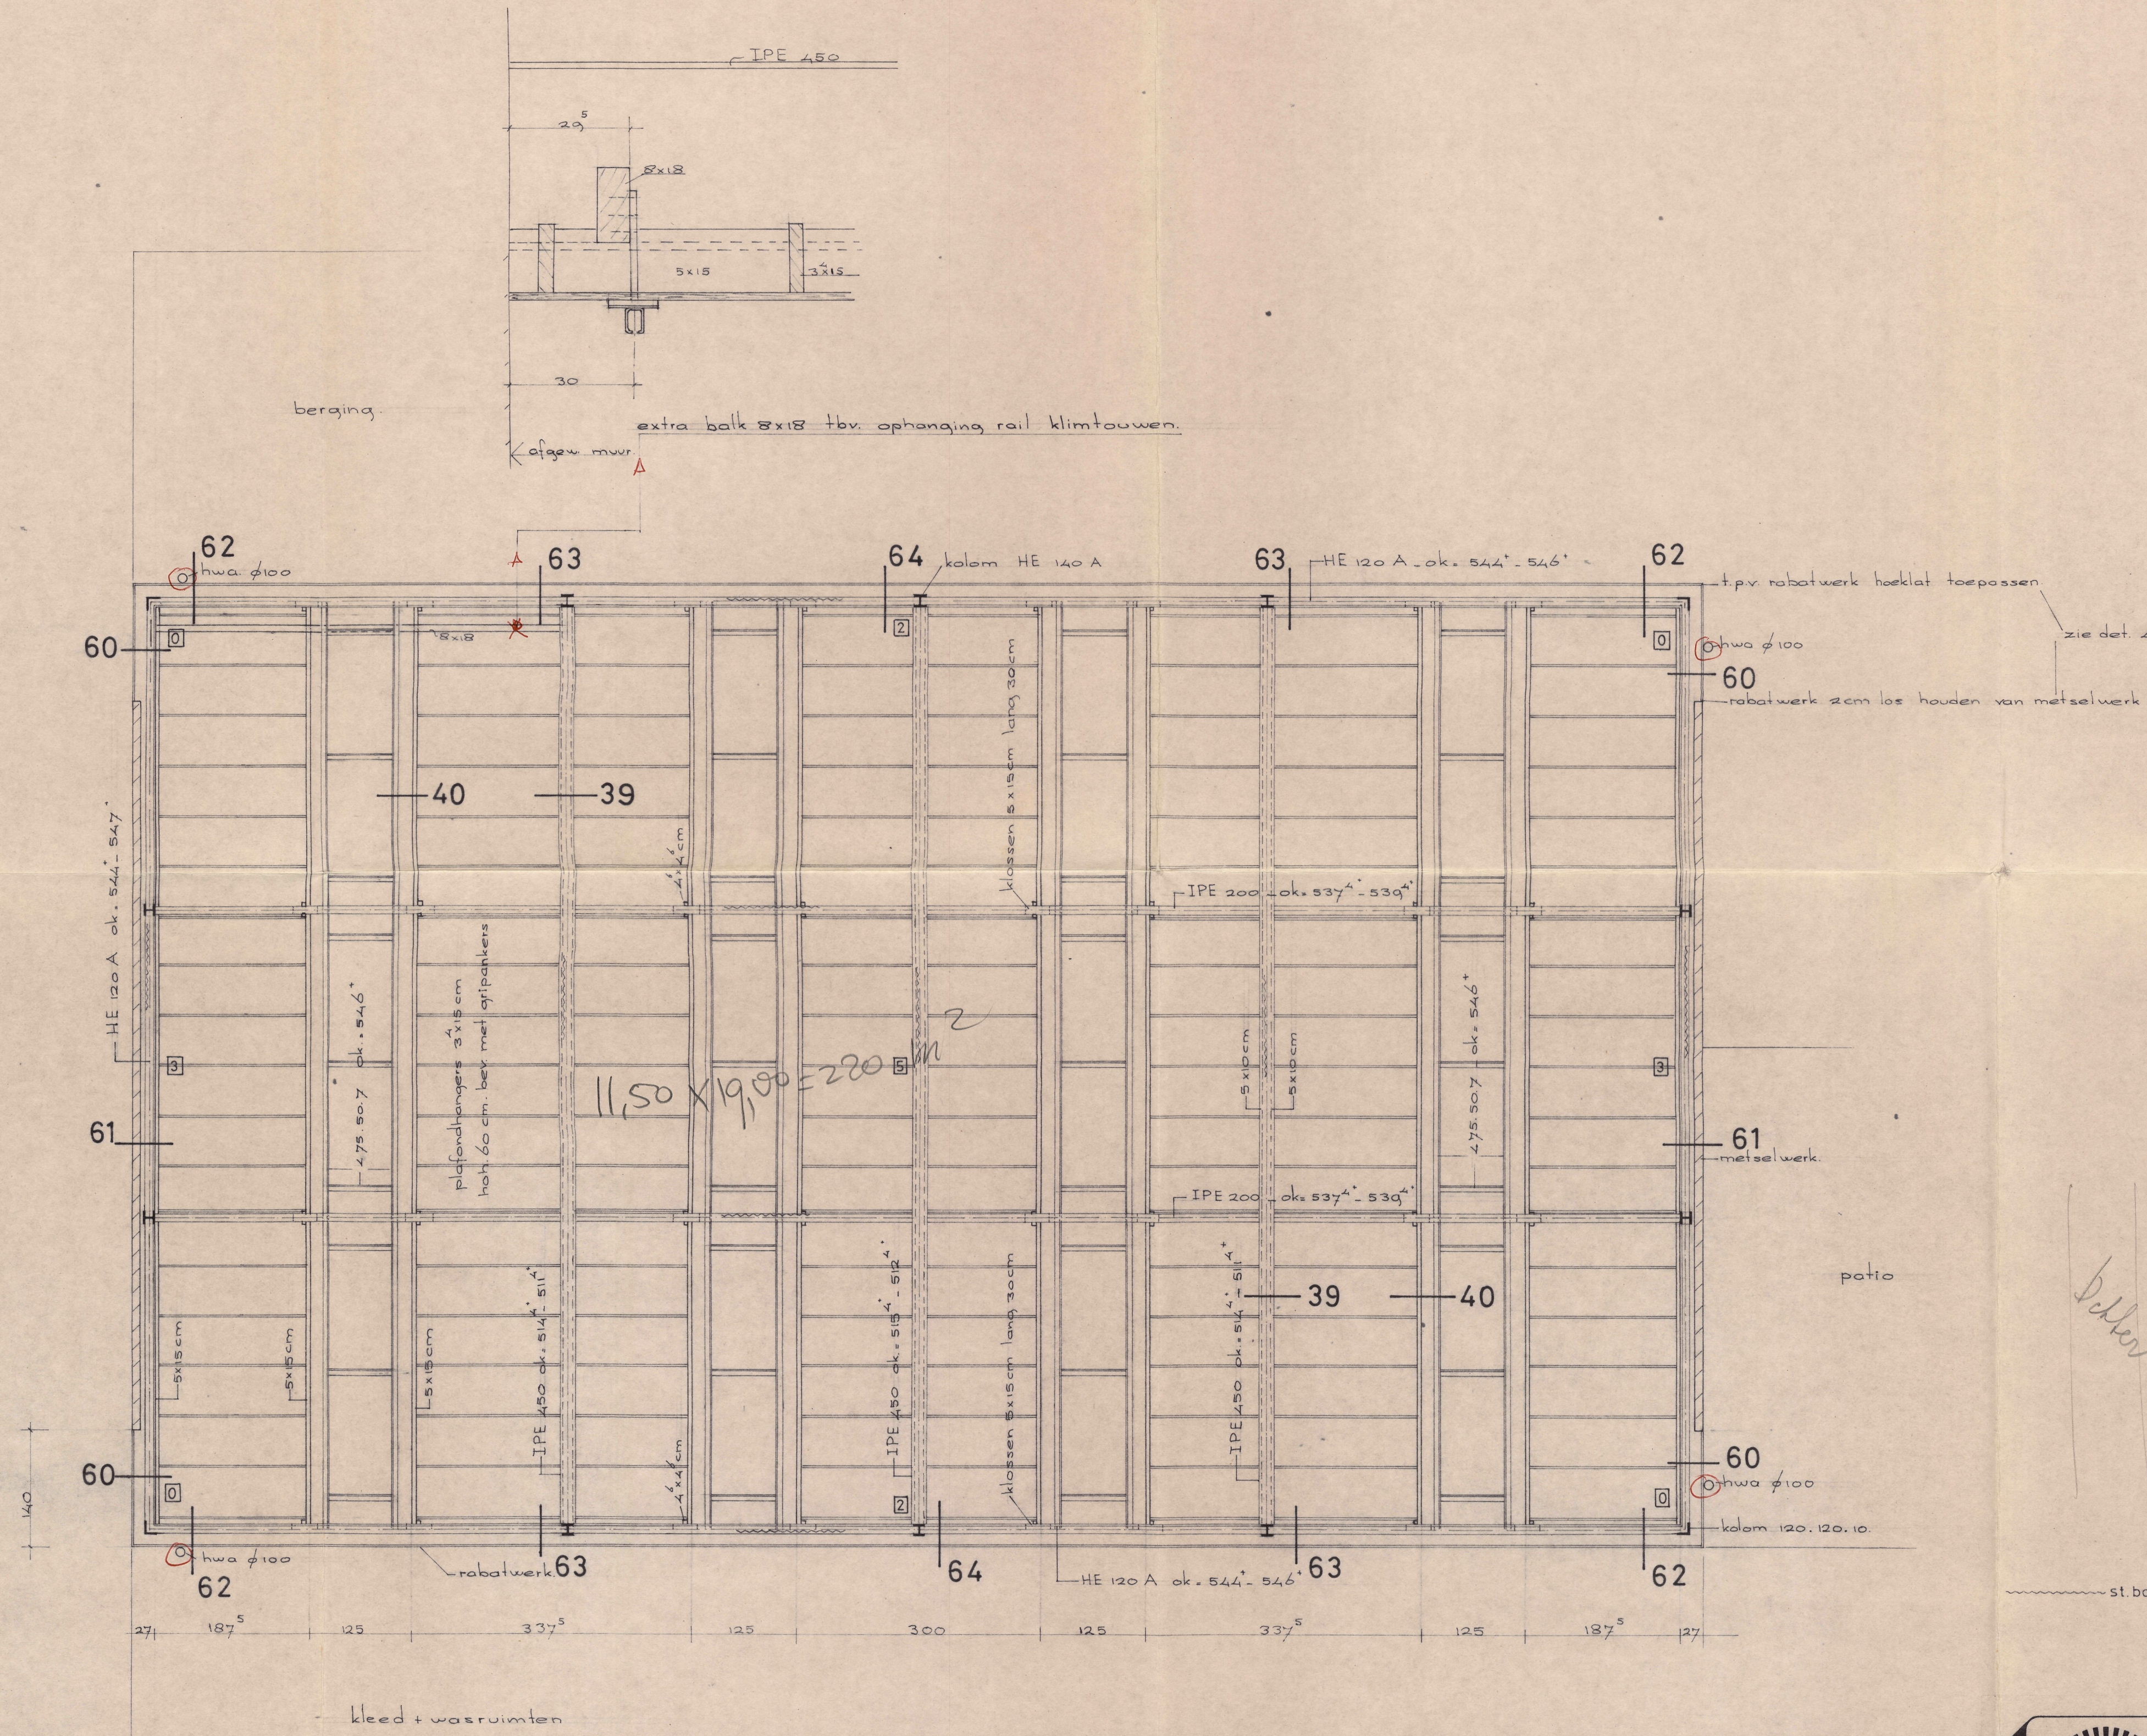

Technisch Bureau In de Krimpdenwaard
Ingek. 20 JAN. 1981