


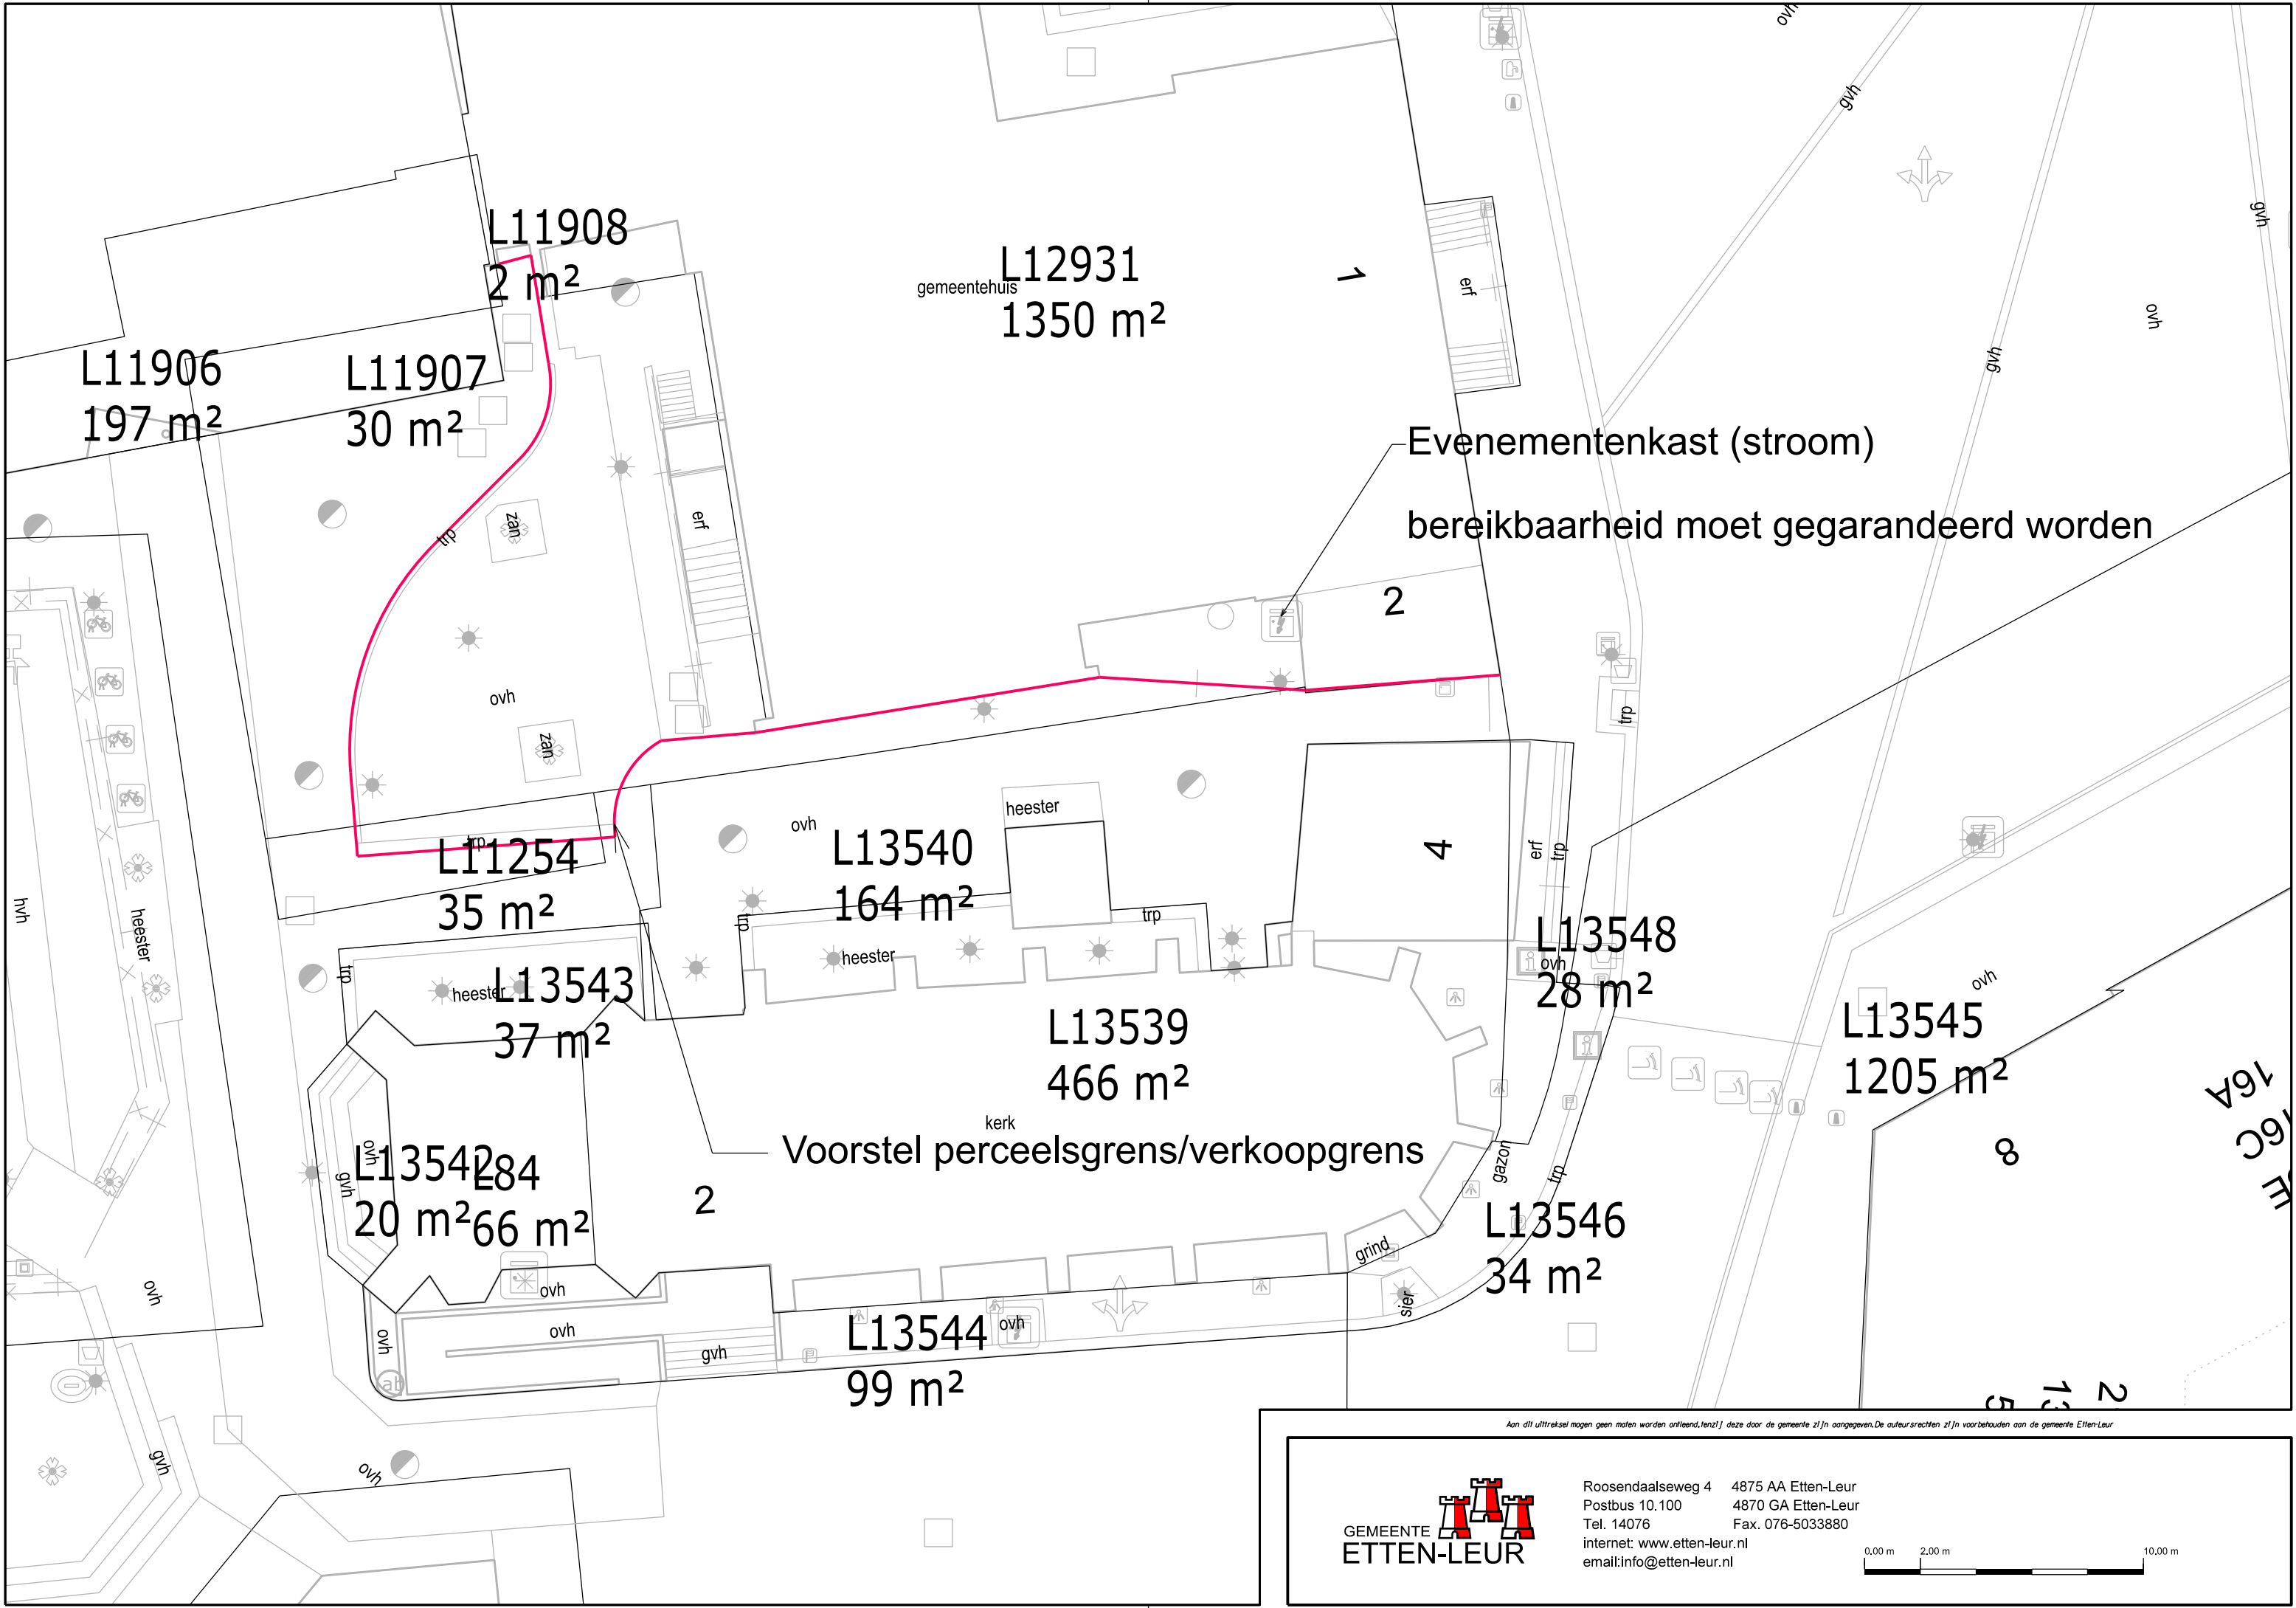

L11908
2 m²

L11906
197 m²

L11907
30 m²

gemeentehuis
L12931
1350 m²

Evenementenkast (stroom)
bereikbaarheid moet gegarandeerd worden

L11254
35 m²

L13540
164 m²

L13548
28 m²

L13545
1205 m²

L13543
37 m²

L13539
466 m²

L13542
20 m²

L13541
66 m²

Voorstel perceelsgrens/verkoopgrens

L13546
34 m²

L13544
99 m²



Roosendaalseweg 4 4875 AA Etten-Leur
Postbus 10.100 4870 GA Etten-Leur
Tel. 14076 Fax. 076-5033880
internet: www.etten-leur.nl
email: info@etten-leur.nl

