

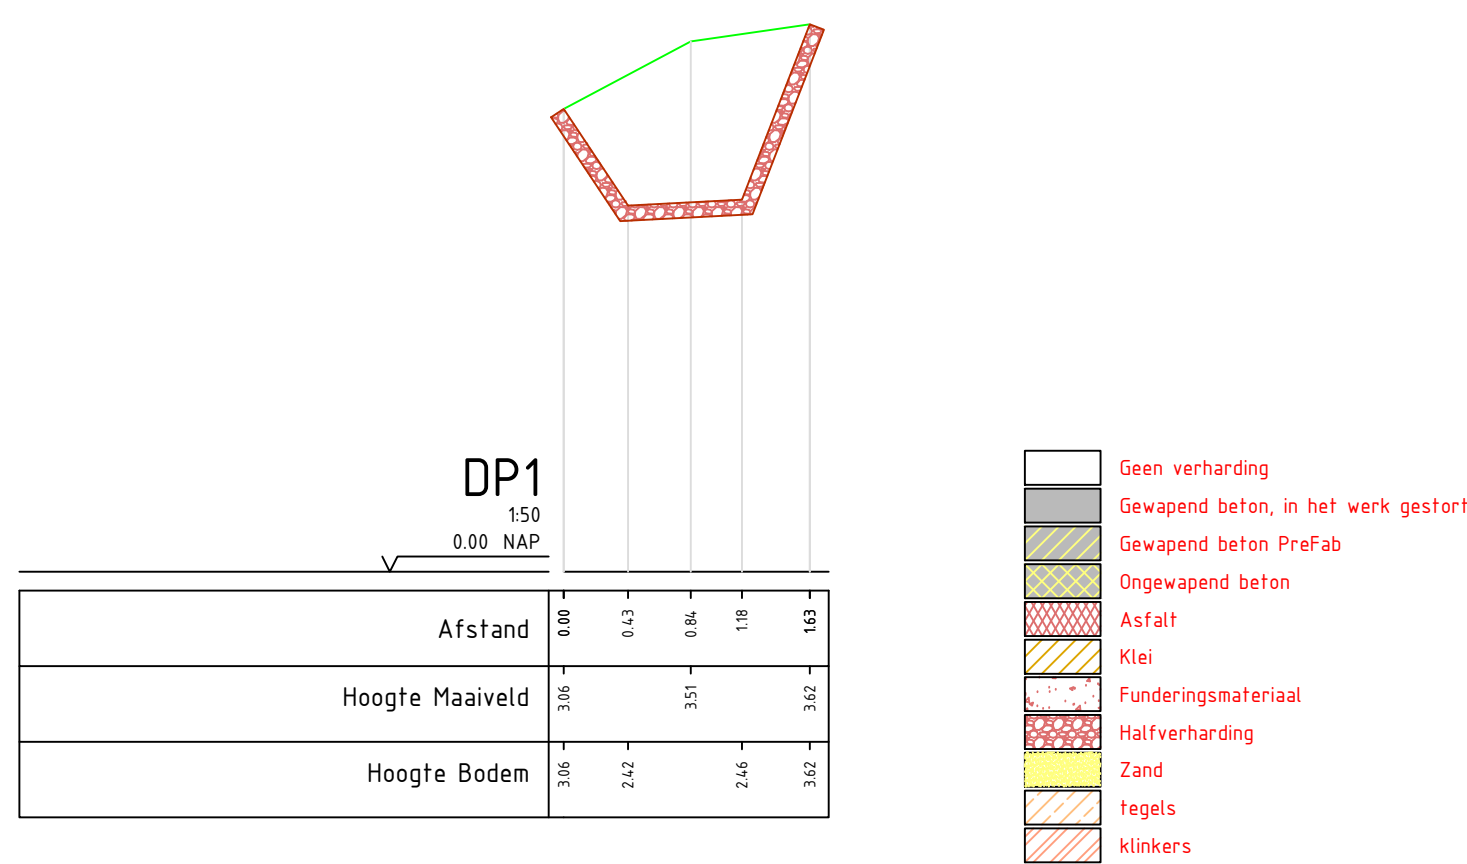


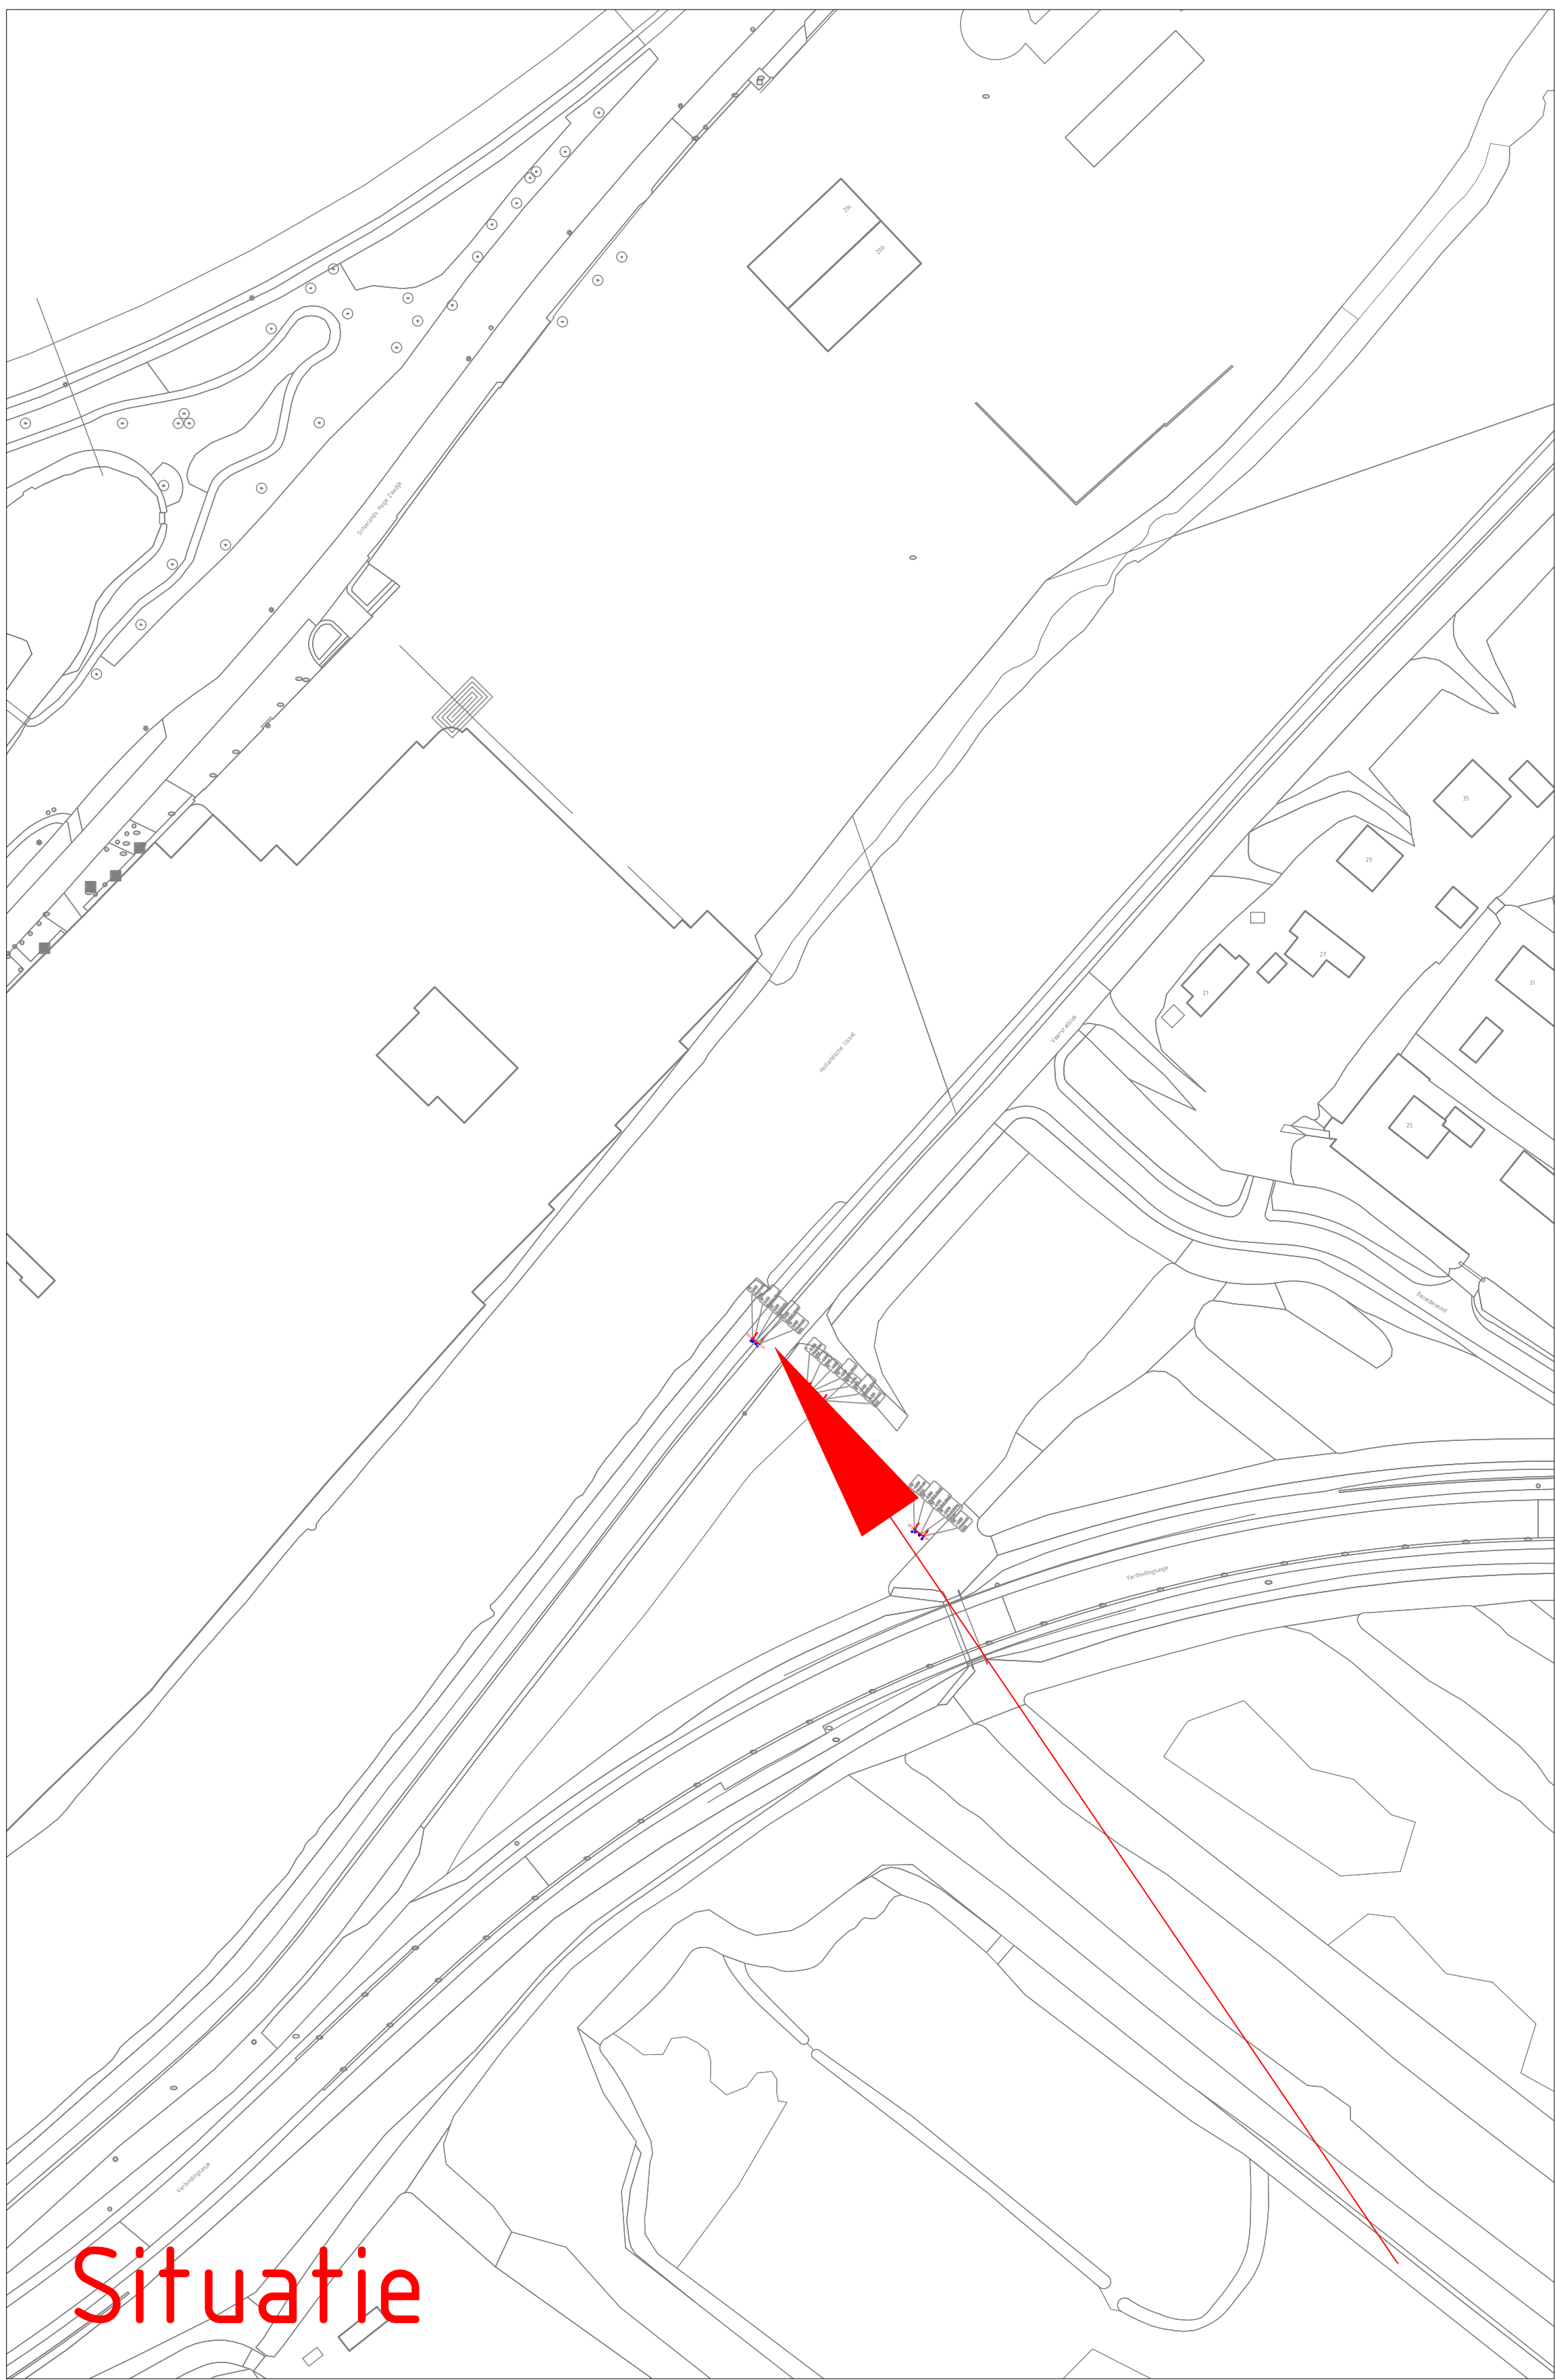

Puntnummer	X Coördinaat	Y Coördinaat	Z Coördinaat	Layer	Omschrijving
14	108066.198	445846.731	3.622	137	PS1
15	108066.568	445847.187	3.620	137	PS1
16	108065.303	445848.211	3.060	137	PS1
17	108064.981	445847.799	3.067	137	PS1
18	108065.355	445847.645	2.445	137	BODEM
19	108065.557	445847.849	2.421	137	BODEM
20	108065.904	445847.233	2.616	137	BODEM
21	108066.137	445847.388	2.460	137	BODEM
22	108065.995	445847.731	3.507	137	KADEPUIN

Dwarsprofiel schaal 1:50

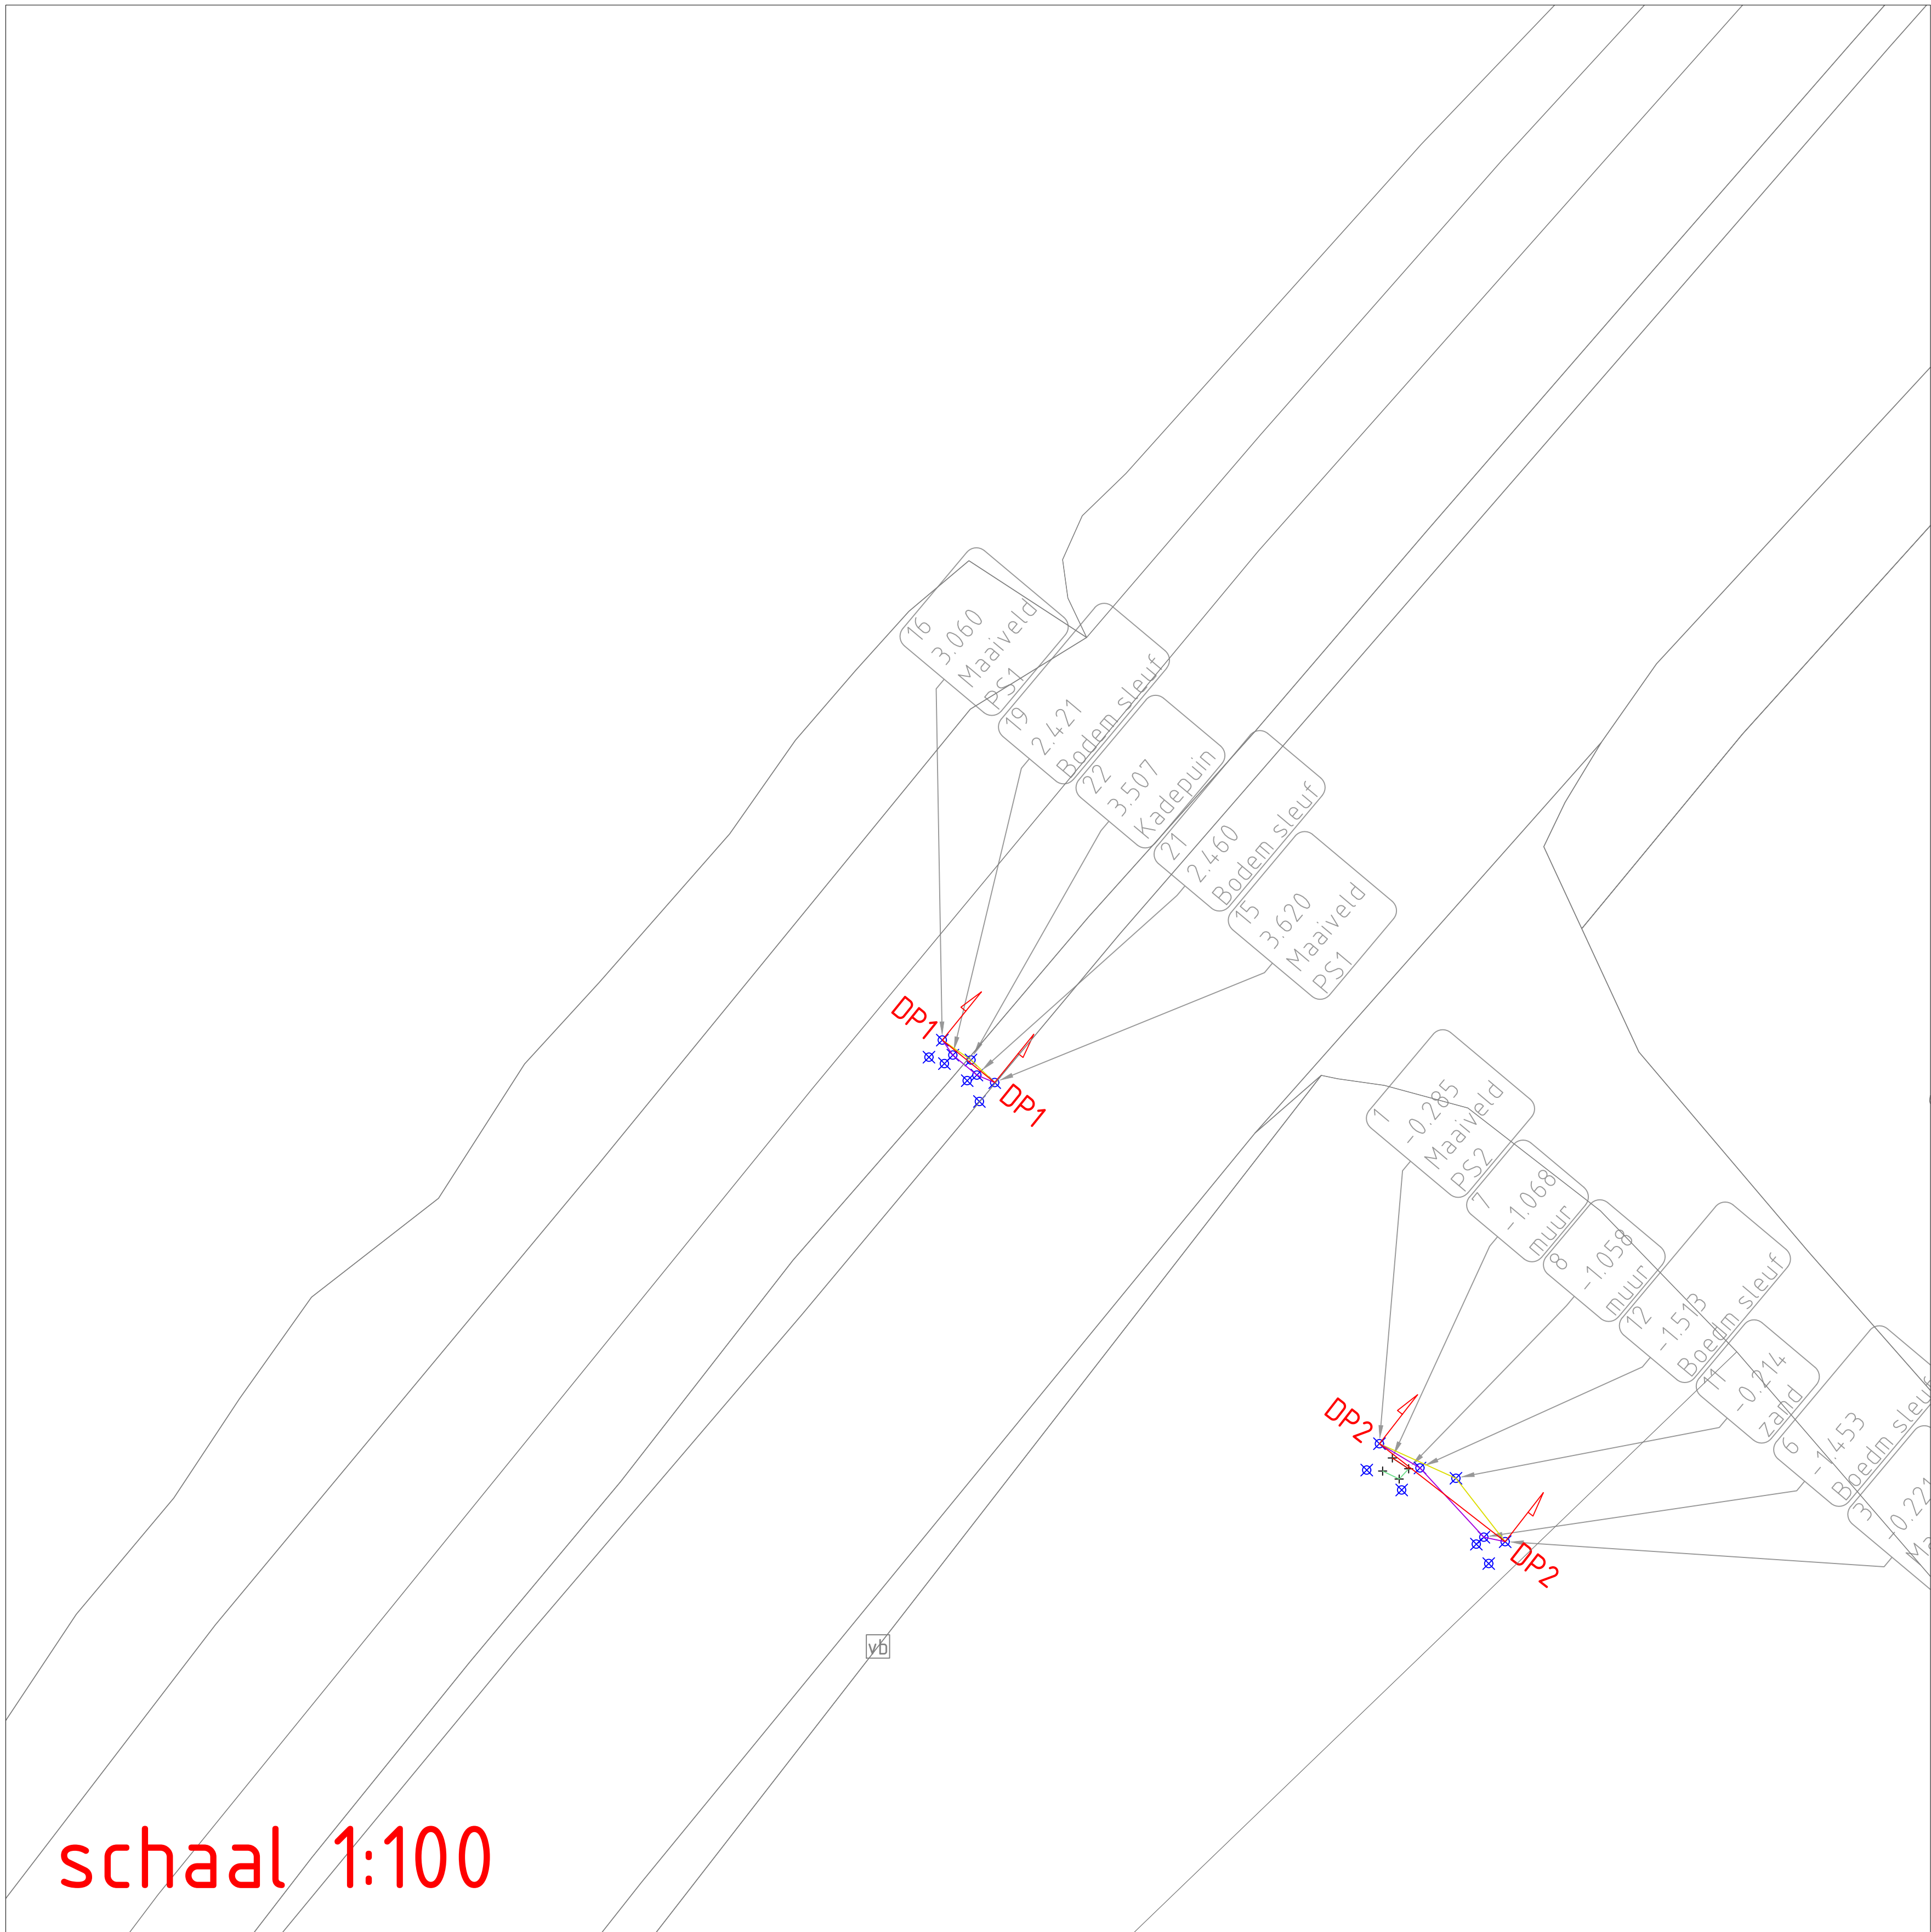

Situatie



Foto's

Maten in meters, tenzij anders vermeld
Diameters in milimeters, tenzij anders vermeld
Hoogtematen op meters t.o.v. N.A.P., tenzij anders vermeld
De proefsleuf betreft een moment opname van de aangegeven locatie.
Buiten de locatie van de proefsleuf kunnen de ligging van de kabels en leidingen en de grondsamenstelling afwijken.