

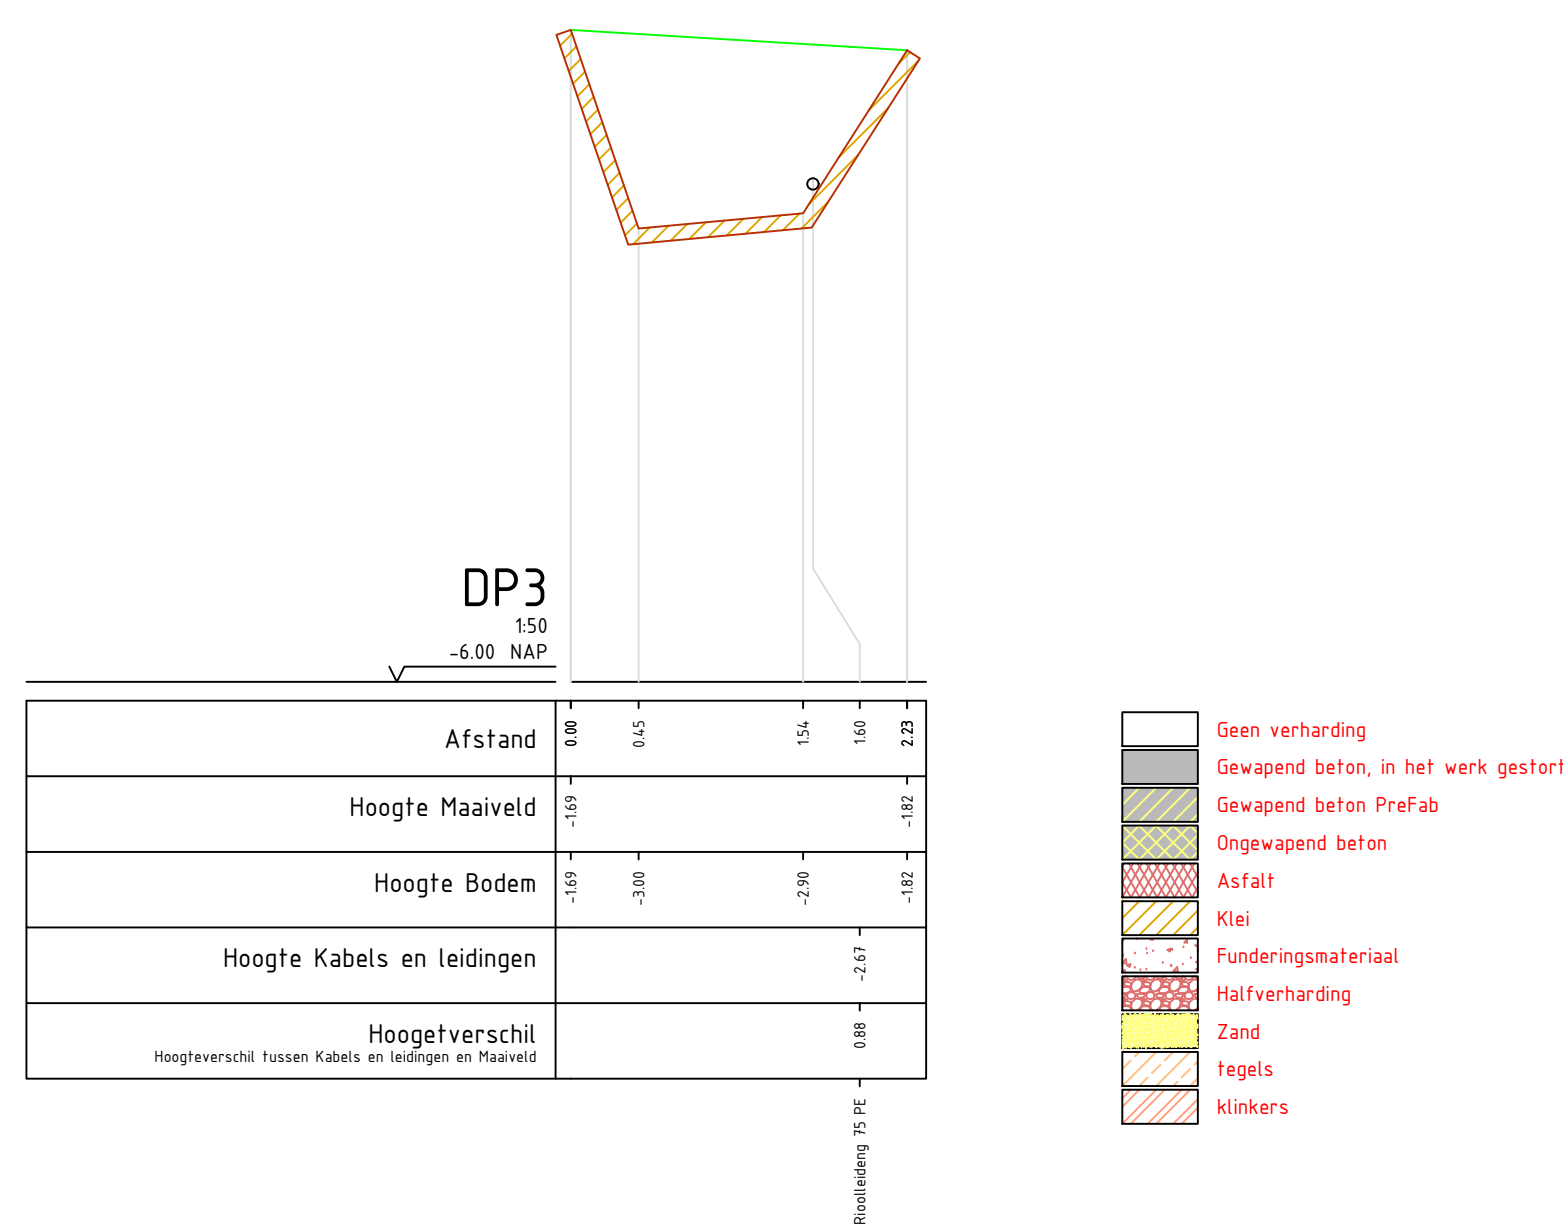


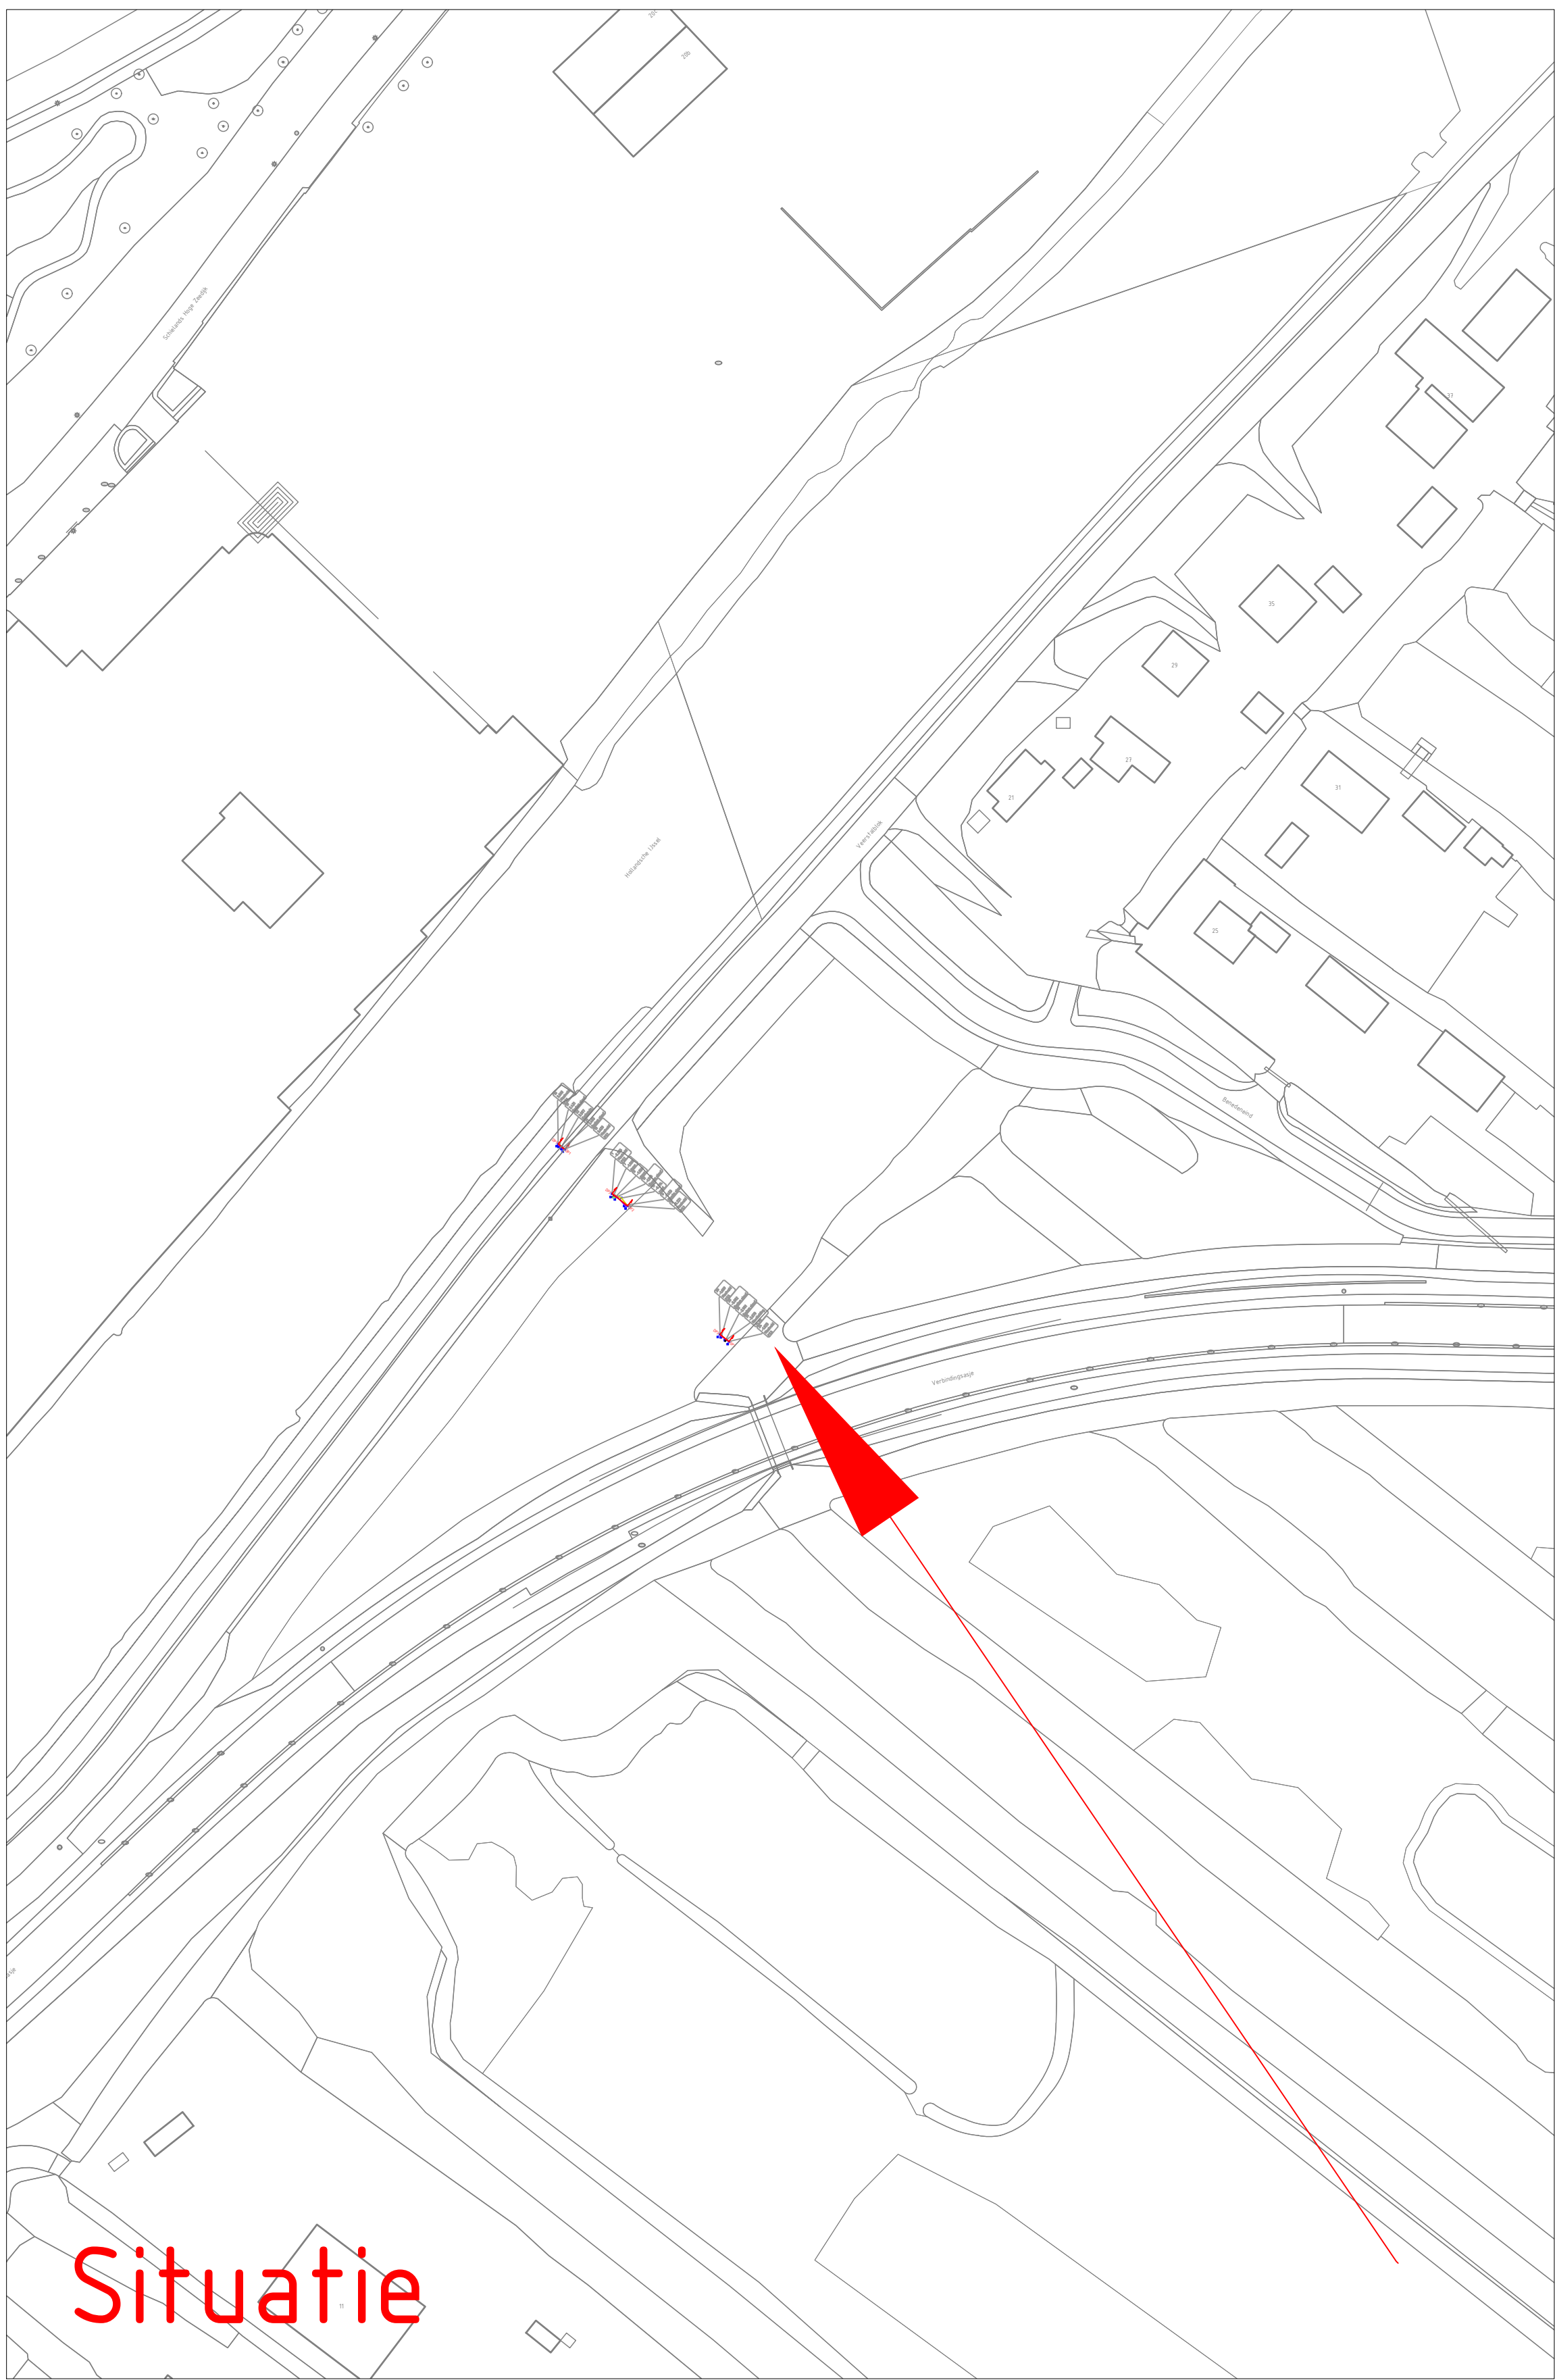

Puntnummer	X Coördinaat	Y Coördinaat	Z Coördinaat	Layer	Omschrijving
23	108098.470	445809.026	-1.877	137	PS3
24	108098.733	445809.547	-1.823	137	PS3
25	108096.537	445810.431	-1.728	137	PS3
26	108096.982	445810.920	-1.689	137	PS3
27	108097.149	445810.345	-3.042	137	BODEM
28	108097.269	445810.558	-3.002	137	BODEM
29	108097.918	445809.793	-3.039	137	BODEM
30	108098.155	445809.926	-2.901	137	BODEM
31	108098.156	445809.821	-2.670	312	75 PE
32	108097.997	445809.644	-2.649	312	75 PE

Dwarsprofiel schaal 1:50

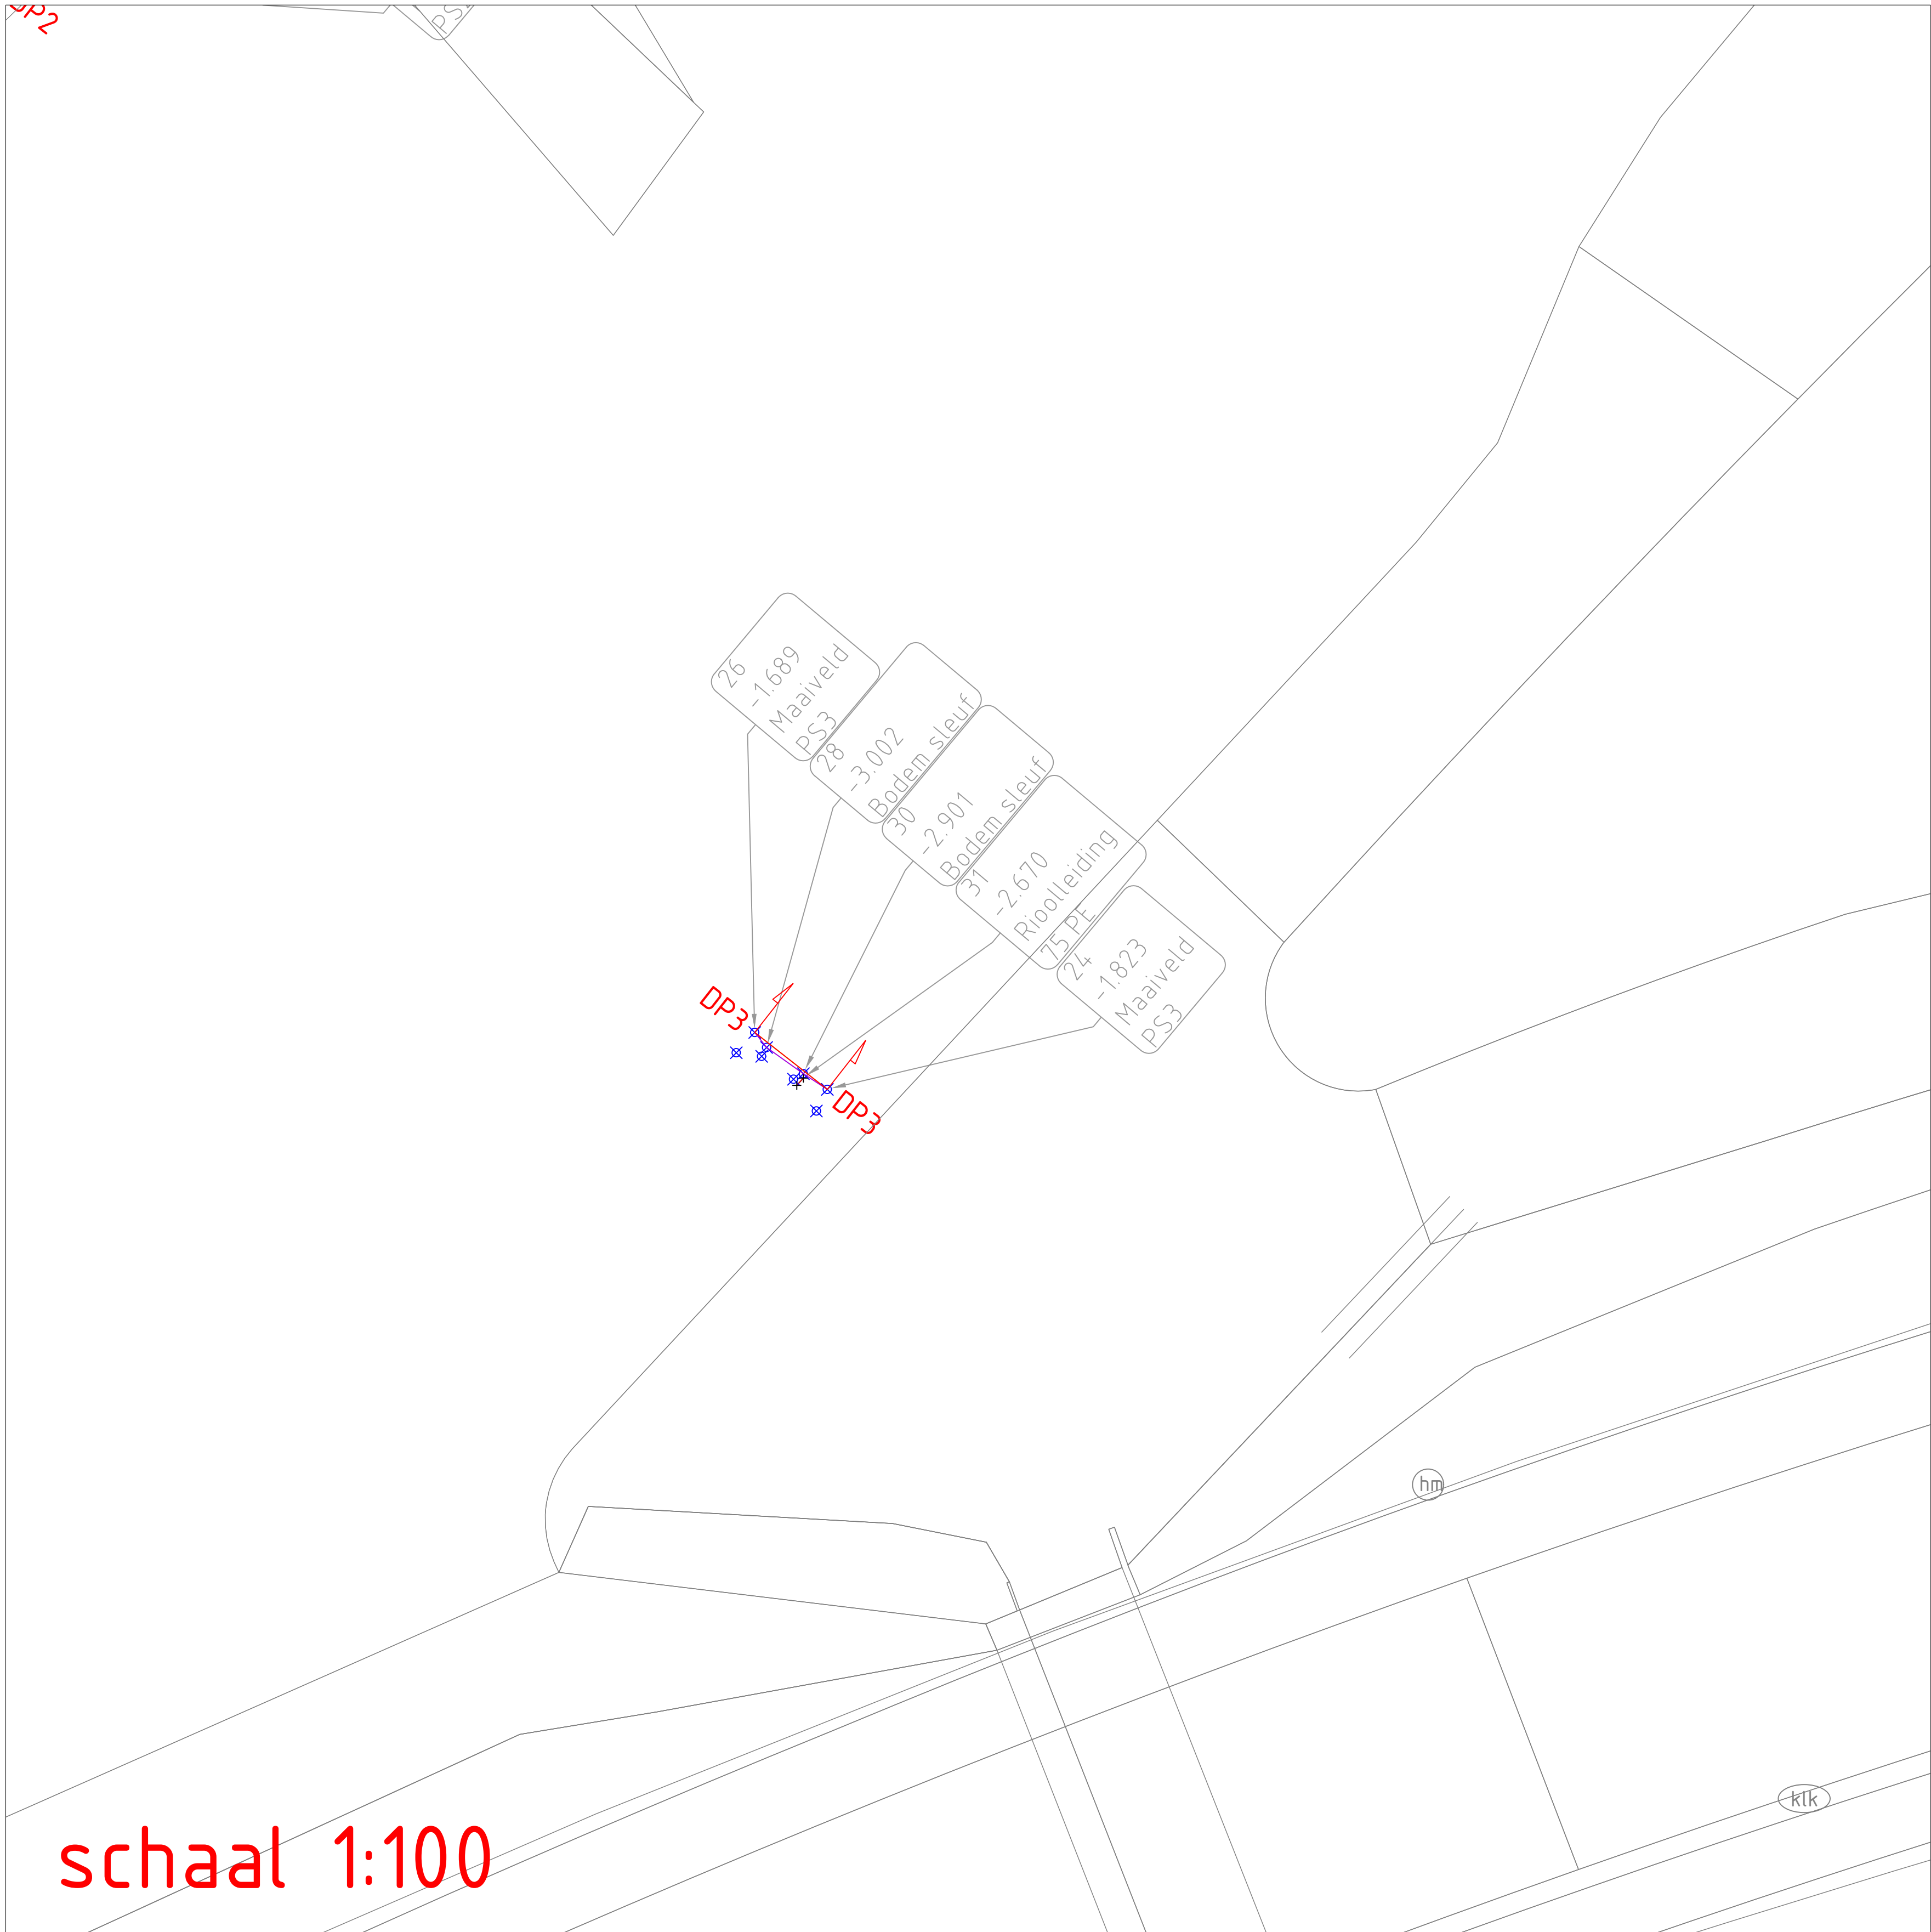

Foto's

Maten in meters, tenzij anders vermeld
Diameters in milimeters, tenzij anders vermeld
Hoogtematen op meters t.o.v. N.A.P., tenzij anders vermeld
De proefsleuf betreft een moment opname van de aangegeven locatie.
Buiten de locatie van de proefsleuf kunnen de ligging van de kabels en leidingen en de grondsamenstelling afwijken.