



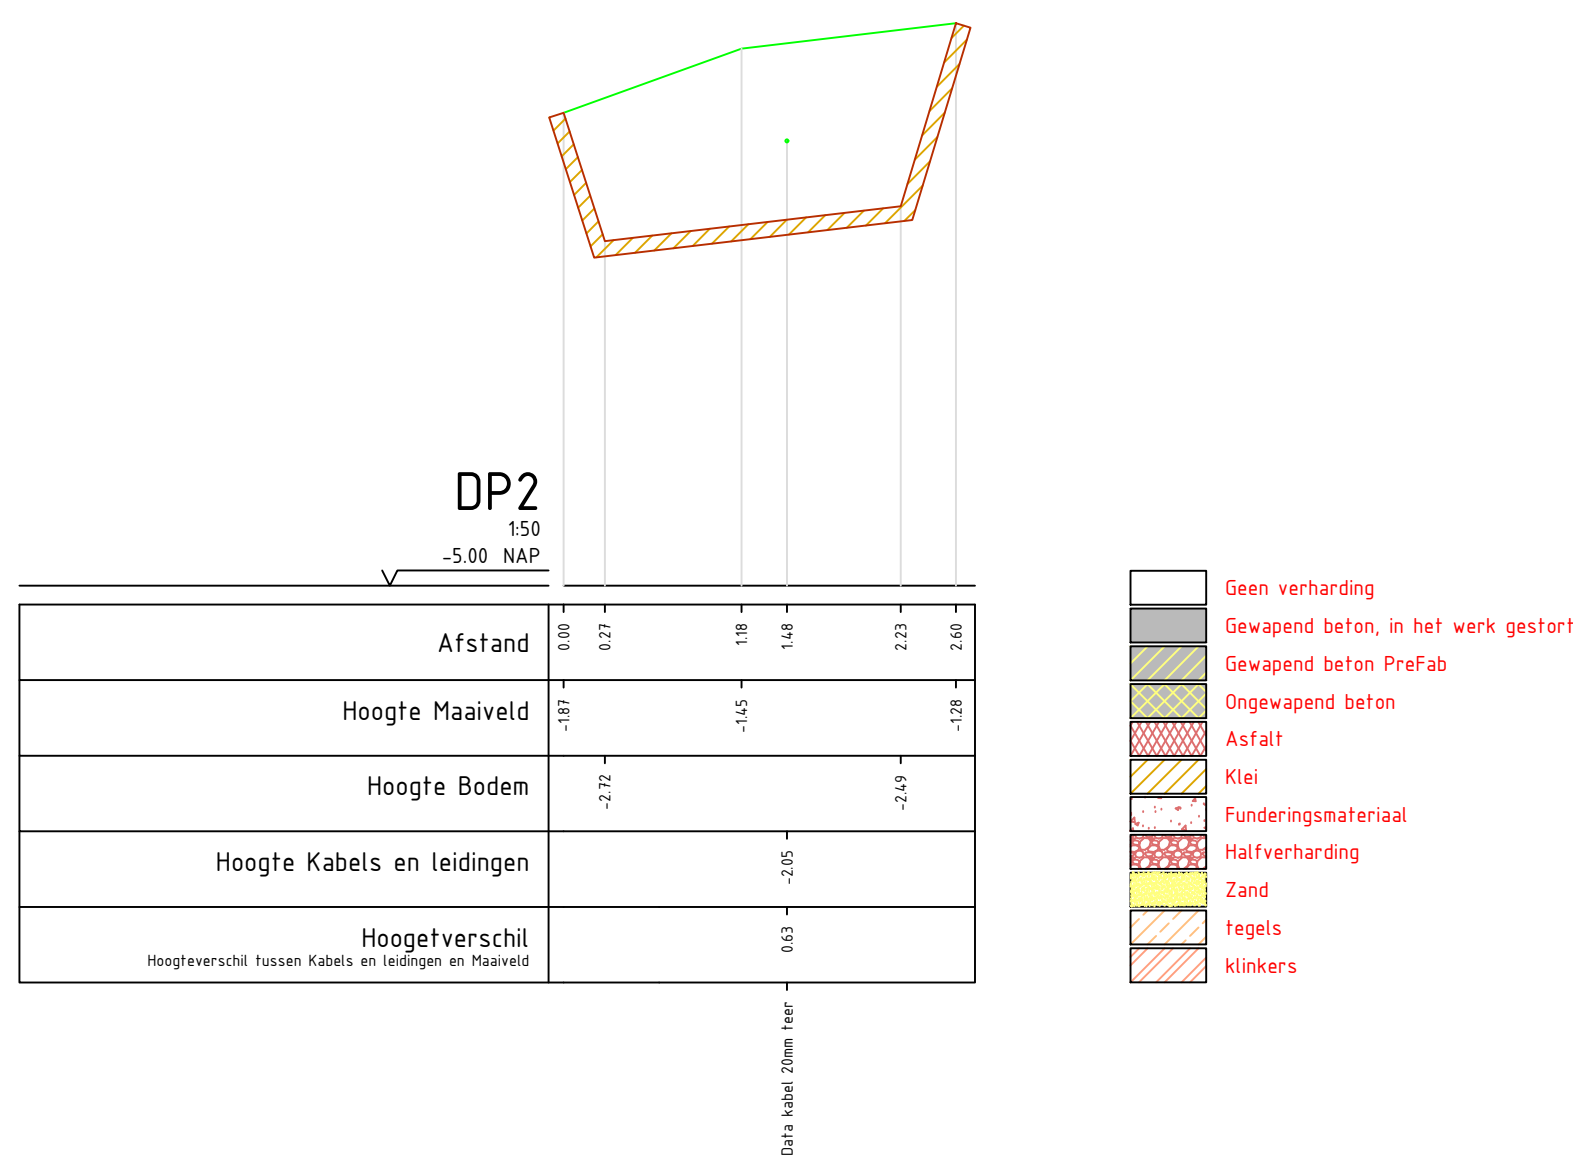

Puntnummer	X Coördinaat	Y Coördinaat	Z Coördinaat	Layer	Omschrijving
1	113436.292	444474.302	-1.284	137	PS2
2	113436.462	444473.876	-1.281	137	PS2
3	113435.305	444473.780	-2.057	360	220mm Teer
4	113435.362	444473.628	-2.050	360	220mm Teer
5	113434.976	444473.889	-1.447	137	PS2
6	113435.169	444473.284	-1.449	137	PS2
7	113434.029	444472.973	-1.873	137	PS2
8	113433.880	444473.465	-1.908	137	PS2
9	113434.232	444473.209	-2.722	137	Bodem sleuf
10	113434.157	444473.383	-2.777	137	Bodem sleuf
11	113436.043	444473.953	-2.491	137	Bodem sleuf
12	113436.039	444474.084	-2.468	137	Bodem sleuf

Dwarsprofiel schaal 1:50

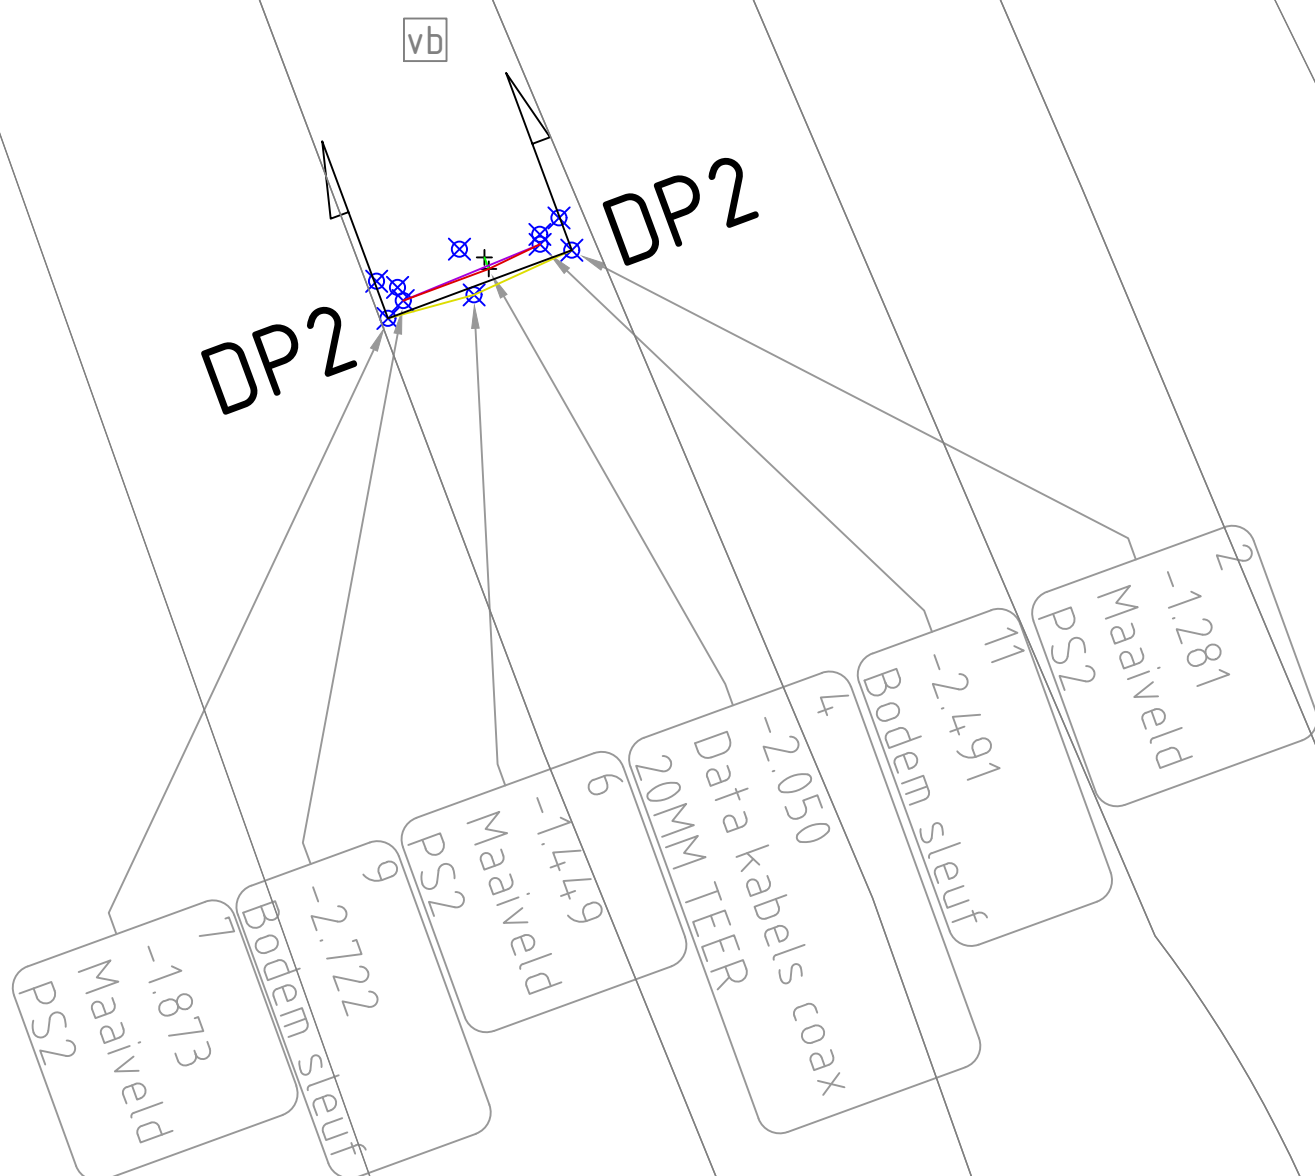

Situatie



Foto's

Maten in meters, tenzij anders vermeld
Diameters in milimeters, tenzij anders vermeld
Hoogtematen op meters t.o.v. N.A.P., tenzij anders vermeld
De proefsleuf betreft een moment opname van de aangegeven locatie.
Buiten de locatie van de proefsleuf kunnen de ligging van de kabels en leidingen en de grondsamenstelling afwijken.

