




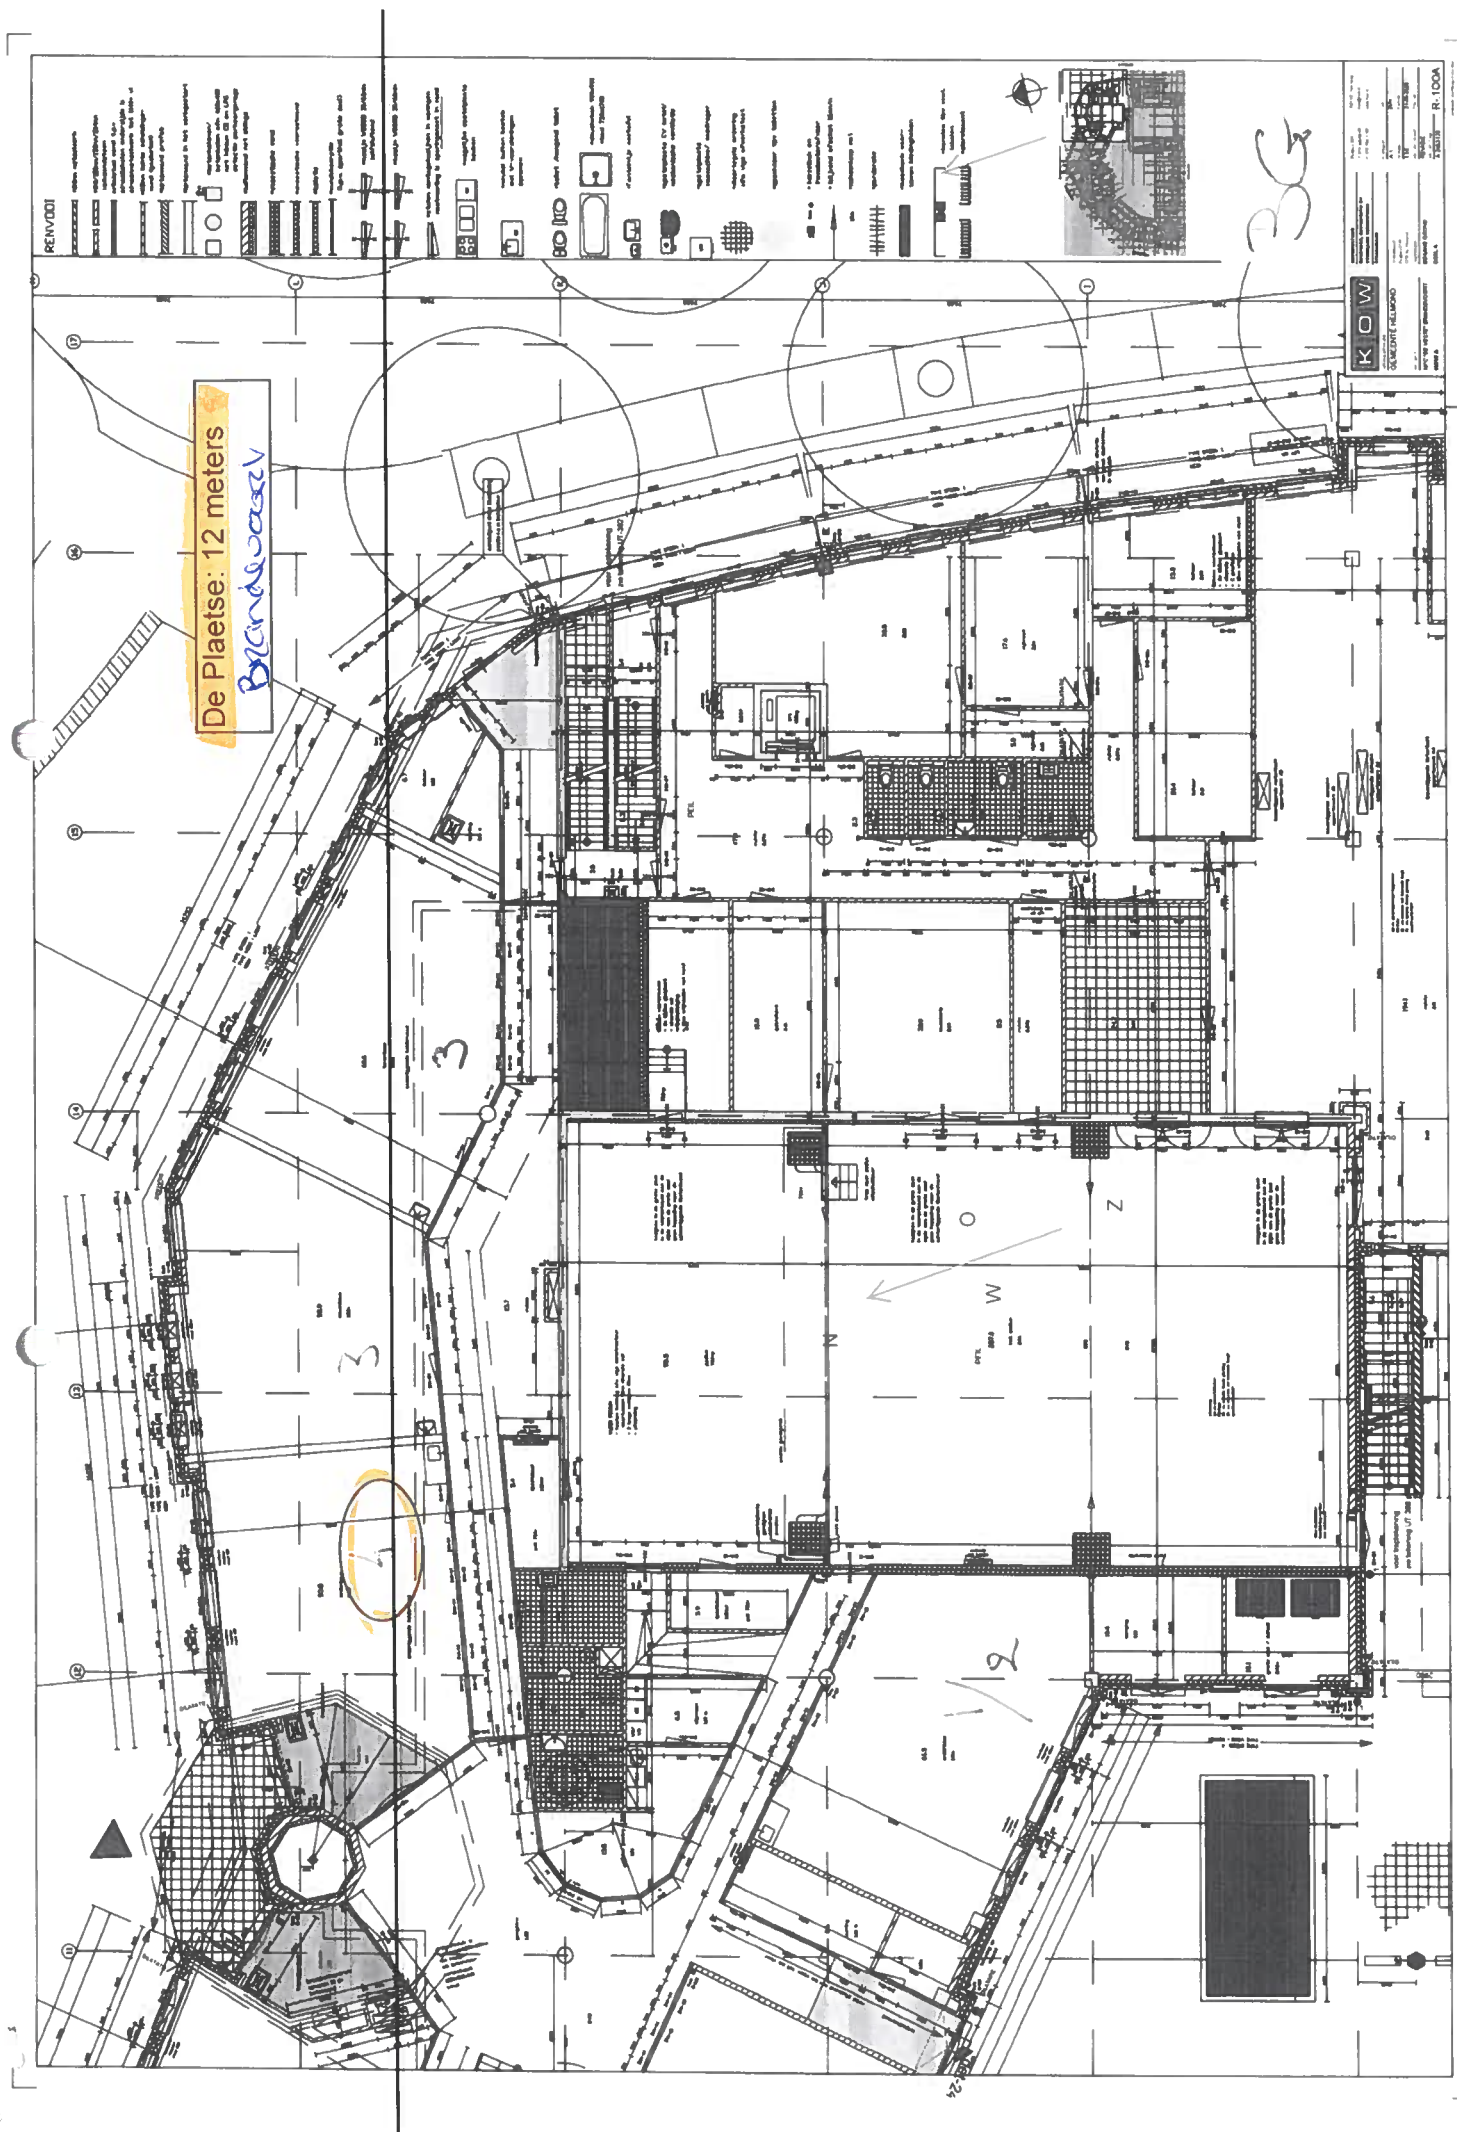

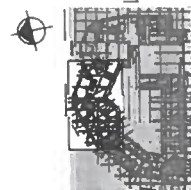

REINVOOI


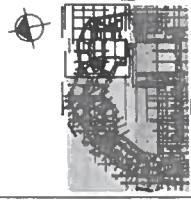

2

KOW

