


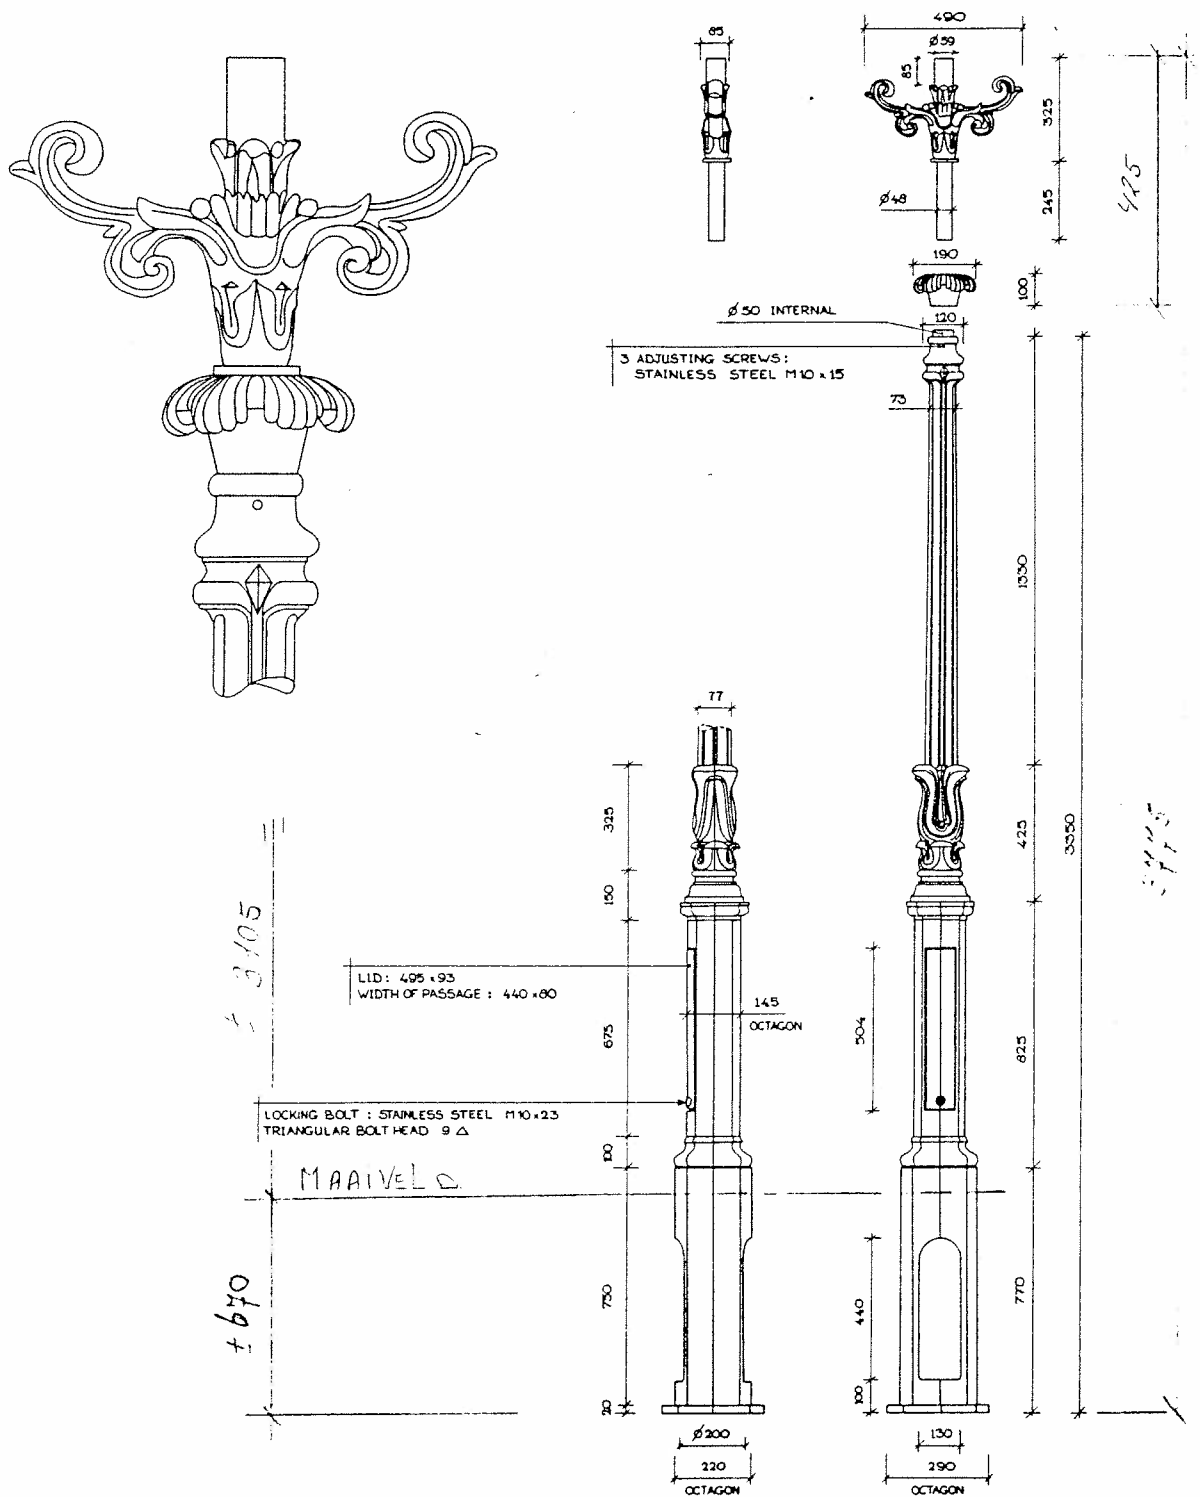

CAST-IRON LAMP POST
 FA. JOBSE - MIDDELBURG - HOLLAND

KOPERSLAGERIJ
 DE NOOD MIDDELBURG B.V. I.o.
 (v.o. Koperslagerij Jobse)
 Gaspartij, ag. 3-7, Postbus 182
 5300 AD MIDDELBURG
 (t. 01180-33405 (6 l. g. 13412)