


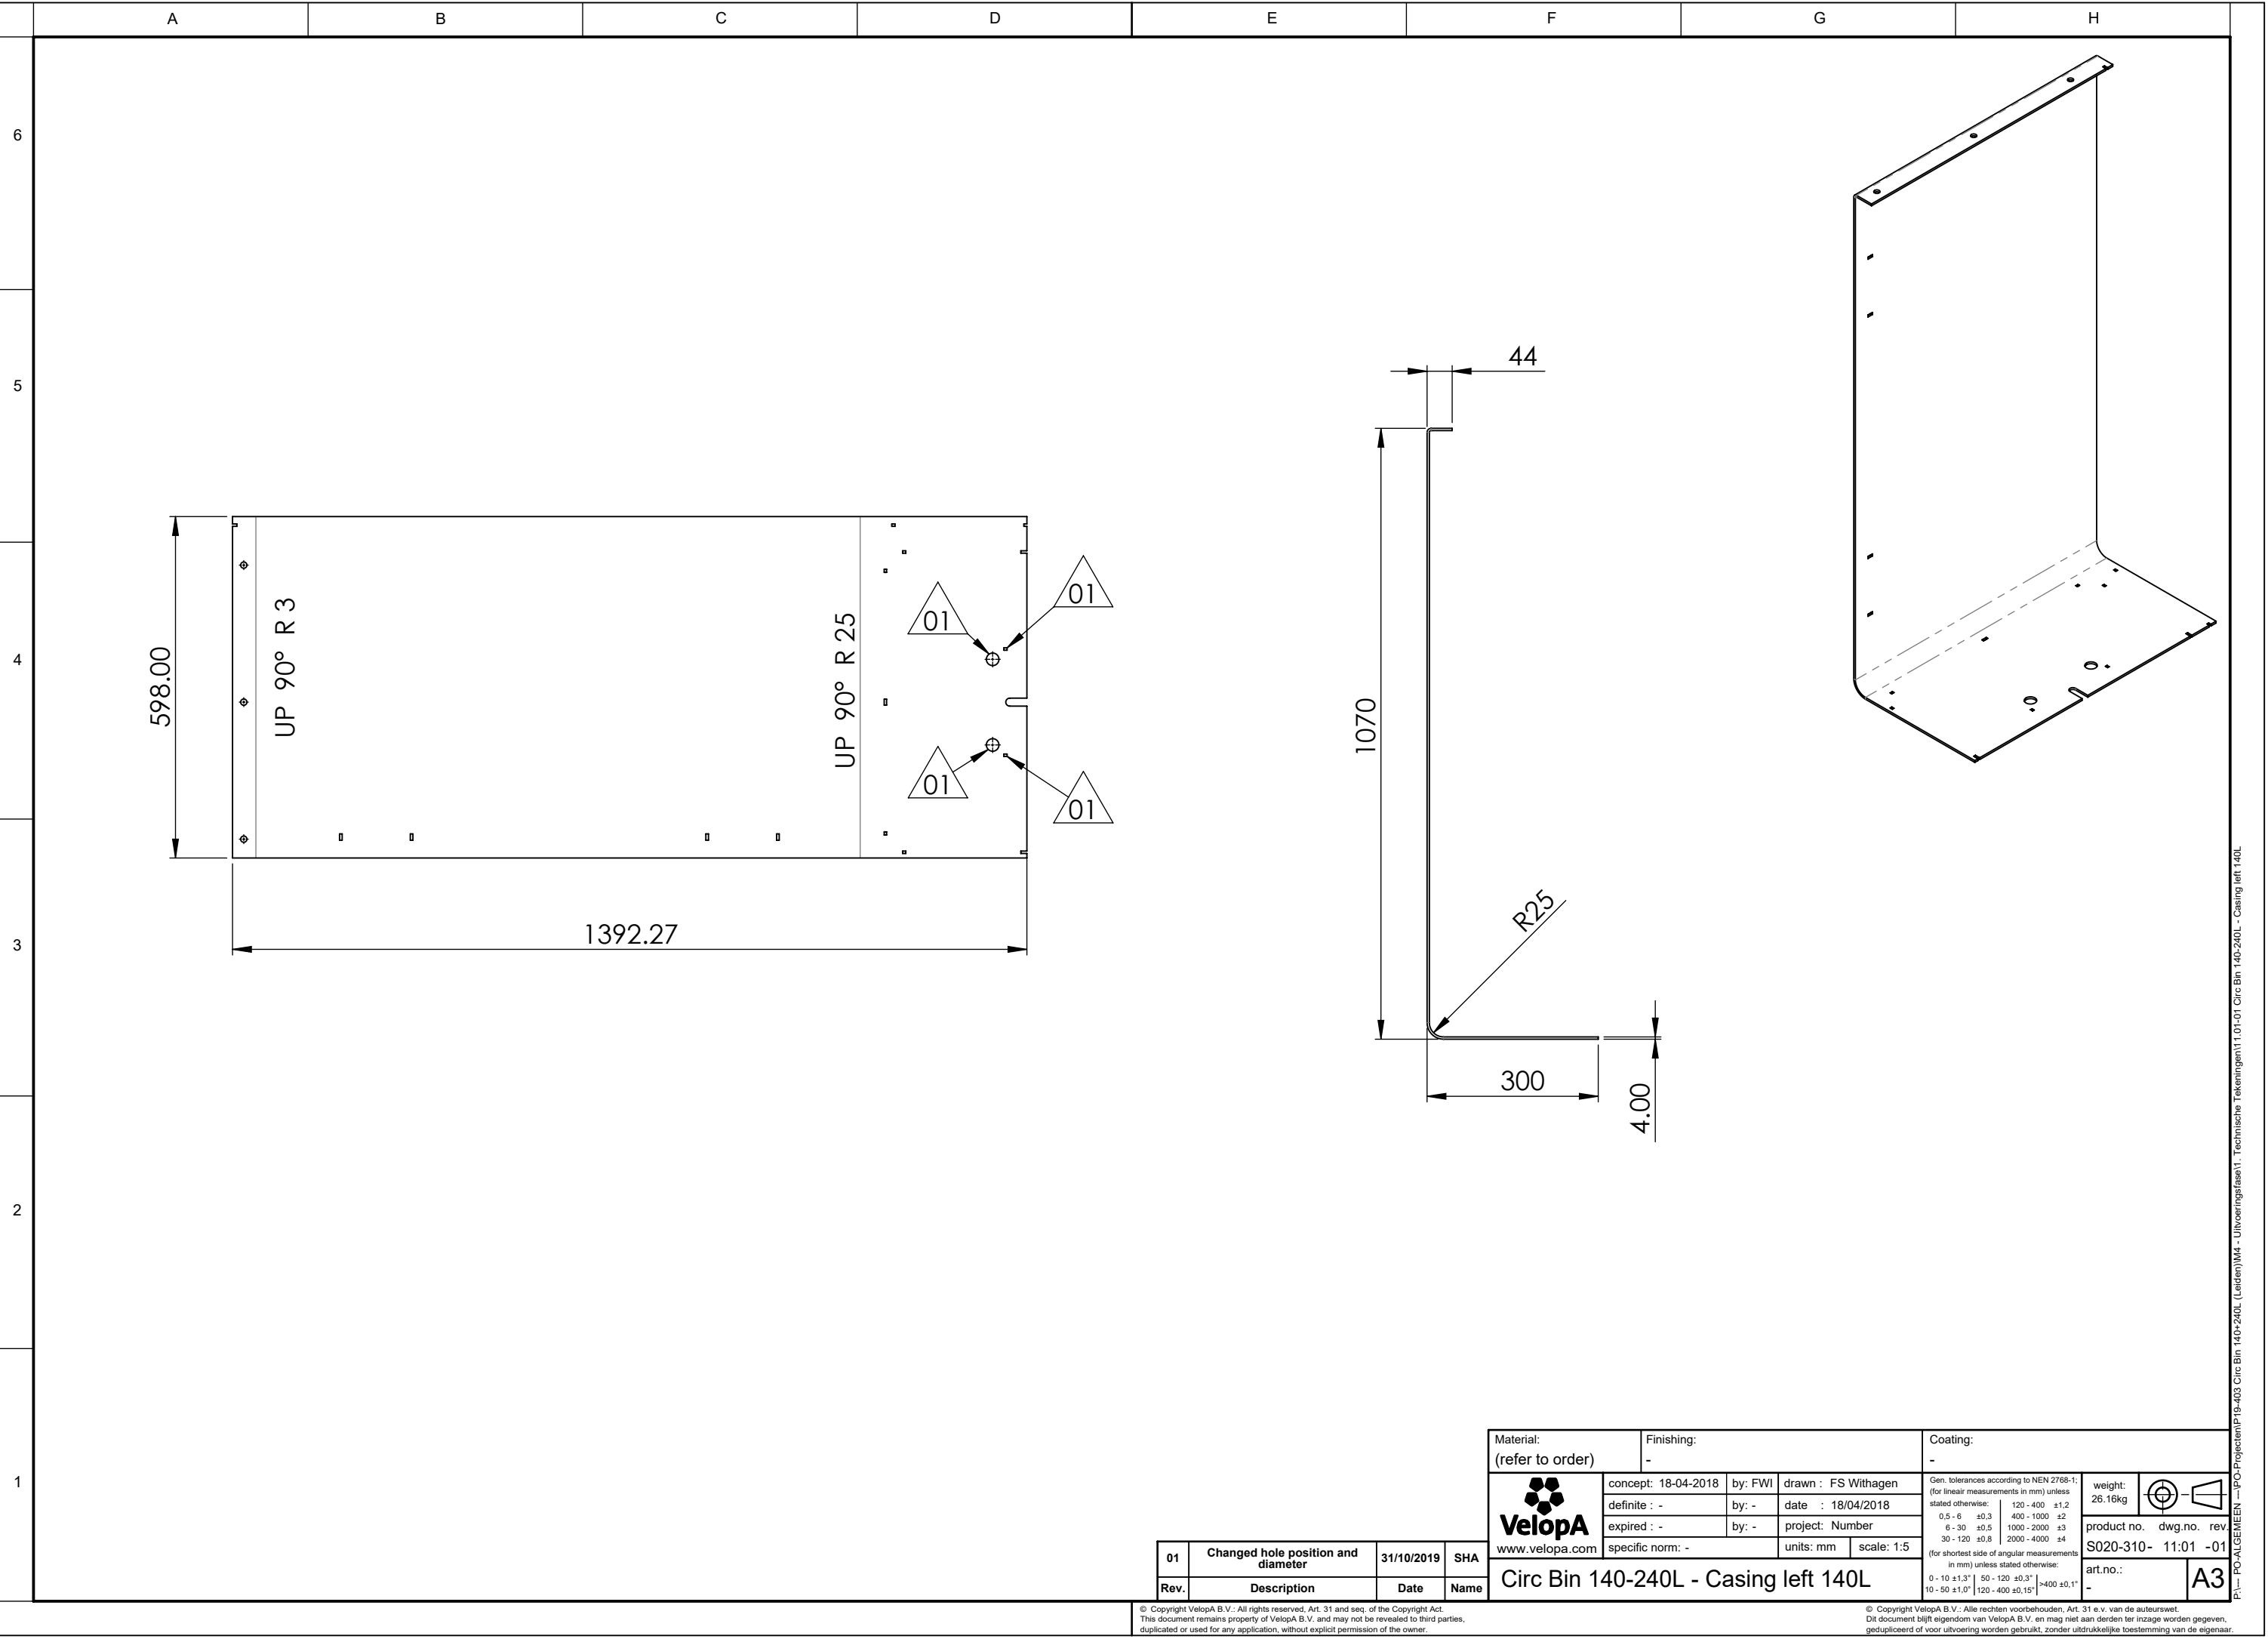

01	Changed hole position and diameter	31/10/2019	SHA
Rev.	Description	Date	Name

Material: (refer to order)		Finishing: -			Coating: -														
 VelopA www.velopa.com	concept: 18-04-2018	by: FWI	drawn : FS Withagen		Gen. tolerances according to NEN 2768-1; (for linear measurements in mm) unless stated otherwise:<table><tr><td>0.5 - 6</td><td>±0.3</td></tr><tr><td>6 - 30</td><td>±0.5</td></tr><tr><td>30 - 120</td><td>±0.8</td></tr></table>(for shortest side of angular measurements in mm) unless stated otherwise:<table><tr><td>0 - 10 ±1,3°</td><td>50 - 120 ±0,3°</td><td>>400 ±0,1°</td></tr><tr><td>10 - 50 ±1,0°</td><td>120 - 400 ±0,15°</td><td></td></tr></table>			0.5 - 6	±0.3	6 - 30	±0.5	30 - 120	±0.8	0 - 10 ±1,3°	50 - 120 ±0,3°	>400 ±0,1°	10 - 50 ±1,0°	120 - 400 ±0,15°	
	0.5 - 6	±0.3																	
	6 - 30	±0.5																	
	30 - 120	±0.8																	
	0 - 10 ±1,3°	50 - 120 ±0,3°	>400 ±0,1°																
10 - 50 ±1,0°	120 - 400 ±0,15°																		
definite : -	by: -	date : 18/04/2018																	
expired : -	project: Number																		
specific norm: -		units: mm	scale: 1:5																
Circ Bin 140-240L - Casing left 140L					weight: 26.16kg														
					product no. S020-310-	dwg.no. 11:01	rev. -01												
					art.no.: -	A3													