
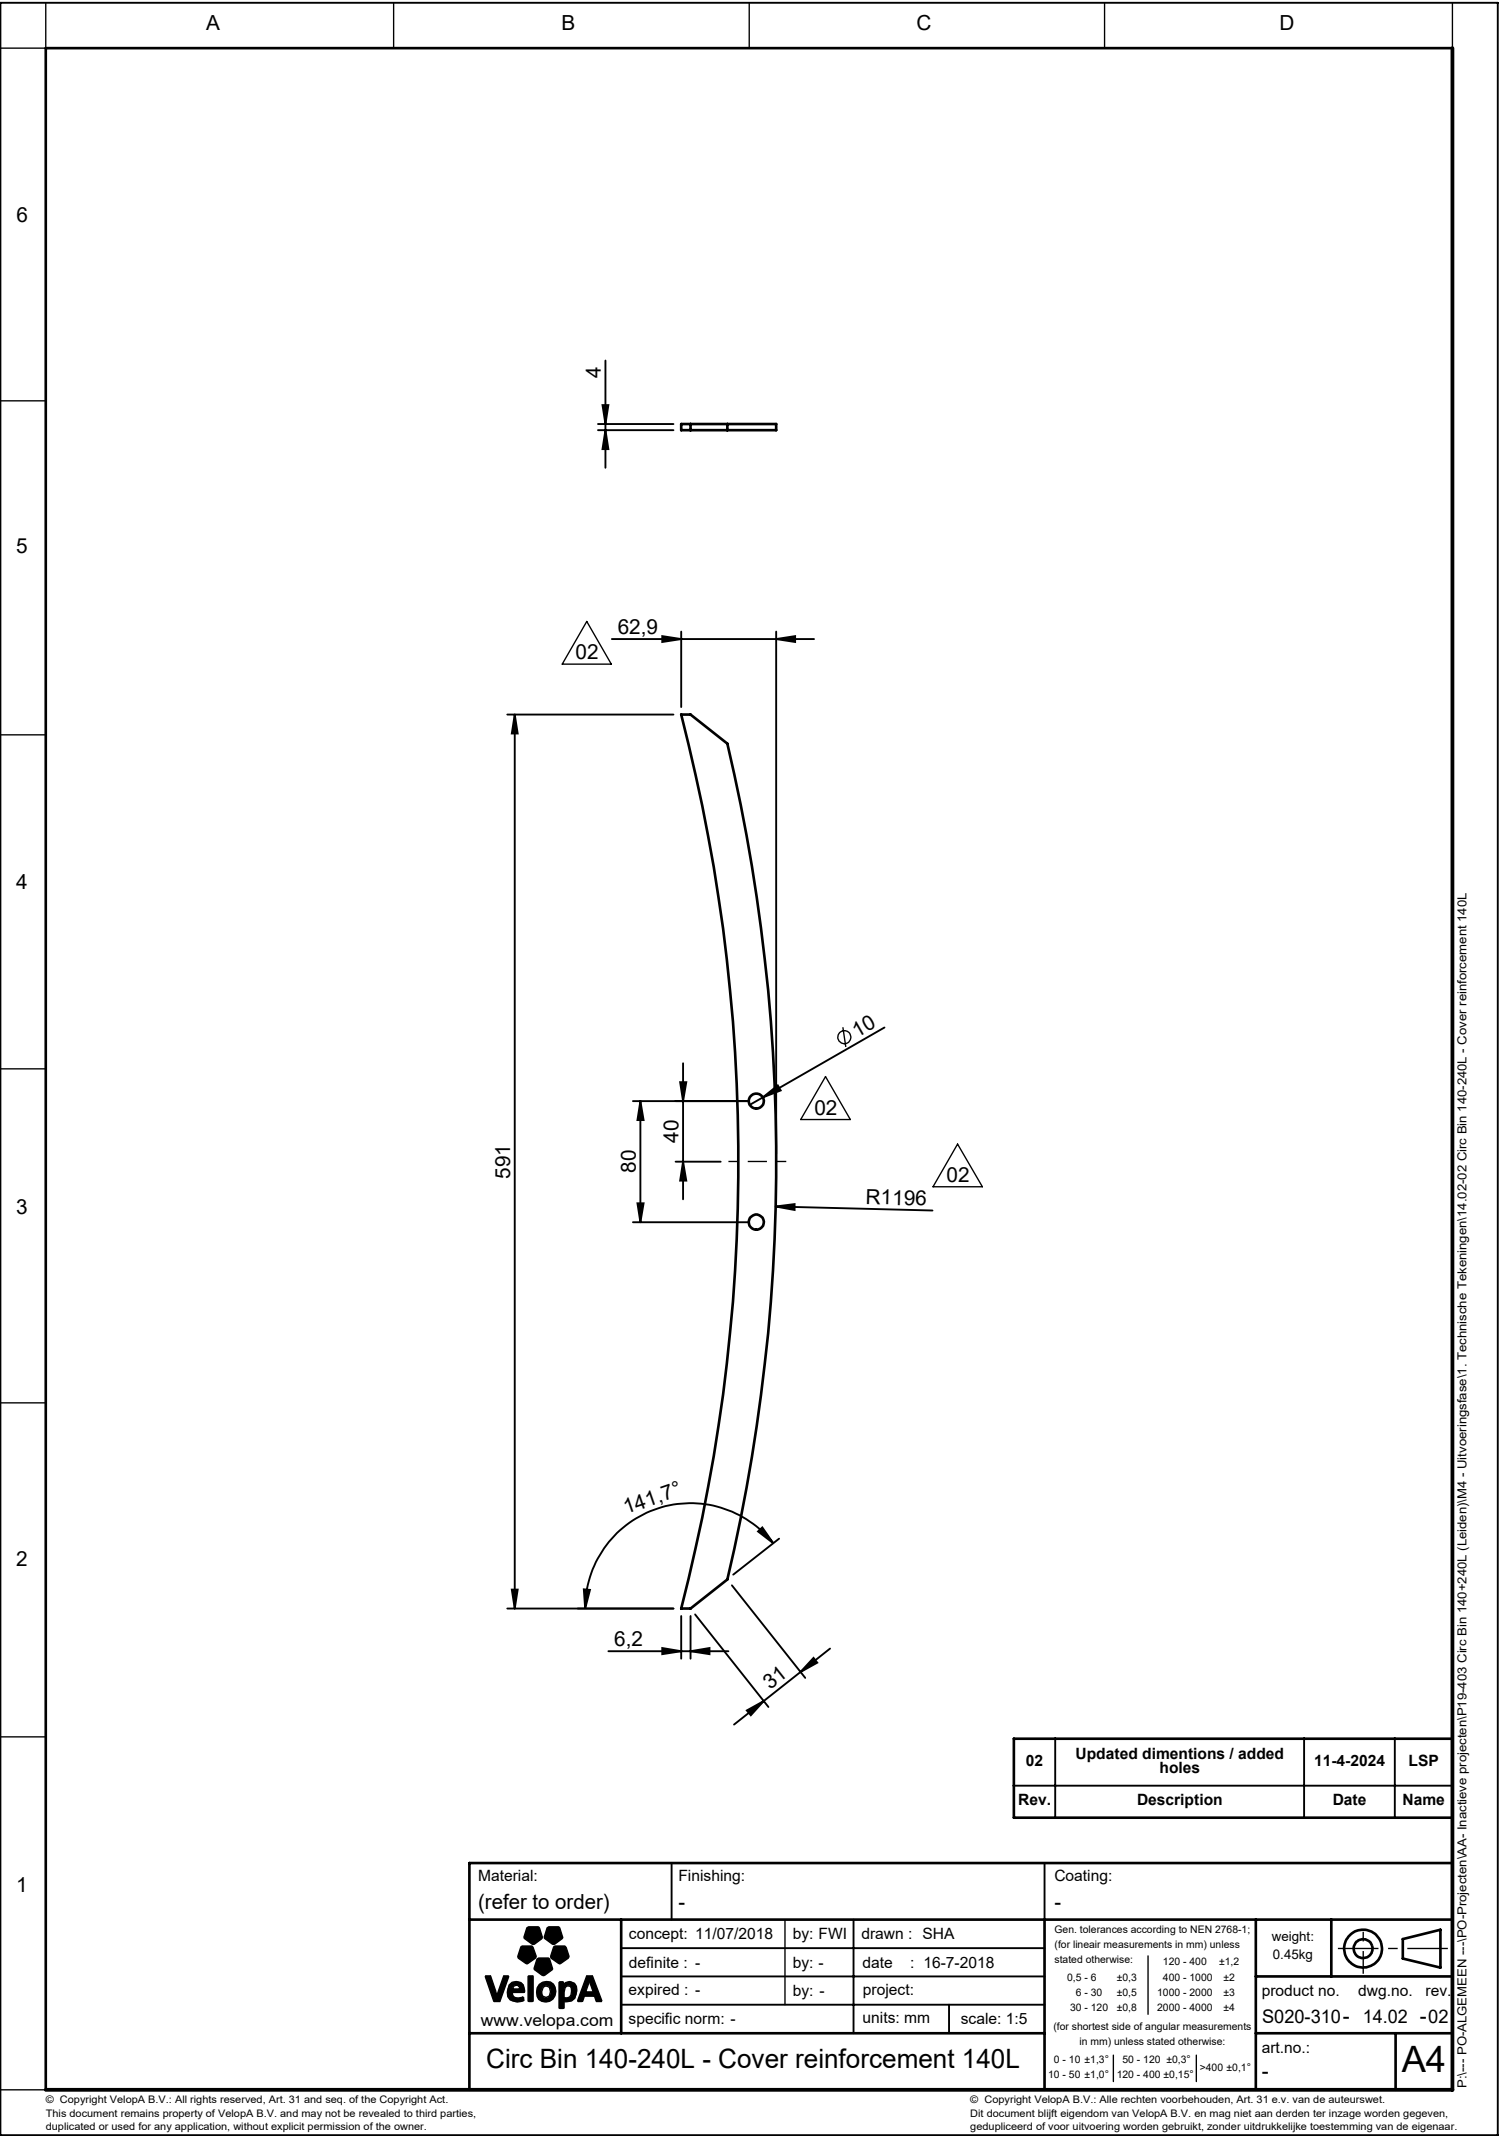


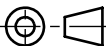

02	Updated dimentions / added holes	11-4-2024	LSP
Rev.	Description	Date	Name

Material: (refer to order)		Finishing: -		Coating: -							
 www.velopa.com	concept: 11/07/2018	by: FWI	drawn : SHA								
	definite : -	by: -	date : 16-7-2018								
	expired : -	by: -	project:								
	specific norm: -		units: mm	scale: 1:5							
Circ Bin 140-240L - Cover reinforcement 140L					Gen. tolerances according to NEN 2768-1: (for linear measurements in mm) unless stated otherwise: 0.5 - 6 ±0.3 100 - 400 ±1.2 6 - 30 ±0.5 400 - 1000 ±2 30 - 120 ±0.8 1000 - 2000 ±3 2000 - 4000 ±4 (for shortest side of angular measurements in mm) unless stated otherwise: 0 - 10 ±1,3° 50 - 120 ±0,3° >400 ±0,1° 10 - 50 ±1,0° 120 - 400 ±0,15°						
					weight: 0.45kg						
					product no. S020-310-			dwg.no. 14.02		rev. -02	
					art.no.: -		A4				