


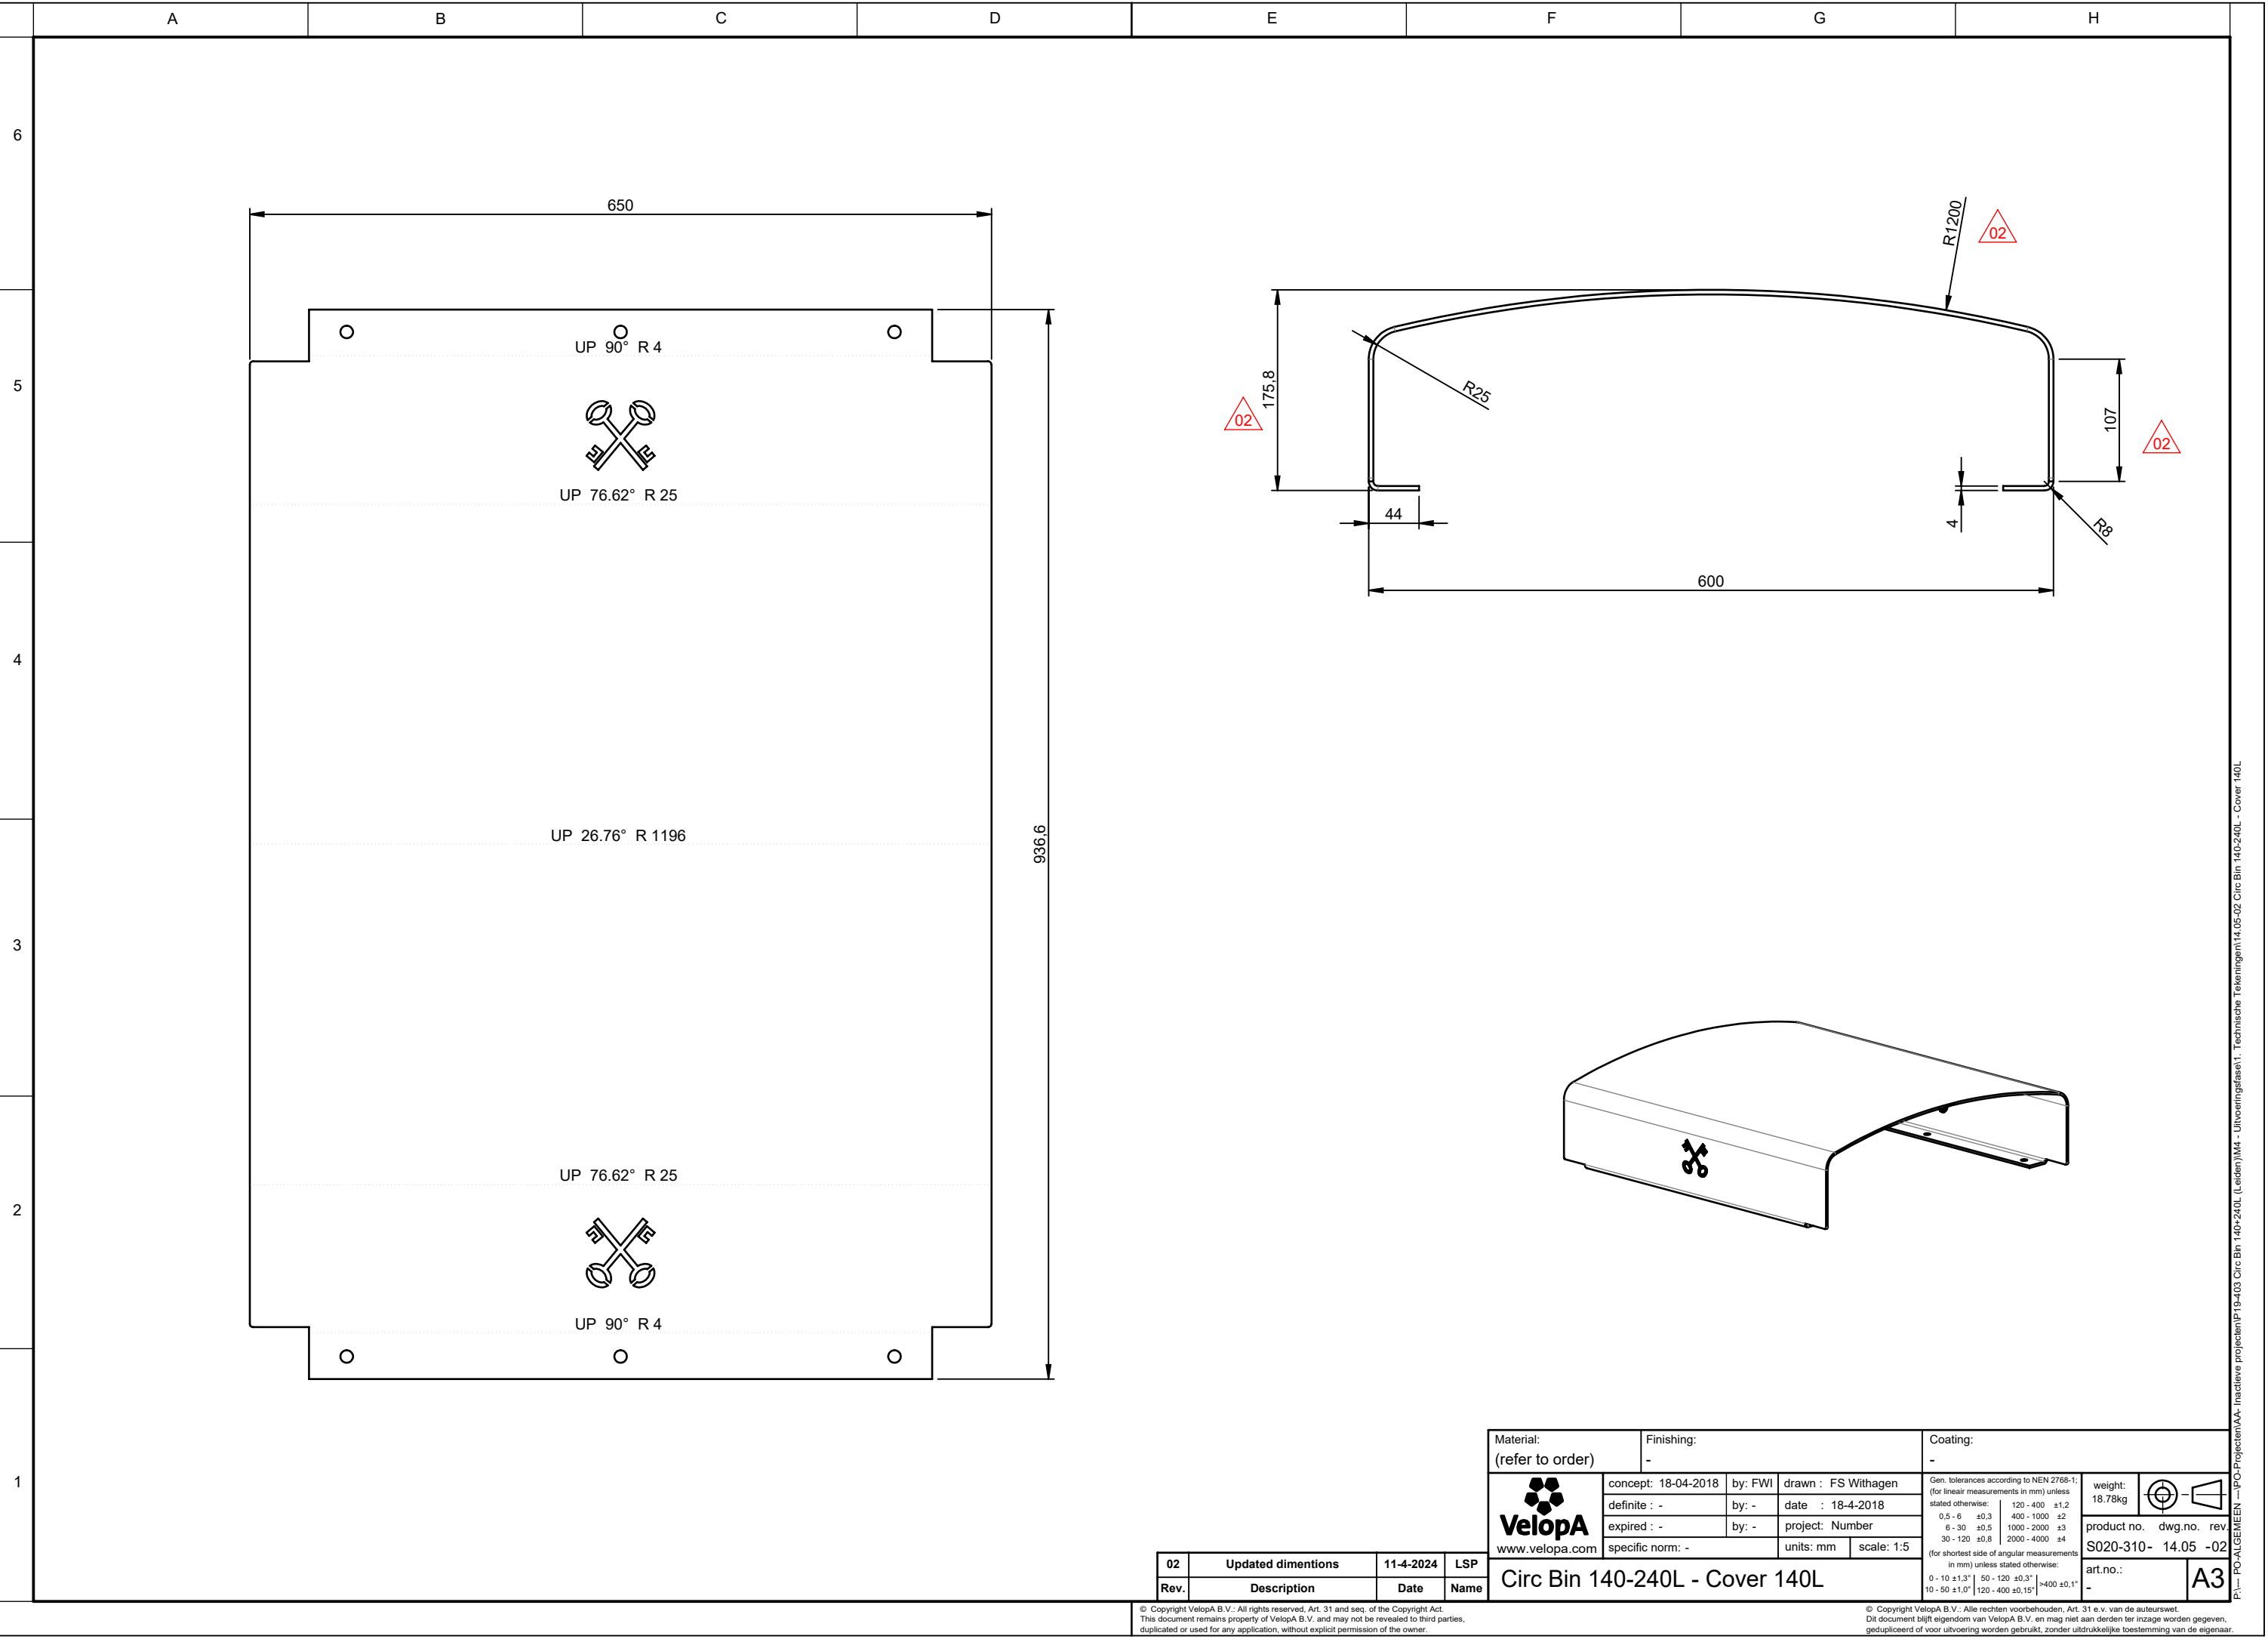

02	Updated dimentions	11-4-2024	LSP
Rev.	Description	Date	Name

Material: (refer to order)		Finishing: -			Coating: -																								
 Velopa www.velopa.com	concept: 18-04-2018	by: FWI	drawn : FS Withagen		Gen. tolerances according to NEN 2768-1; (for linear measurements in mm) unless stated otherwise: <table><tr><td>0.5 - 6</td><td>±0.3</td><td>120 - 400</td><td>±1.2</td></tr><tr><td>6 - 30</td><td>±0.5</td><td>400 - 1000</td><td>±2</td></tr><tr><td>30 - 120</td><td>±0.8</td><td>1000 - 2000</td><td>±3</td></tr><tr><td></td><td></td><td>2000 - 4000</td><td>±4</td></tr></table> (for shortest side of angular measurements in mm) unless stated otherwise: <table><tr><td>0 - 10 ±1,3°</td><td>50 - 120 ±0,3°</td><td>>400 ±0,1°</td></tr><tr><td>10 - 50 ±1,0°</td><td>120 - 400 ±0,15°</td><td></td></tr>
definite : -	by: -	date : 18-4-2018																											
expired : -	by: -	project: Number																											
specific norm: -		units: mm	scale: 1:5																										
		Circ Bin 140-240L - Cover 140L																											
				weight: 18.78kg																									
				product no. S020-310-	dwg.no. rev. 14.05 -02																								
				art.no.: -	A3																								

© Copyright VelopA B.V.: All rights reserved, Art. 31 and seq. of the Copyright Act.
This document remains property of VelopA B.V. and may not be revealed to third parties,
duplicated or used for any application, without explicit permission of the owner.

© Copyright VelopA B.V.: Alle rechten voorbehouden, Art. 31 e.v. van de auteurswet.
Dit document blijft eigendom van VelopA B.V. en mag niet aan derden ter inzage worden gegeven,
gedupliceerd of voor uitvoering worden gebruikt, zonder uitdrukkelijke toestemming van de eigenaar.

P:\... PO-ALGEMEEN --- PO-Projecten\AA- Inactieve projecten\19-403 Circ Bin 140-240L (Leiden)\M4 - Uitvoeringsfase\1. Technische Tekeningen\14.05-02 Circ Bin 140-240L - Cover 140L