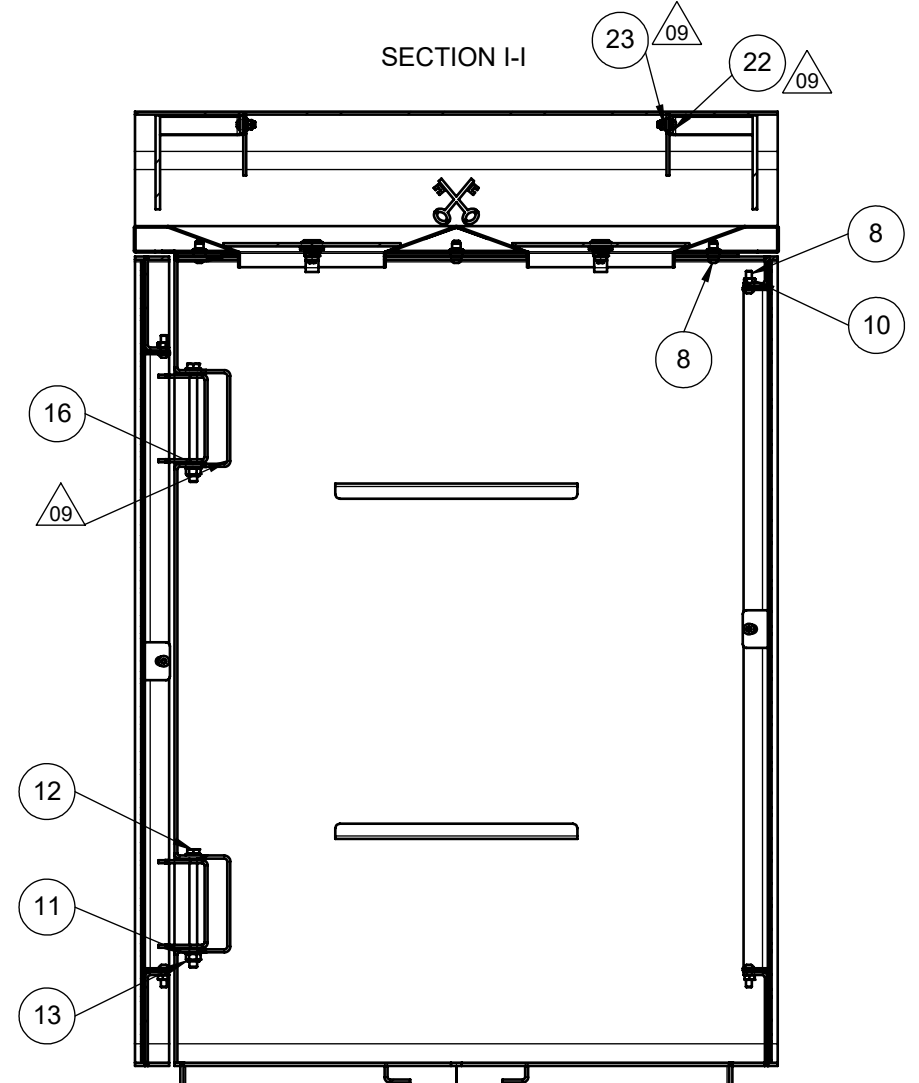
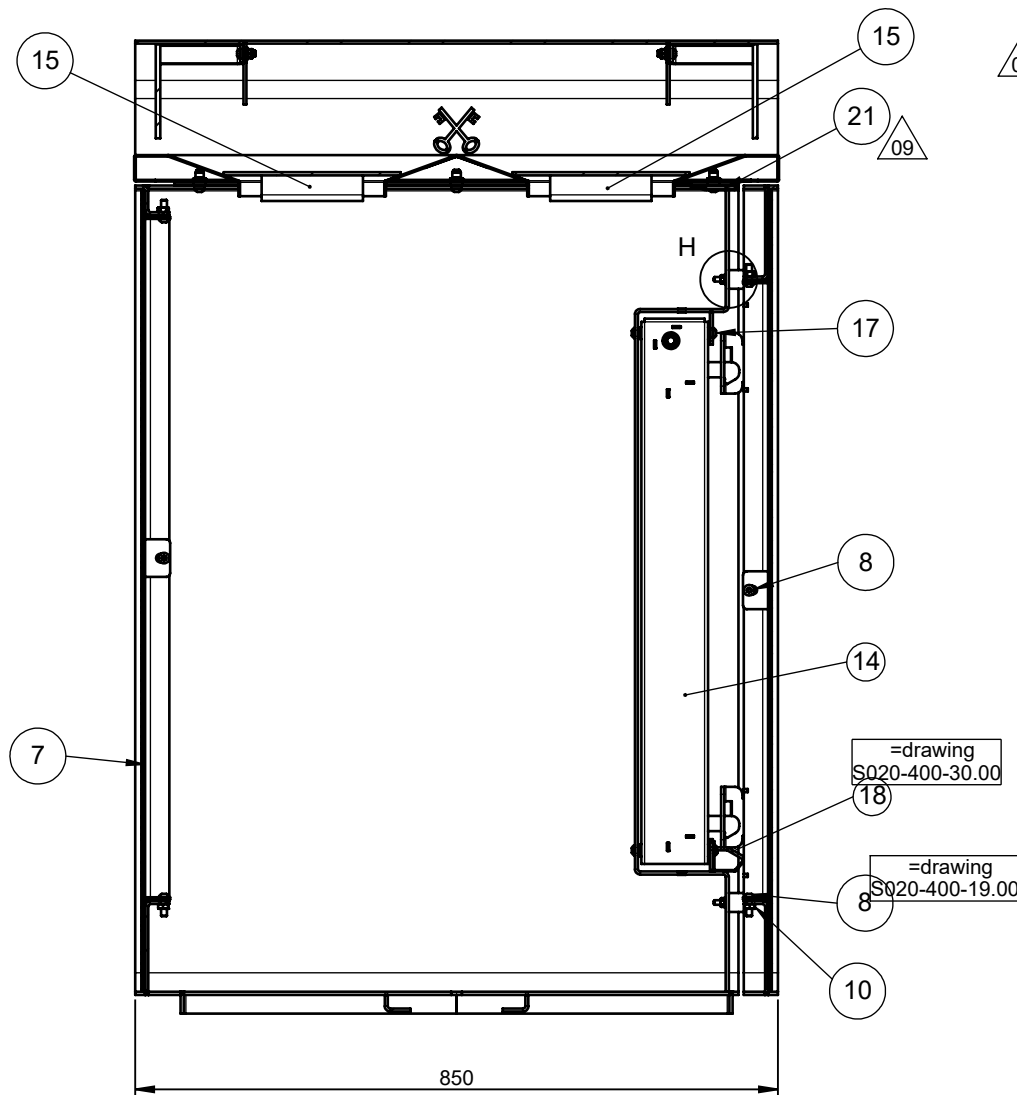


09	Added parts	17-4-2024	LSF
09	Updated dimentions	11-4-2024	LSF
09	Changed hinge	15-2-2024	LSF
09	Added hole (hanidle)	15-2-2024	LSF
08	corrected dwg23.00	4-6-2021	BW
07	corrected size rubber damper	5-3-2021	BW
06	Update Bom revisions	22-2-2021	BW
05	Added door ramp	21-9-2020	CS
04	Updated weldment	13-7-2020	CS
03	Updated weldment	18-5-2020	RB
02	Tighten nuts with loctite 243	17-3-2020	SHA
01	Revised parts	31/10/2019	SHA
Rev.	Description	Date	Name

[illegible]

1	TIGHTEN NUTS WITH LOCKTIT 243
---	-------------------------------

© Copyright VelopA B.V.: Alle rechten voorbehouden, Art. 31 e.v. van de auteurswet.
Dit document blijft eigendom van VelopA B.V. en mag niet aan derden ter inzage worden gegeven,
gedupliceerd of voor uitvoering worden gebruikt, zonder uitdrukkelijke toestemming van de eigenaar.