


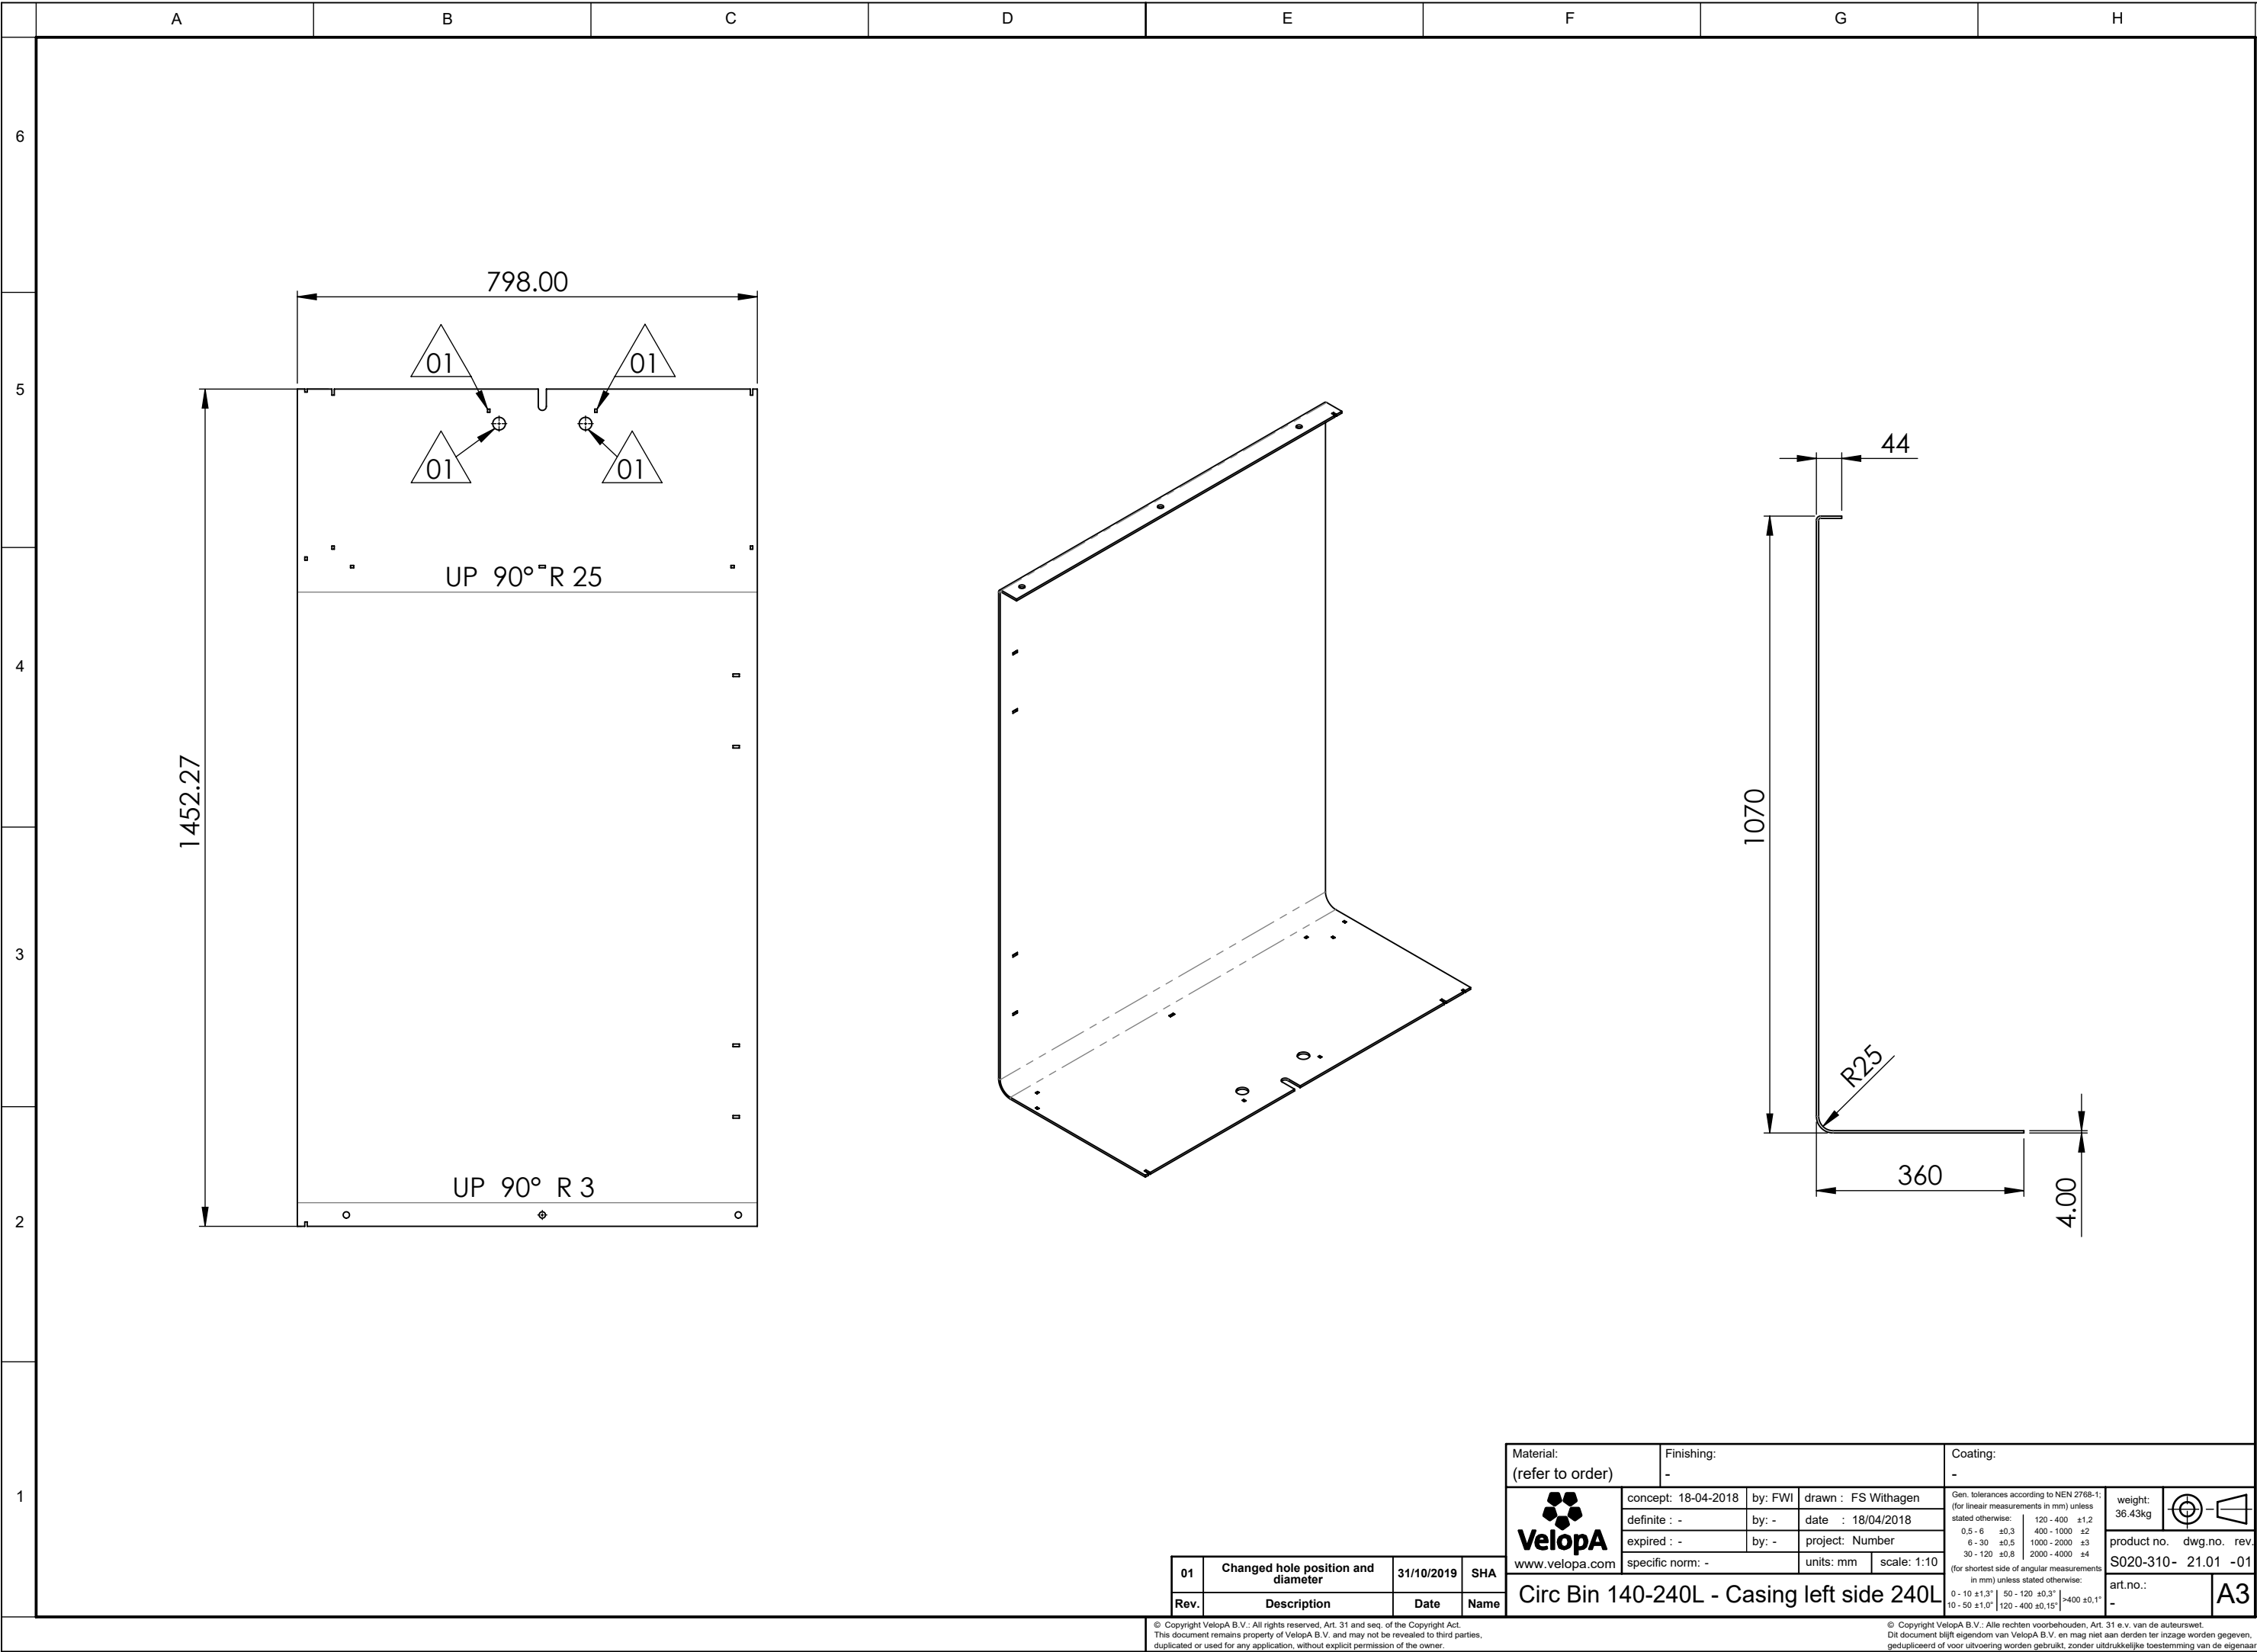

01	Changed hole position and diameter	31/10/2019	SHA
Rev.	Description	Date	Name

Material: (refer to order)		Finishing: -		Coating: -	
 VelopA www.velopa.com	concept: 18-04-2018	by: FWI	drawn : FS Withagen		
	definite : -	by: -	date : 18/04/2018		
	expired : -	project: Number		Gen. tolerances according to NEN 2768-1; (for linear measurements in mm) unless stated otherwise:	
	specific norm: -	units: mm	scale: 1:10	120 - 400 ±1.2 400 - 1000 ±2 1000 - 2000 ±3 2000 - 4000 ±4	
				(for shortest side of angular measurements in mm) unless stated otherwise: 0 - 10 ±1.3° 50 - 120 ±0.3° >400 ±0.1° 10 - 50 ±1.0° 120 - 400 ±0.15°	
		weight: 36.43kg			
		product no. S020-310-	dwg.no. 21.01		rev. -01
		art.no.: -			A3

P:\1- PO-ALGEMEEN --- PO-Projecten\PIB-403 Circ Bin 140x240L (Leiden)\M4 - Uitvoeringsfase\1. Technische Tekeningen\21.01-01 Circ Bin 140-240L - Casing left 240L