


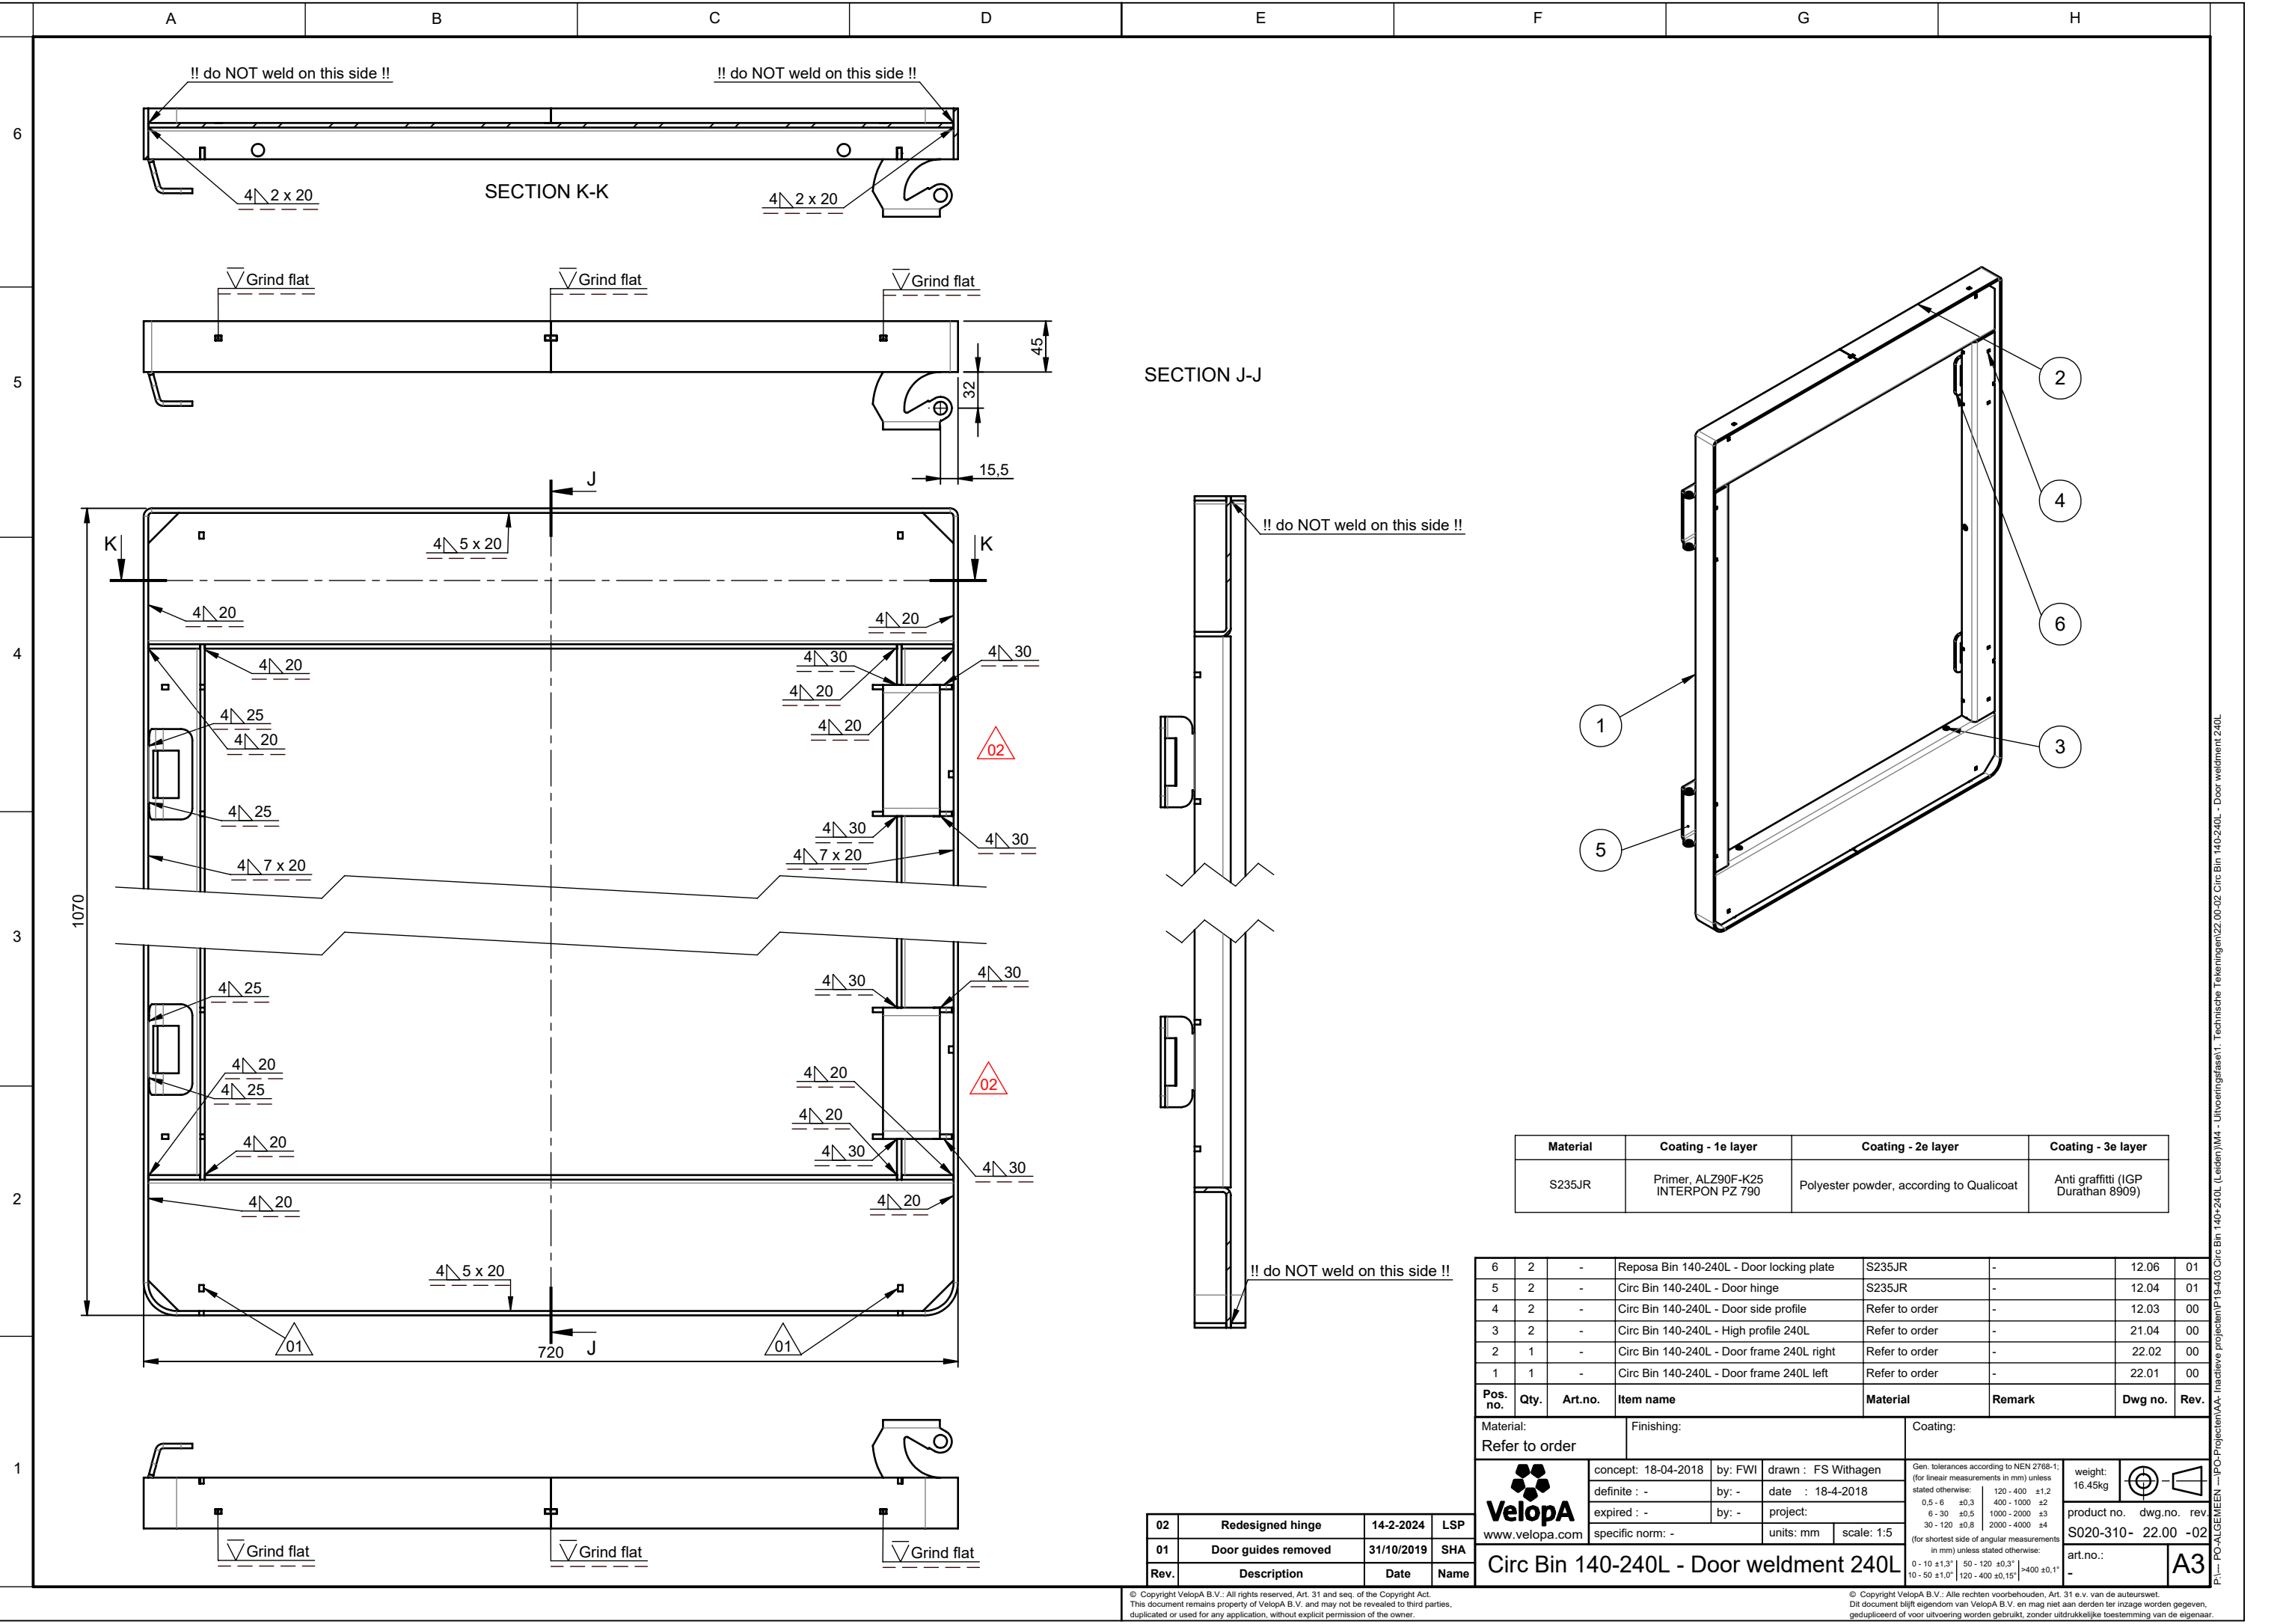

02	Redesigned hinge	14-2-2024	LSP
01	Door guides removed	31/10/2019	SHA
Rev.	Description	Date	Name

6	2	-	Reposa Bin 140-240L - Door locking plate	S235JR	-	12.06	01
5	2	-	Circ Bin 140-240L - Door hinge	S235JR	-	12.04	01
4	2	-	Circ Bin 140-240L - Door side profile	Refer to order	-	12.03	00
3	2	-	Circ Bin 140-240L - High profile 240L	Refer to order	-	21.04	00
2	1	-	Circ Bin 140-240L - Door frame 240L right	Refer to order	-	22.02	00
1	1	-	Circ Bin 140-240L - Door frame 240L left	Refer to order	-	22.01	00
Pos. no.	Qty.	Art.no.	Item name	Material	Remark	Dwg no.	Rev.
Material:			Finishing:		Coating:		
Refer to order							
		concept: 18-04-2018	by: FWI	drawn : FS Withagen		Gen. tolerances according to NEN 2768-1; (for linear measurements in mm) unless stated otherwise:	
Velopa		definite : -	by: -	date : 18-4-2018		weight: 16.45kg	
		expired : -	by: -	project:			
www.velopa.com		specific norm: -	units: mm		scale: 1:5	product no. dwg.no. rev.	
Circ Bin 140-240L - Door weldment 240L						S020-310- 22.00 - 02	
						art.no.:	
						A3	