


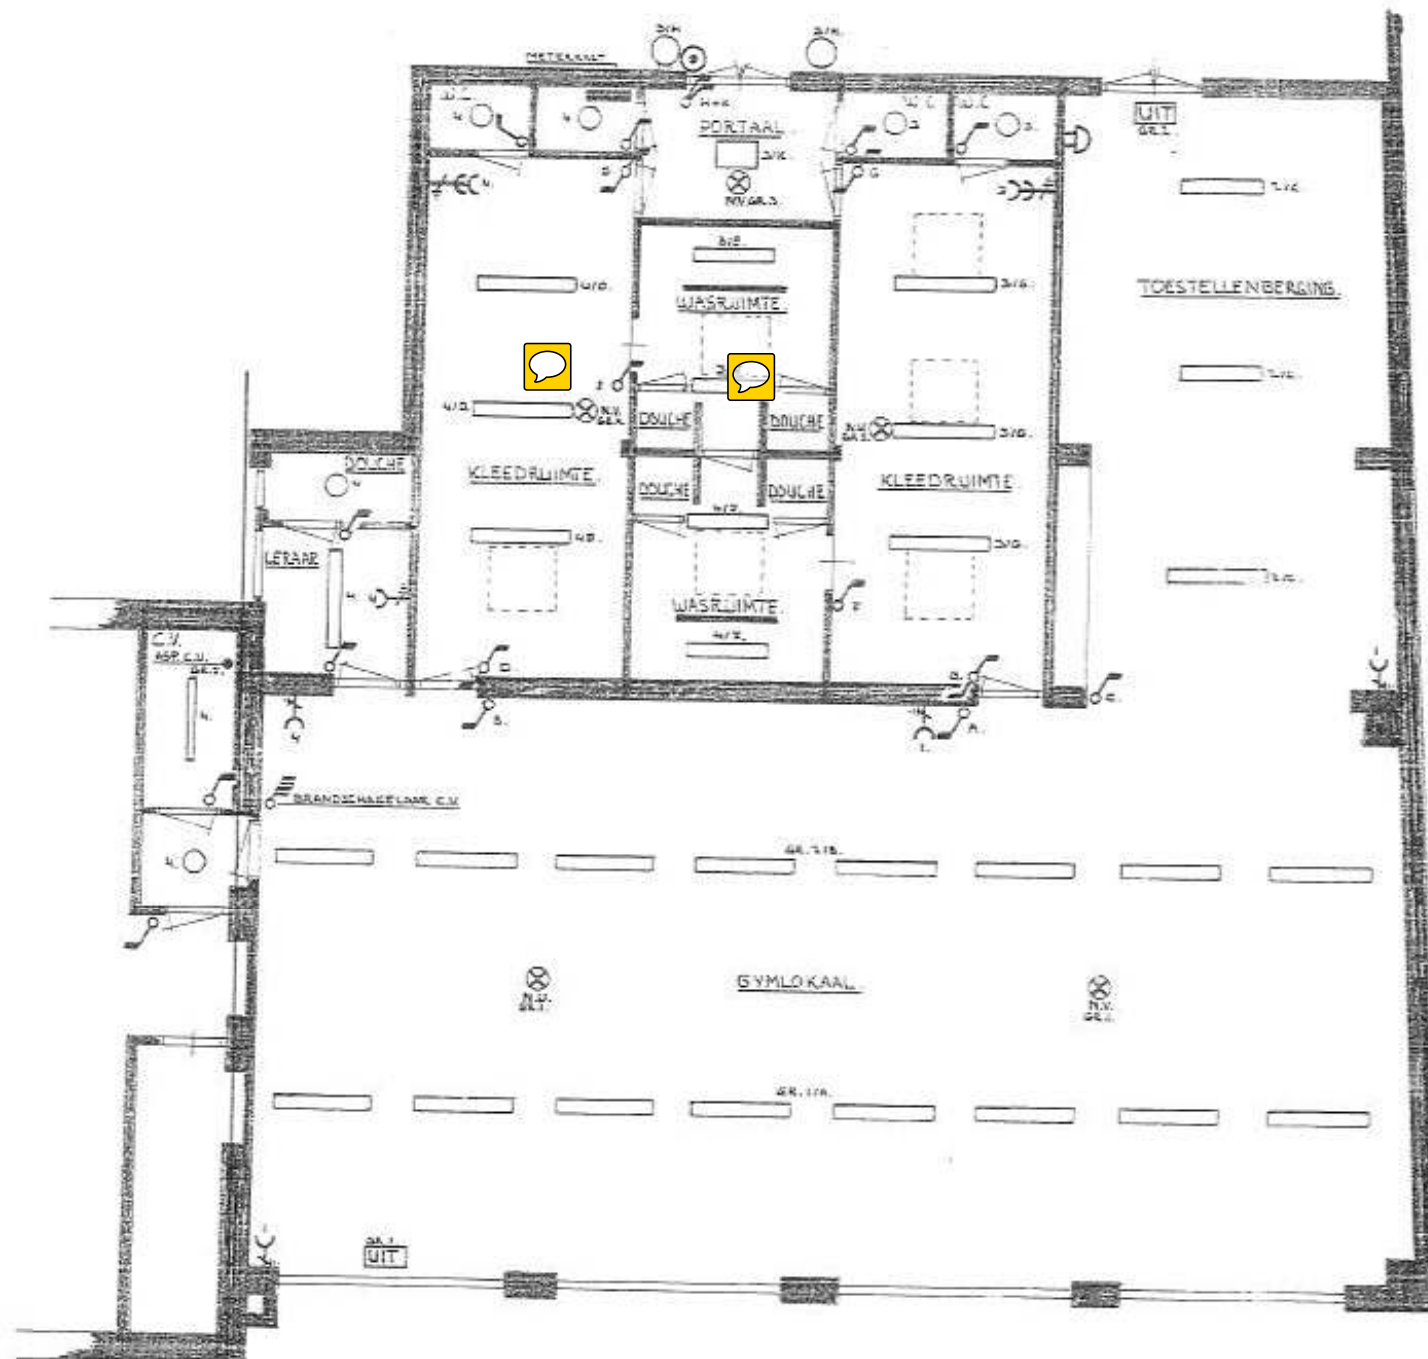

GYMZAAL BARTJENSSCHOOL

DP