


Boring 4

Dwarsprofiel

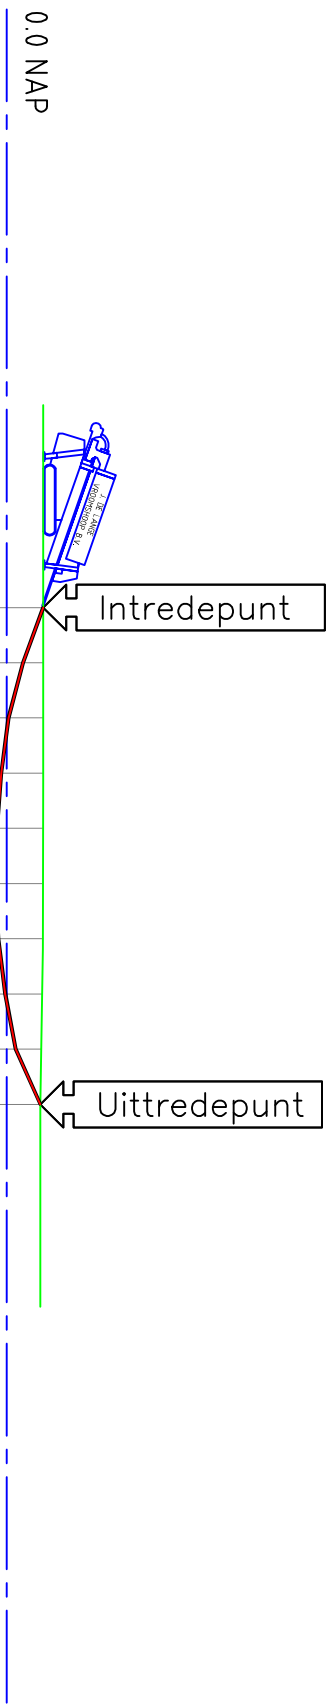

Hor. afstand t.o.v. Intredepunt (m)	0.0	3.0	6.0	9.0	12.0	15.0	18.0	21.0	24.0	27.0	
Hoogte Maaiveld t.o.v. NAP (m)	+2.0	+2.0	+2.0	+2.0	+2.0	+2.0	+2.0	+1.9	-1.9	+1.8	
Hartlijn Boring t.o.v. NAP (m)	+2.0	+0.9	+0.1	-0.2	-0.5	-0.6	-0.4	-0.1	+0.5	+1.8	
Hartlijn Boring t.o.v. Maaiveld (m)	0.0	-1.1	-1.9	-2.2	-2.5	-2.6	-2.4	-2.0	-1.4	0.0	
											Hartlijn Boring t.o.v. Maaiveld (m)