

Job Information

Name: zuidlaren onder plein door
Date: vr sep 13 11:15:15 2019
Operators:
Elevation Start: 0.00 m
Elevation End: 0.00 m
Heading: 262.0 degrees
GPS Start:
GPS End:
Bore Length: 69.52 m
Pipe Count: 24
Pipe Length: 3.02 m
First Pipe: 0.00 m
Last Pipe: 0.00 m
Comments:


Client Information

Name:
Phone:
Address:
City/Zip:


Contractor Information



Name:
Phone:
Address:
City/Zip:

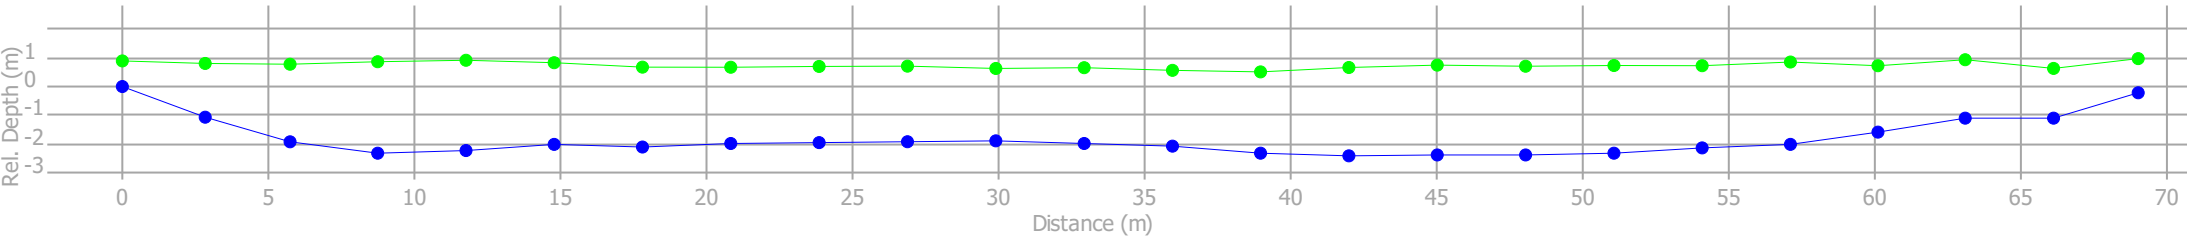

TSR Drill Report
zuidlaren onder plein door

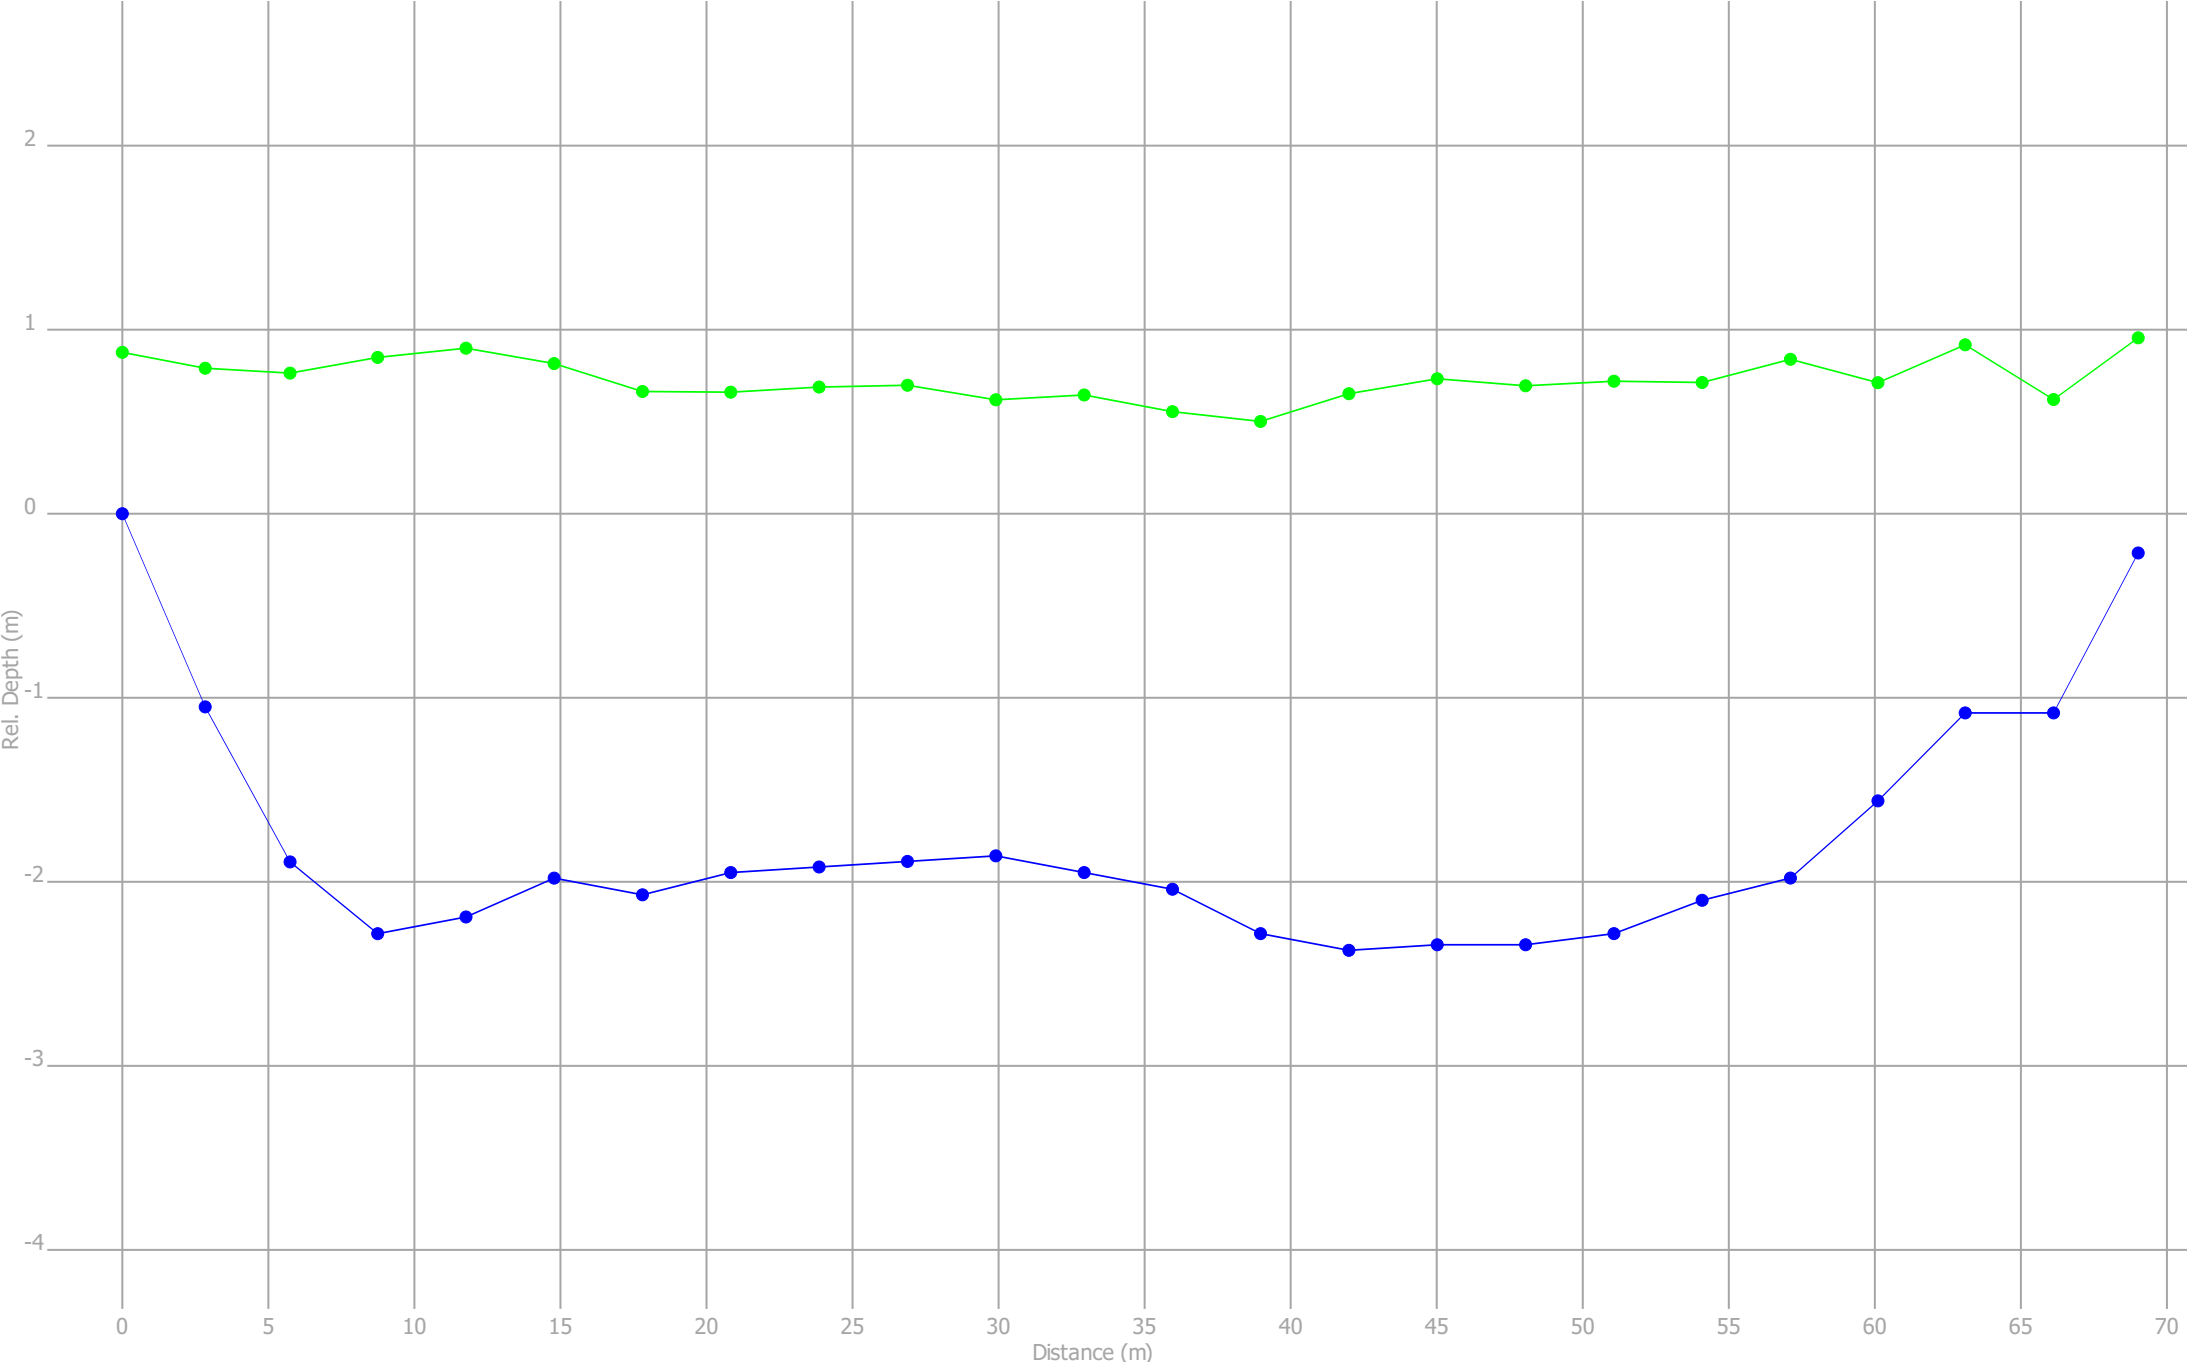

TSR Drill Report
zuidlaren onder plein door

Pipe List

Drill Pipe	Distance (m)	Pitch (%)	Depth (m)	GPS Latitude	GPS Longitude	GPS Elevation (m)	Heading (degrees)	Comments
✓ 1	0.00	-35.0	0.88	0.00000000	0.00000000	0.00	262.0	✓
✓ 2	2.83	-37.0	1.84	0.00000000	0.00000000	0.00	266.0	✓
✓ 3	5.74	-29.0	2.65	0.00000000	0.00000000	0.00	264.0	✓
✓ 4	8.74	-13.0	3.13	0.00000000	0.00000000	0.00	263.0	✓
✓ 5	11.76	3.0	3.09	0.00000000	0.00000000	0.00	265.0	✓
✓ 6	14.77	7.0	2.79	0.00000000	0.00000000	0.00	264.0	✓
✓ 7	17.79	-3.0	2.73	0.00000000	0.00000000	0.00	264.0	✓
✓ 8	20.81	4.0	2.61	0.00000000	0.00000000	0.00	267.0	✓
✓ 9	23.84	1.0	2.61	0.00000000	0.00000000	0.00	264.0	✓
✓ 10	26.86	1.0	2.59	0.00000000	0.00000000	0.00	265.0	✓
✓ 11	29.88	1.0	2.48	0.00000000	0.00000000	0.00	264.0	✓
✓ 12	32.90	-3.0	2.59	0.00000000	0.00000000	0.00	263.0	✓
✓ 13	35.92	-3.0	2.59	0.00000000	0.00000000	0.00	259.0	✓
✓ 14	38.94	-8.0	2.78	0.00000000	0.00000000	0.00	254.0	✓
✓ 15	41.96	-3.0	3.02	0.00000000	0.00000000	0.00	258.0	✓
✓ 16	44.98	1.0	3.07	0.00000000	0.00000000	0.00	254.0	✓
✓ 17	48.00	0.0	3.04	0.00000000	0.00000000	0.00	269.0	✓
✓ 18	51.02	2.0	3.00	0.00000000	0.00000000	0.00	260.0	✓
✓ 19	54.04	6.0	2.81	0.00000000	0.00000000	0.00	265.0	✓
✓ 20	57.06	4.0	2.82	0.00000000	0.00000000	0.00	266.0	✓
✓ 21	60.05	14.0	2.27	0.00000000	0.00000000	0.00	271.0	✓
✓ 22	63.04	16.0	2.00	0.00000000	0.00000000	0.00	249.0	✓
✓ 23	66.06	0.0	1.70	0.00000000	0.00000000	0.00	252.0	✓
✓ 24	68.96	30.0	1.17	0.00000000	0.00000000	0.00	256.0	✓

Subsite Secured

Subsite Tracking Data Integrity

✓ = Original Tracking Not Changed

Δ = Data revised. See comment for explanation