



Dwarsprofiel schaal 1:500

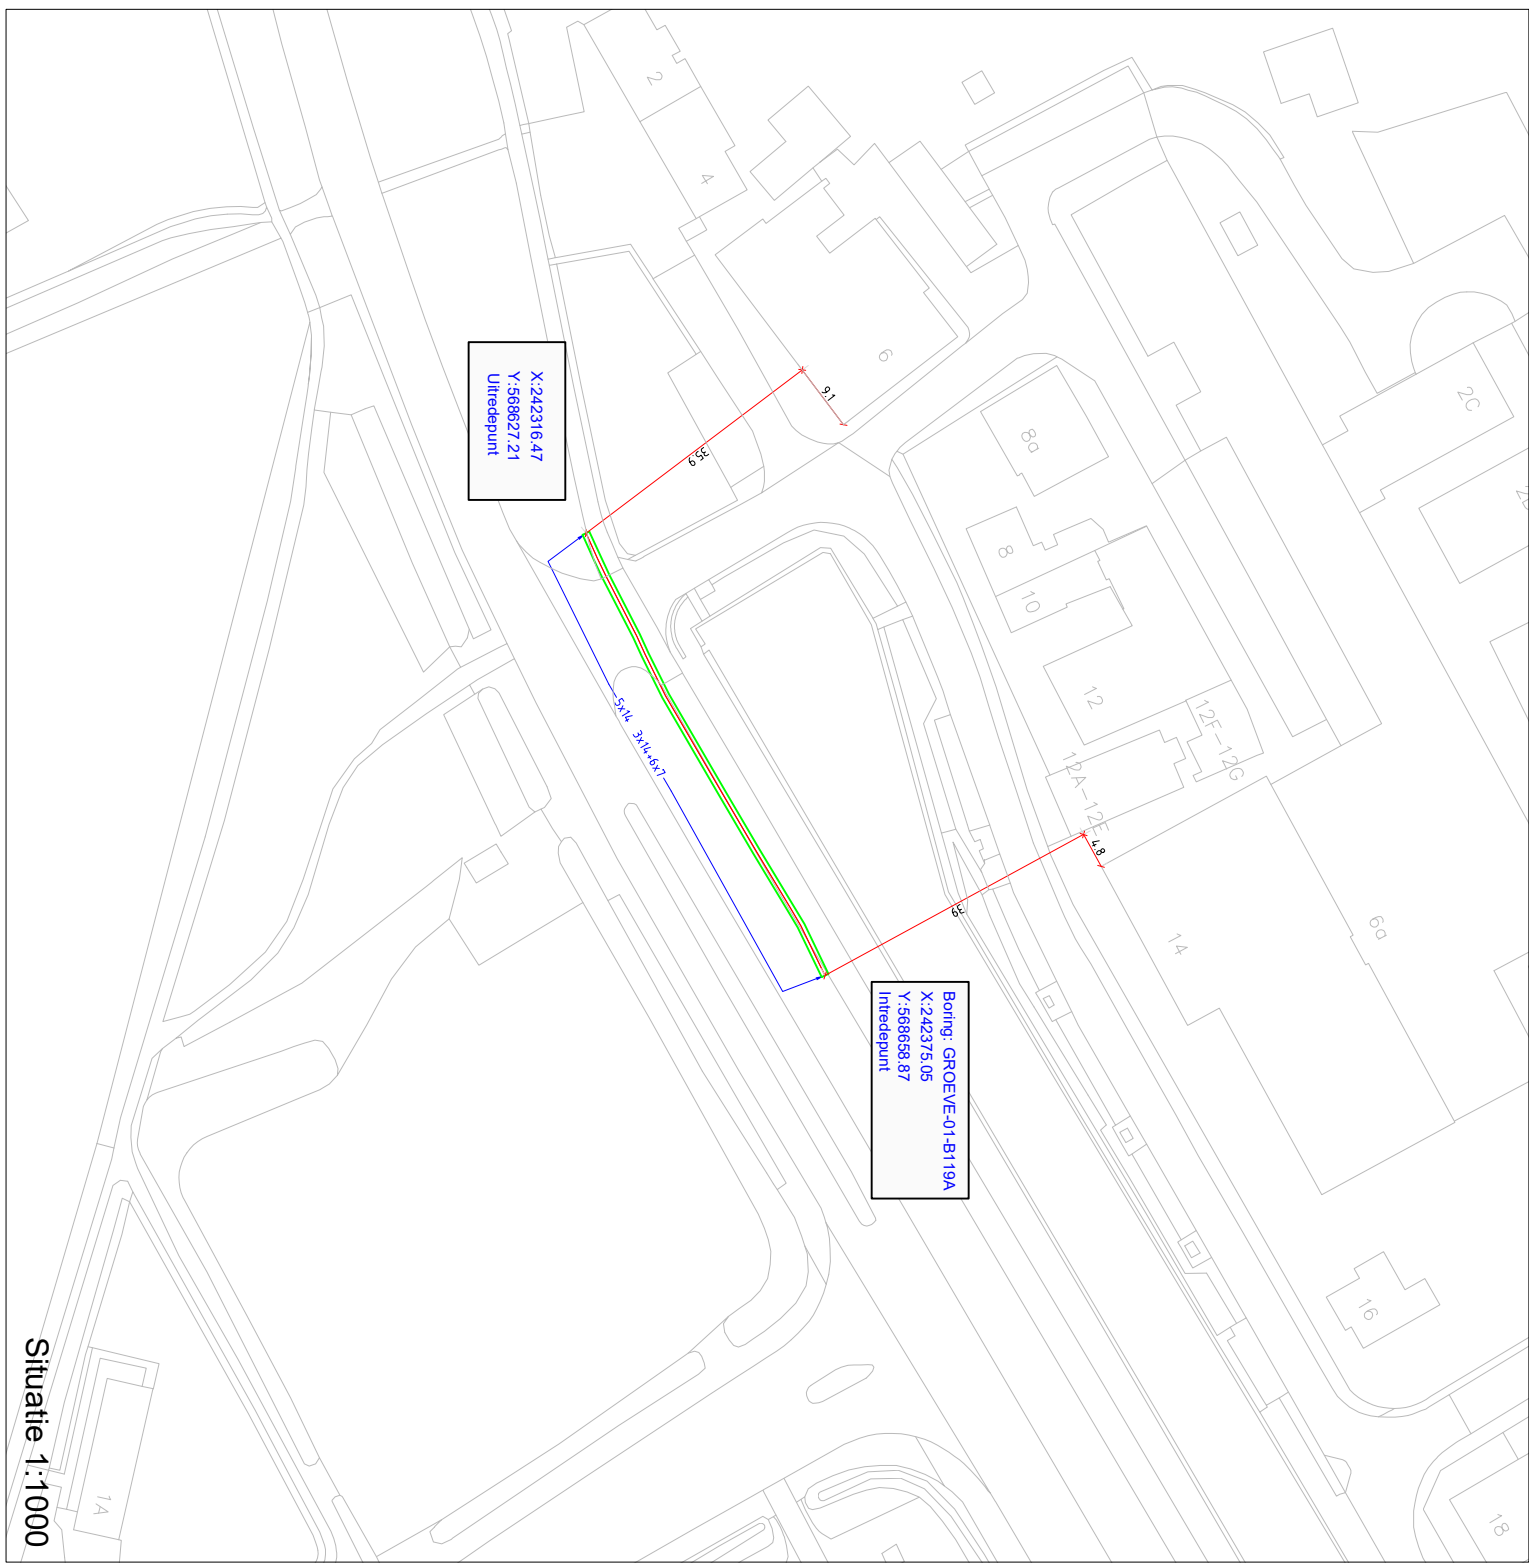

5x14mm 3x14mm 6x7mm



Dwarsdoorsnede A

Datum:	Pac.	Control:	Wijziging:
.....			
.....			
.....			
.....			
.....			
.....			
.....			
.....			
.....			
.....			
.....			

Projectnaam :	CJF Glasvezelbuiteren Drenthe
Adres :	Havenstraat 12 Zuidlaren
Schaal:	1:500 en 1:1.000
Formaat:	A3

Biednummer:	GROENE-01-B119A	T ekeningssoort:	Boorprofiel