



Boring: GROEVE-01-B002

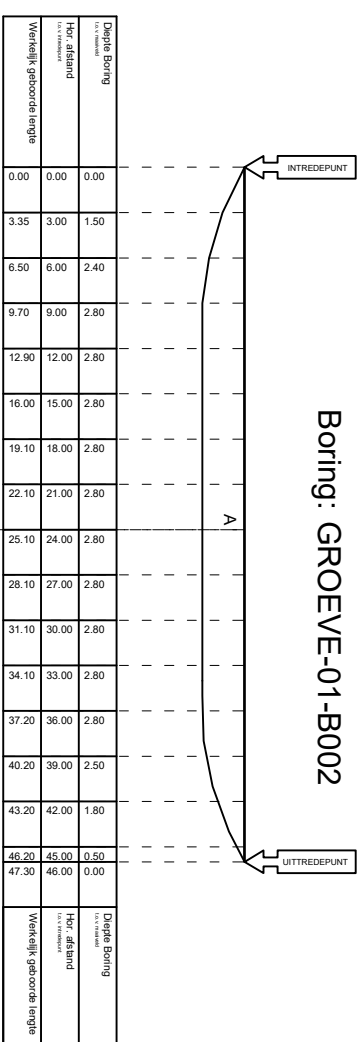

Dwarsprofiel schaal 1:500

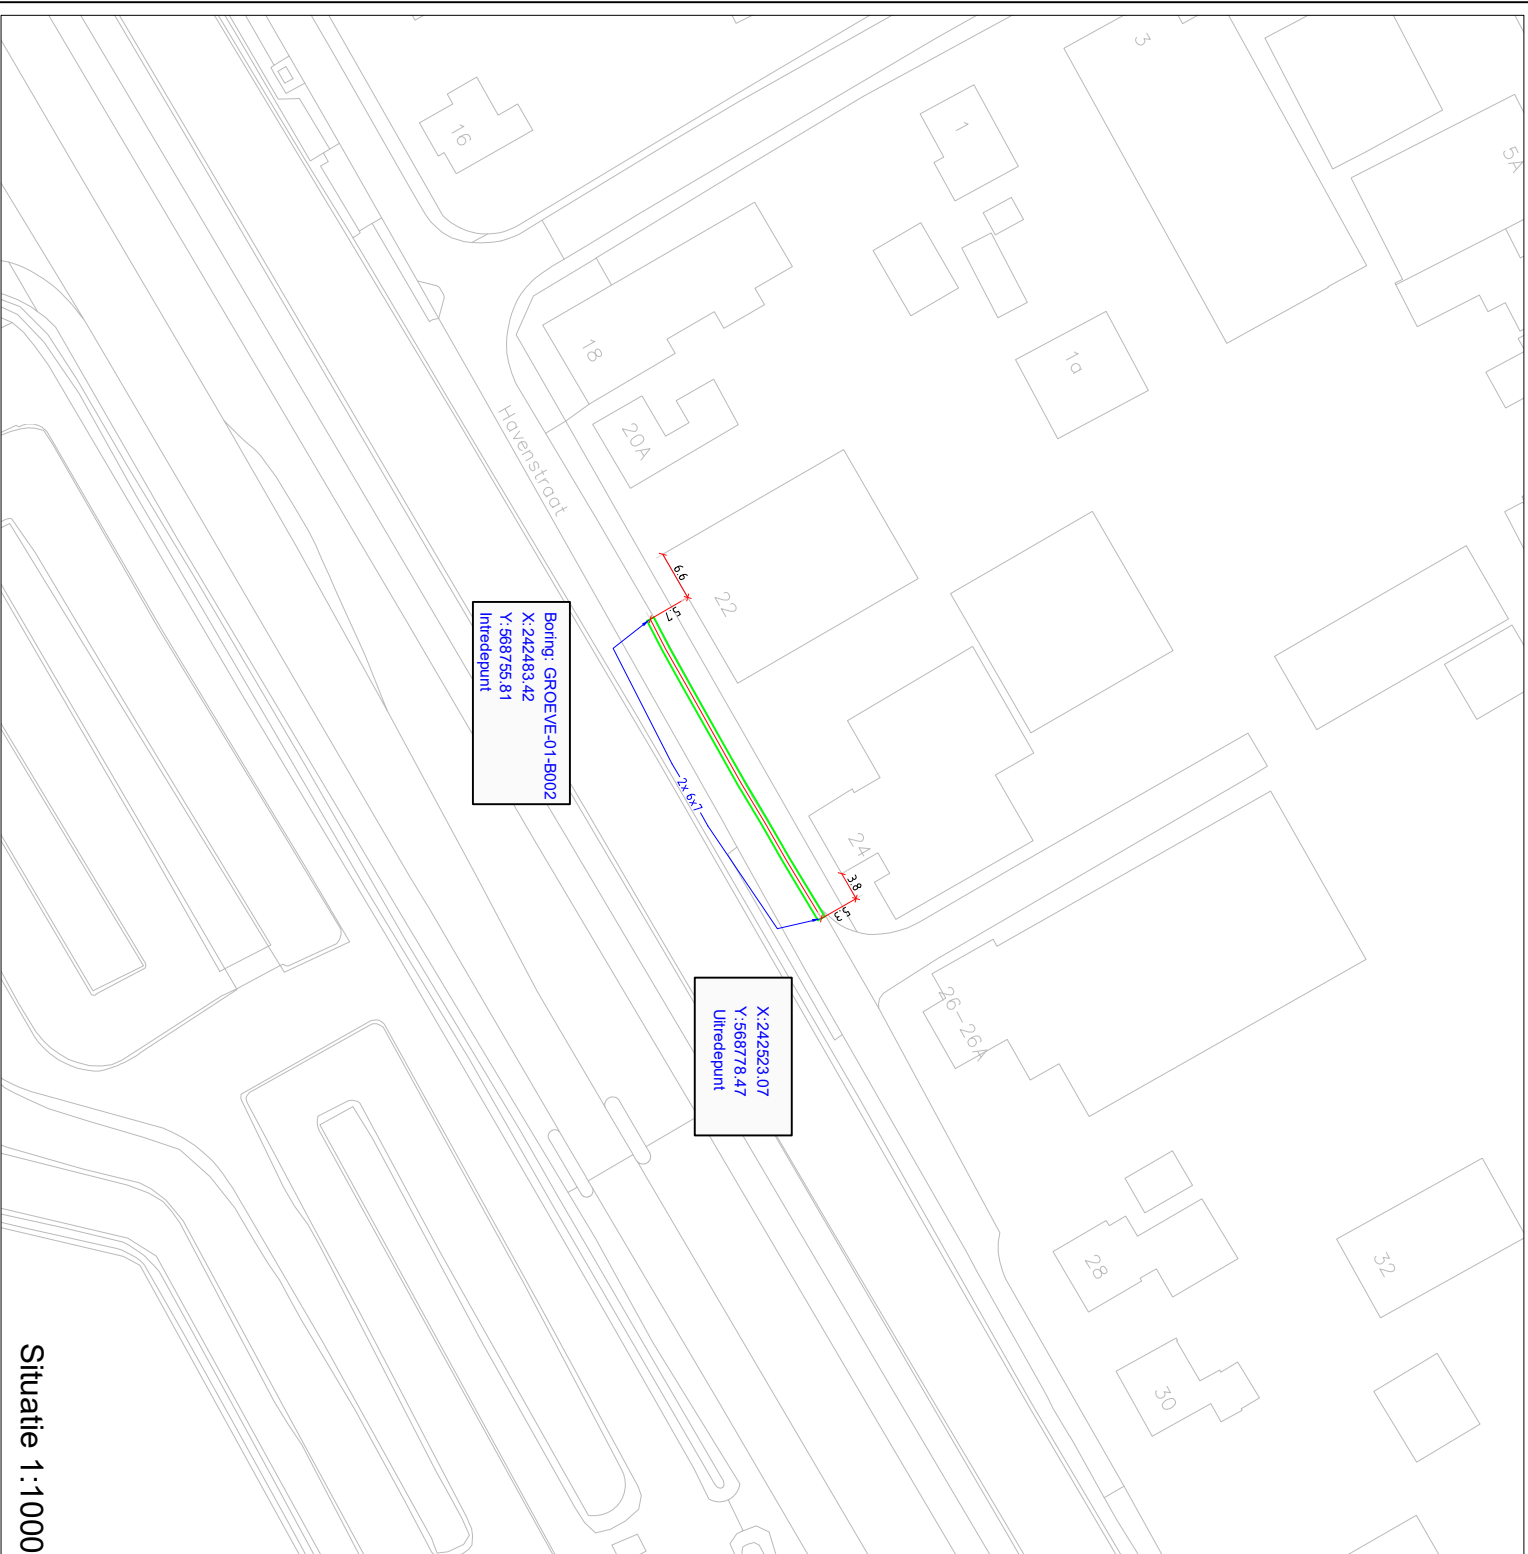

## Dwarsdoorsnede A



|            |            |            |            |                               |   |
|------------|------------|------------|------------|-------------------------------|---|
| Datum:     | Par.:      | Control:   | Wijziging: | Projectnaam :                 | Overname is zonder schriftelijke toestemming van Ailing niet geoorloofd. auteursrecht voorbehouden. |
| 11-01-2011 | 11-01-2011 | 11-01-2011 | 11-01-2011 | CIF Glasvezelbuislief Dienthe |   |
| 11-01-2011 | 11-01-2011 | 11-01-2011 | 11-01-2011 | Adres :                       |   |
| 11-01-2011 | 11-01-2011 | 11-01-2011 | 11-01-2011 | Havenstraat 22                |   |
| 11-01-2011 | 11-01-2011 | 11-01-2011 | 11-01-2011 | Plaats :                      |   |
| 11-01-2011 | 11-01-2011 | 11-01-2011 | 11-01-2011 | Zuidlaan                      |   |
| 11-01-2011 | 11-01-2011 | 11-01-2011 | 11-01-2011 | Schaal: 1:500 en 1:1.000      |   |
| 11-01-2011 | 11-01-2011 | 11-01-2011 | 11-01-2011 | Formaat: A3                   |   |
| 11-01-2011 | 11-01-2011 | 11-01-2011 | 11-01-2011 | Project nr Ailing :           |   |
| 11-01-2011 | 11-01-2011 | 11-01-2011 | 11-01-2011 | SCID nr Hoofddiket :          |   |
| 11-01-2011 | 11-01-2011 | 11-01-2011 | 11-01-2011 | B002                          |   |
| 11-01-2011 | 11-01-2011 | 11-01-2011 | 11-01-2011 | H86600                        |   |

### Situatie 1:1000