


Diagram of Boring: GROEVE-01-B003. The diagram shows a vertical profile with depth markers (0, 10, 20, 689


Dwarsprofiel schaal 1:500

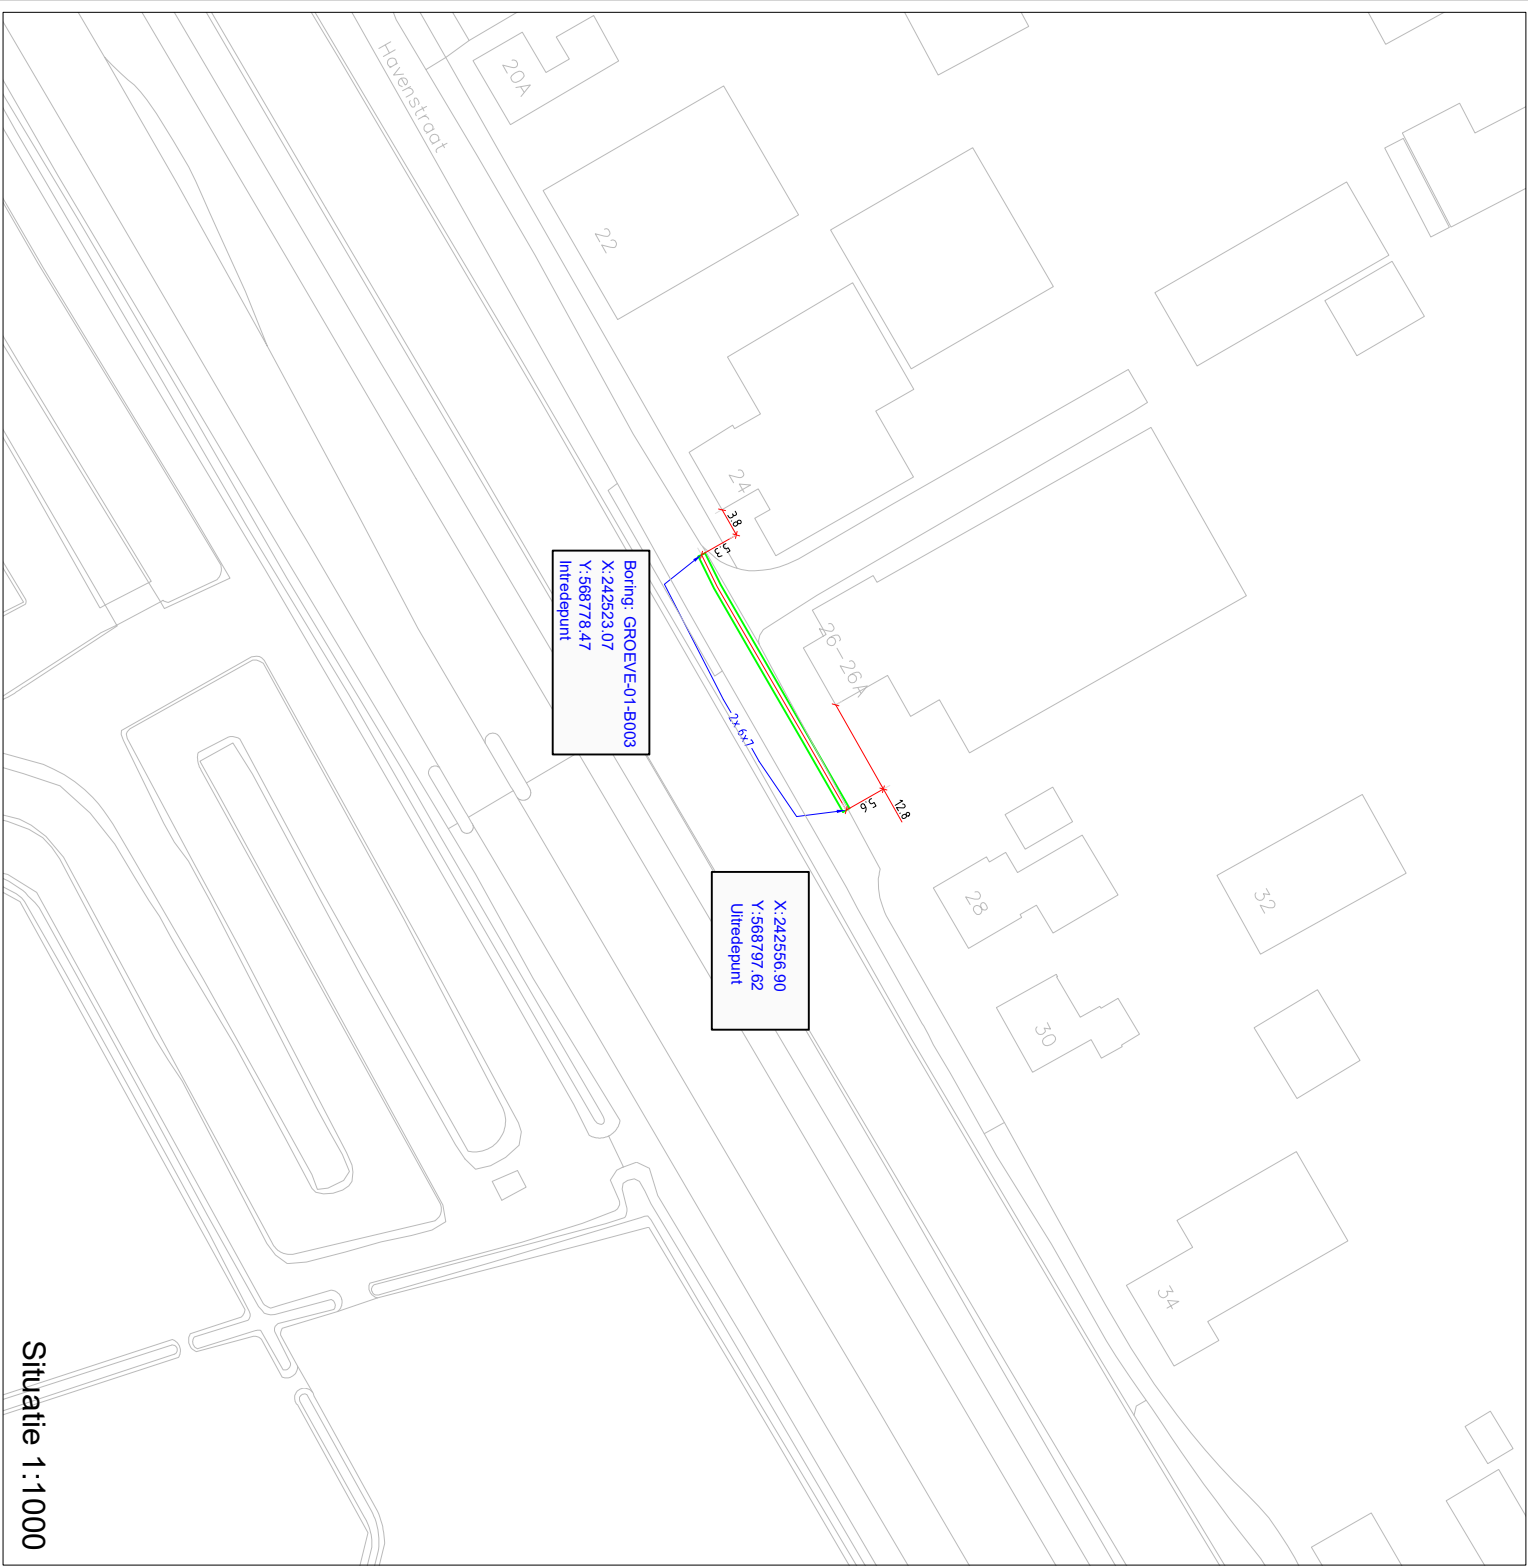

Dwarsdoorsnede A

[illegible]