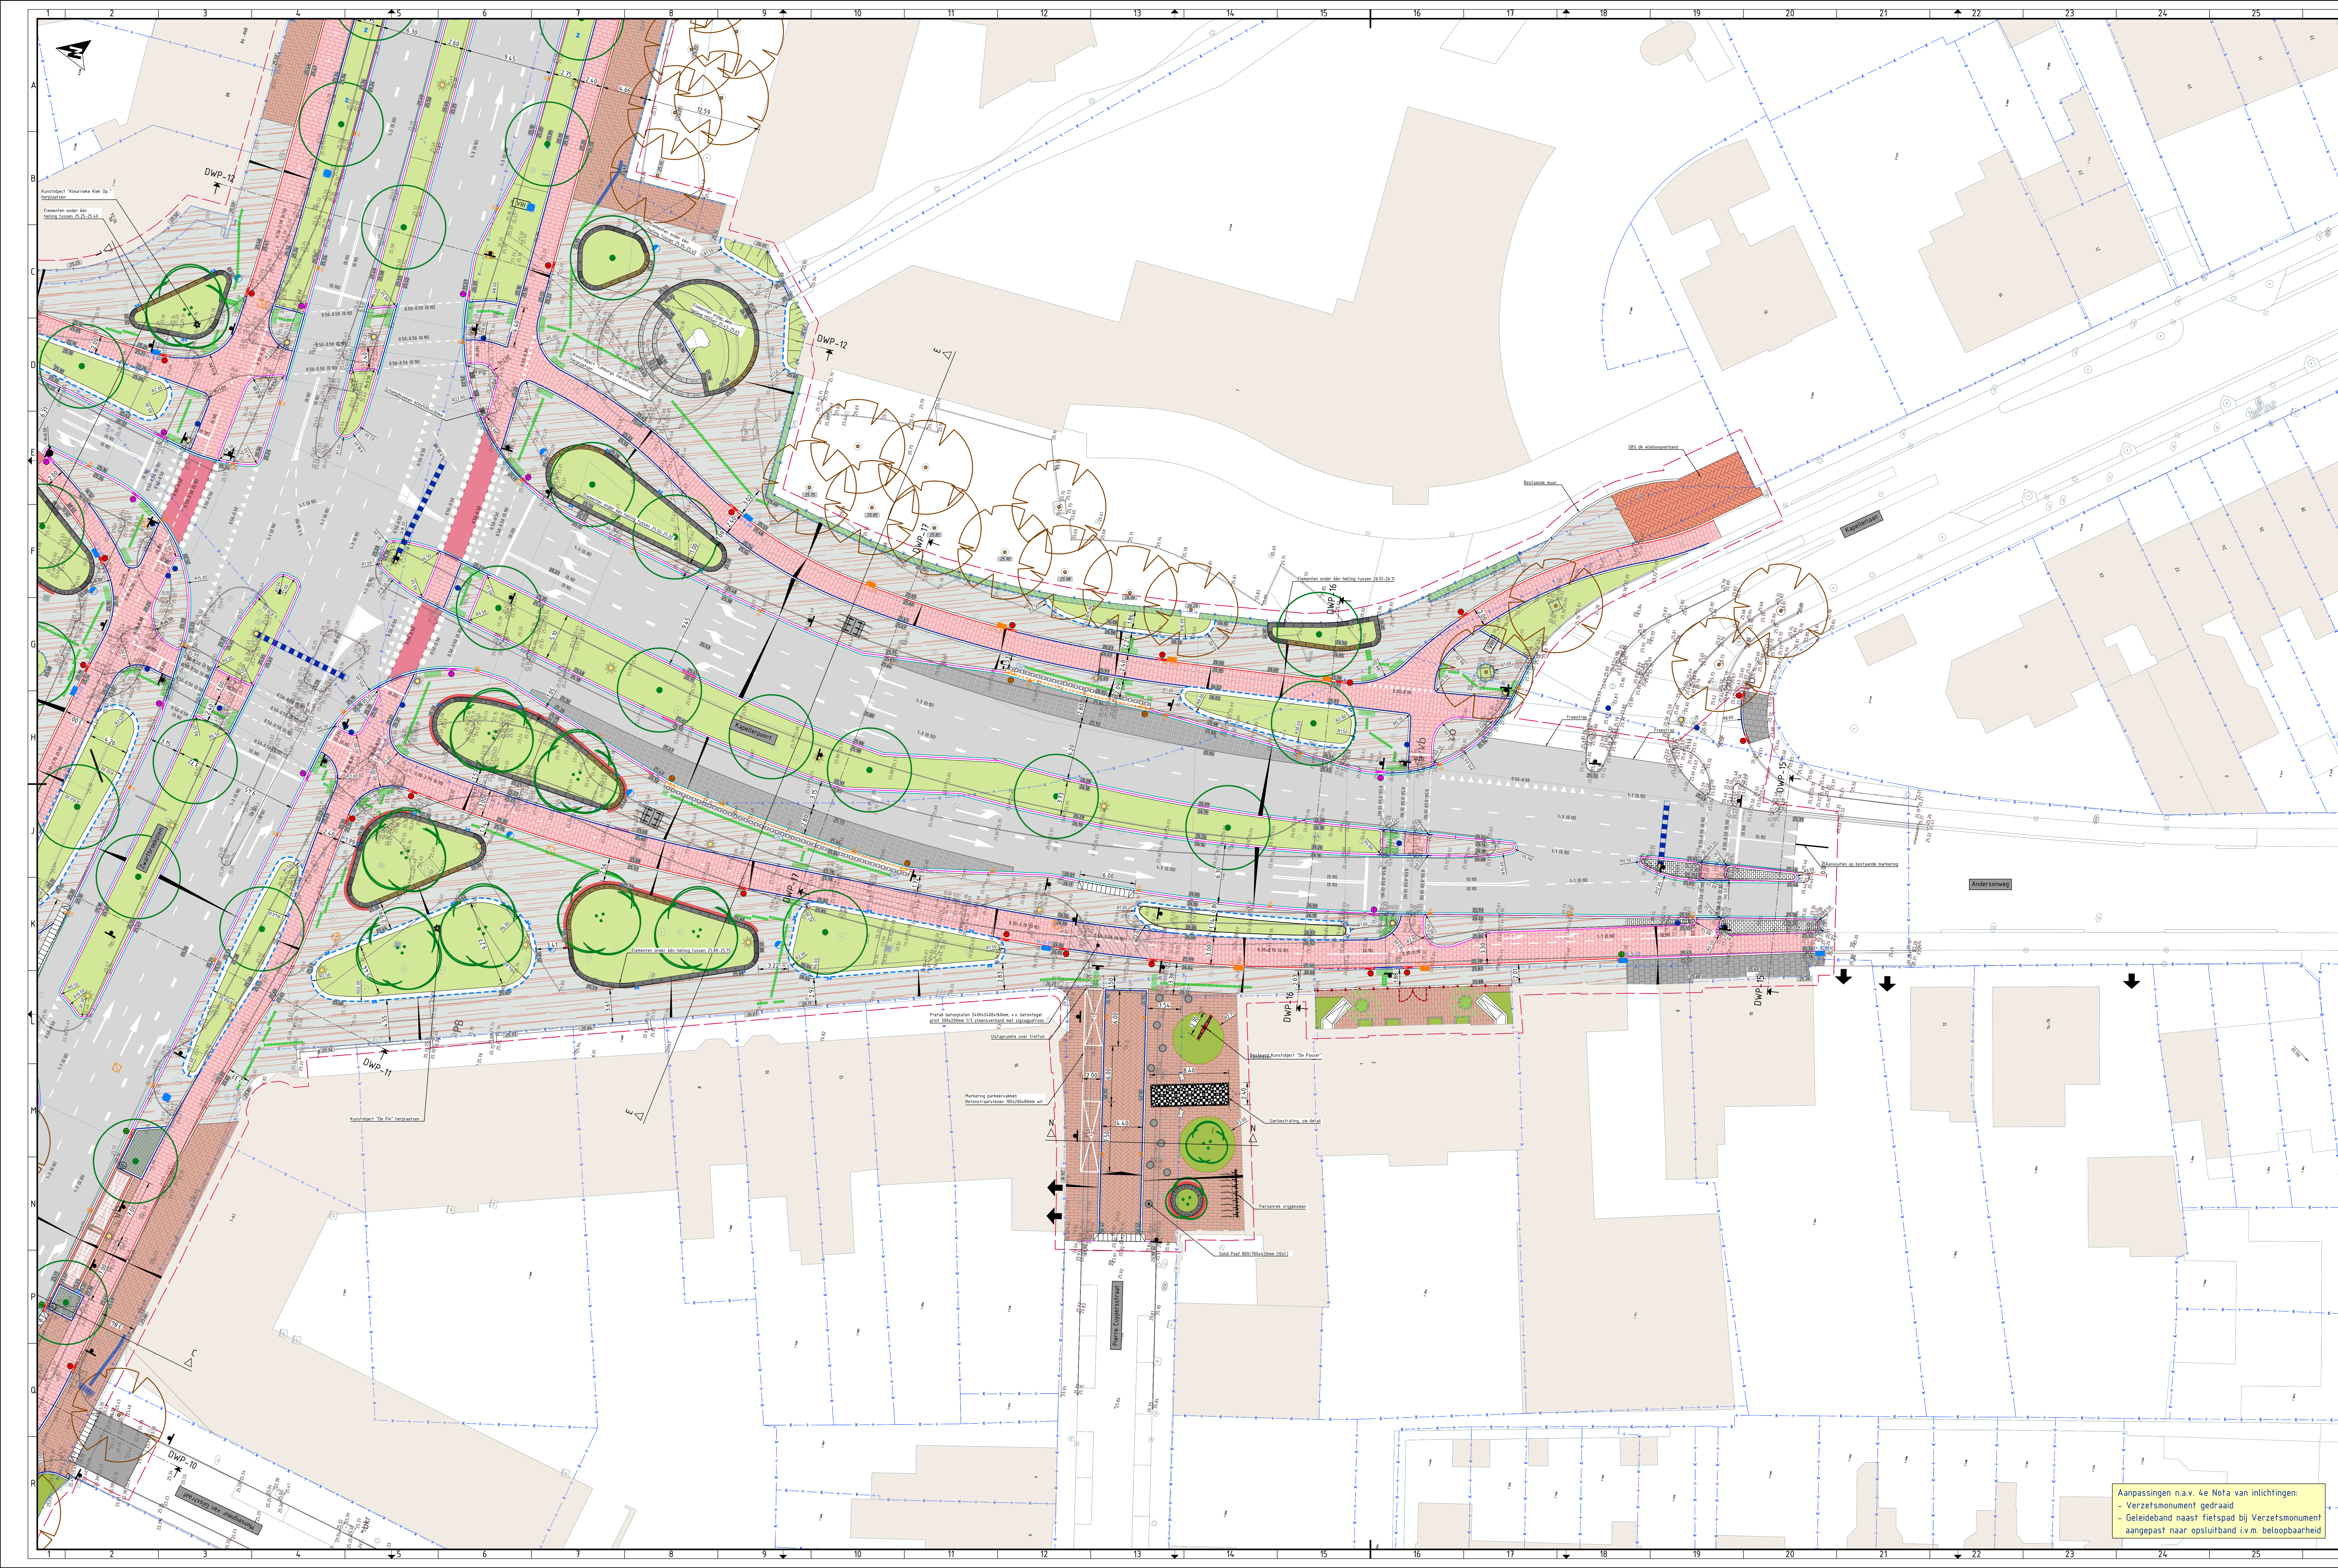
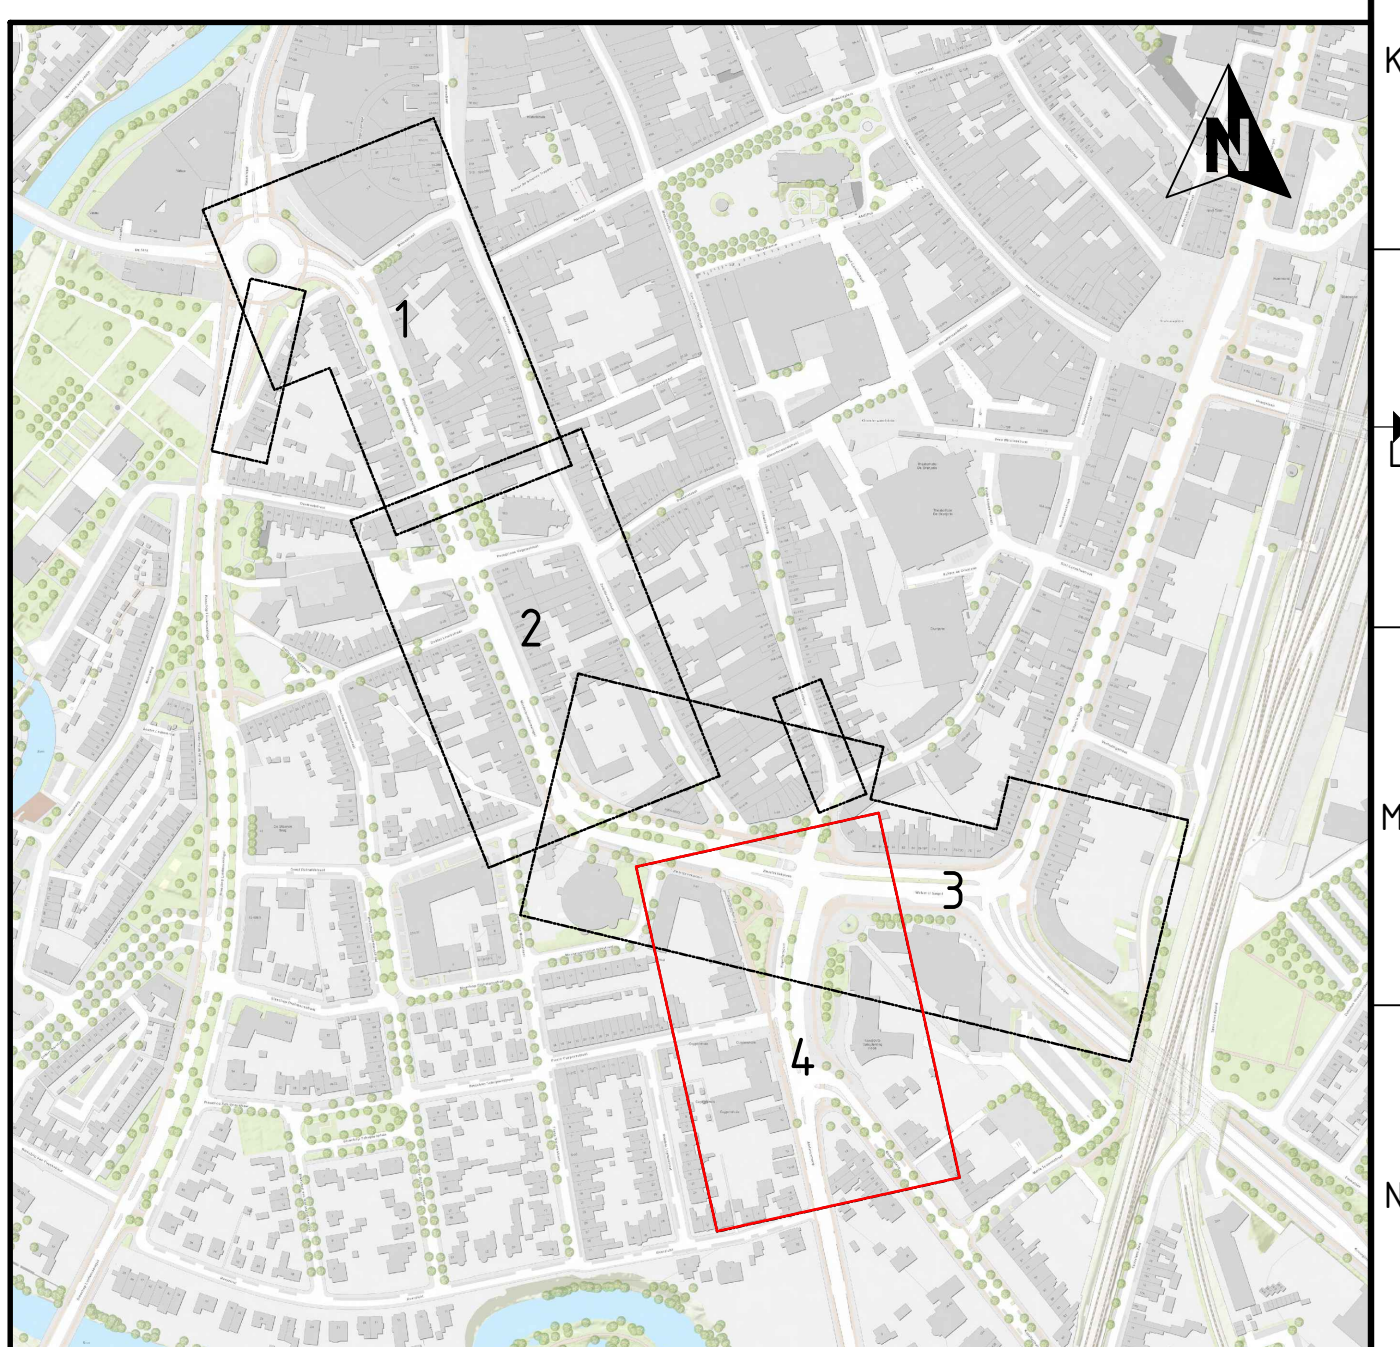


[illegible]

9	17-06-2025	Behorende bij 4e NVI	RJO	JHE	JHE	JHE	
8	23-05-2025	Aanpassing tekening n.a.v. 2e NVI	FBE	JHE	JHE	JHE	
7	24-04-2025	Behorende bij bestek d.d. 24-04-2025	FBE	JHE	JHE	JHE	
6	31-03-2025	Behorende bij bestek d.d. 31-03-2025	FBE	JHE	JHE	JHE	
5	24-02-2025	Concept bestek v1	FBE	JHE	JHE	JHE	
4	20-12-2024	Conceptplanning 5	GLO	JHE	JHE	JHE	
3	05-11-2024	Conceptplanning 4	FBE	JHE	JHE	JHE	
2	21-10-2024	Conceptplanning 3	FBE	JHE	JHE	JHE	
1	18-09-2024	Conceptplanning 2	FBE	JHE	JHE	JHE	
0	14-08-2024		FBE	JHE	JHE	JHE	
Versie	Datum	Omschrijving	Opsteller	Par	Verifieer	Par	Valideer

Singelring fase 3

Onderdeel
Situatie bovengrond blad 4

Opdrachtgever
Gemeente Roermond

Fate	F
Restek	F

Formaat
A0-841x1470

Schaal	8
1: 200	2

[illegible]

4

Projectnummer
ROF439

Tekeringnummer
2024-1803

2025-ROE439-B-001

28	
----	--

krachten



9 | 30

- Verzetmonument gedraaid
- Geleideband naast fietspad bij Verzetmonument aangepast naar opsluitband i.v.m. beloopbaarheid