


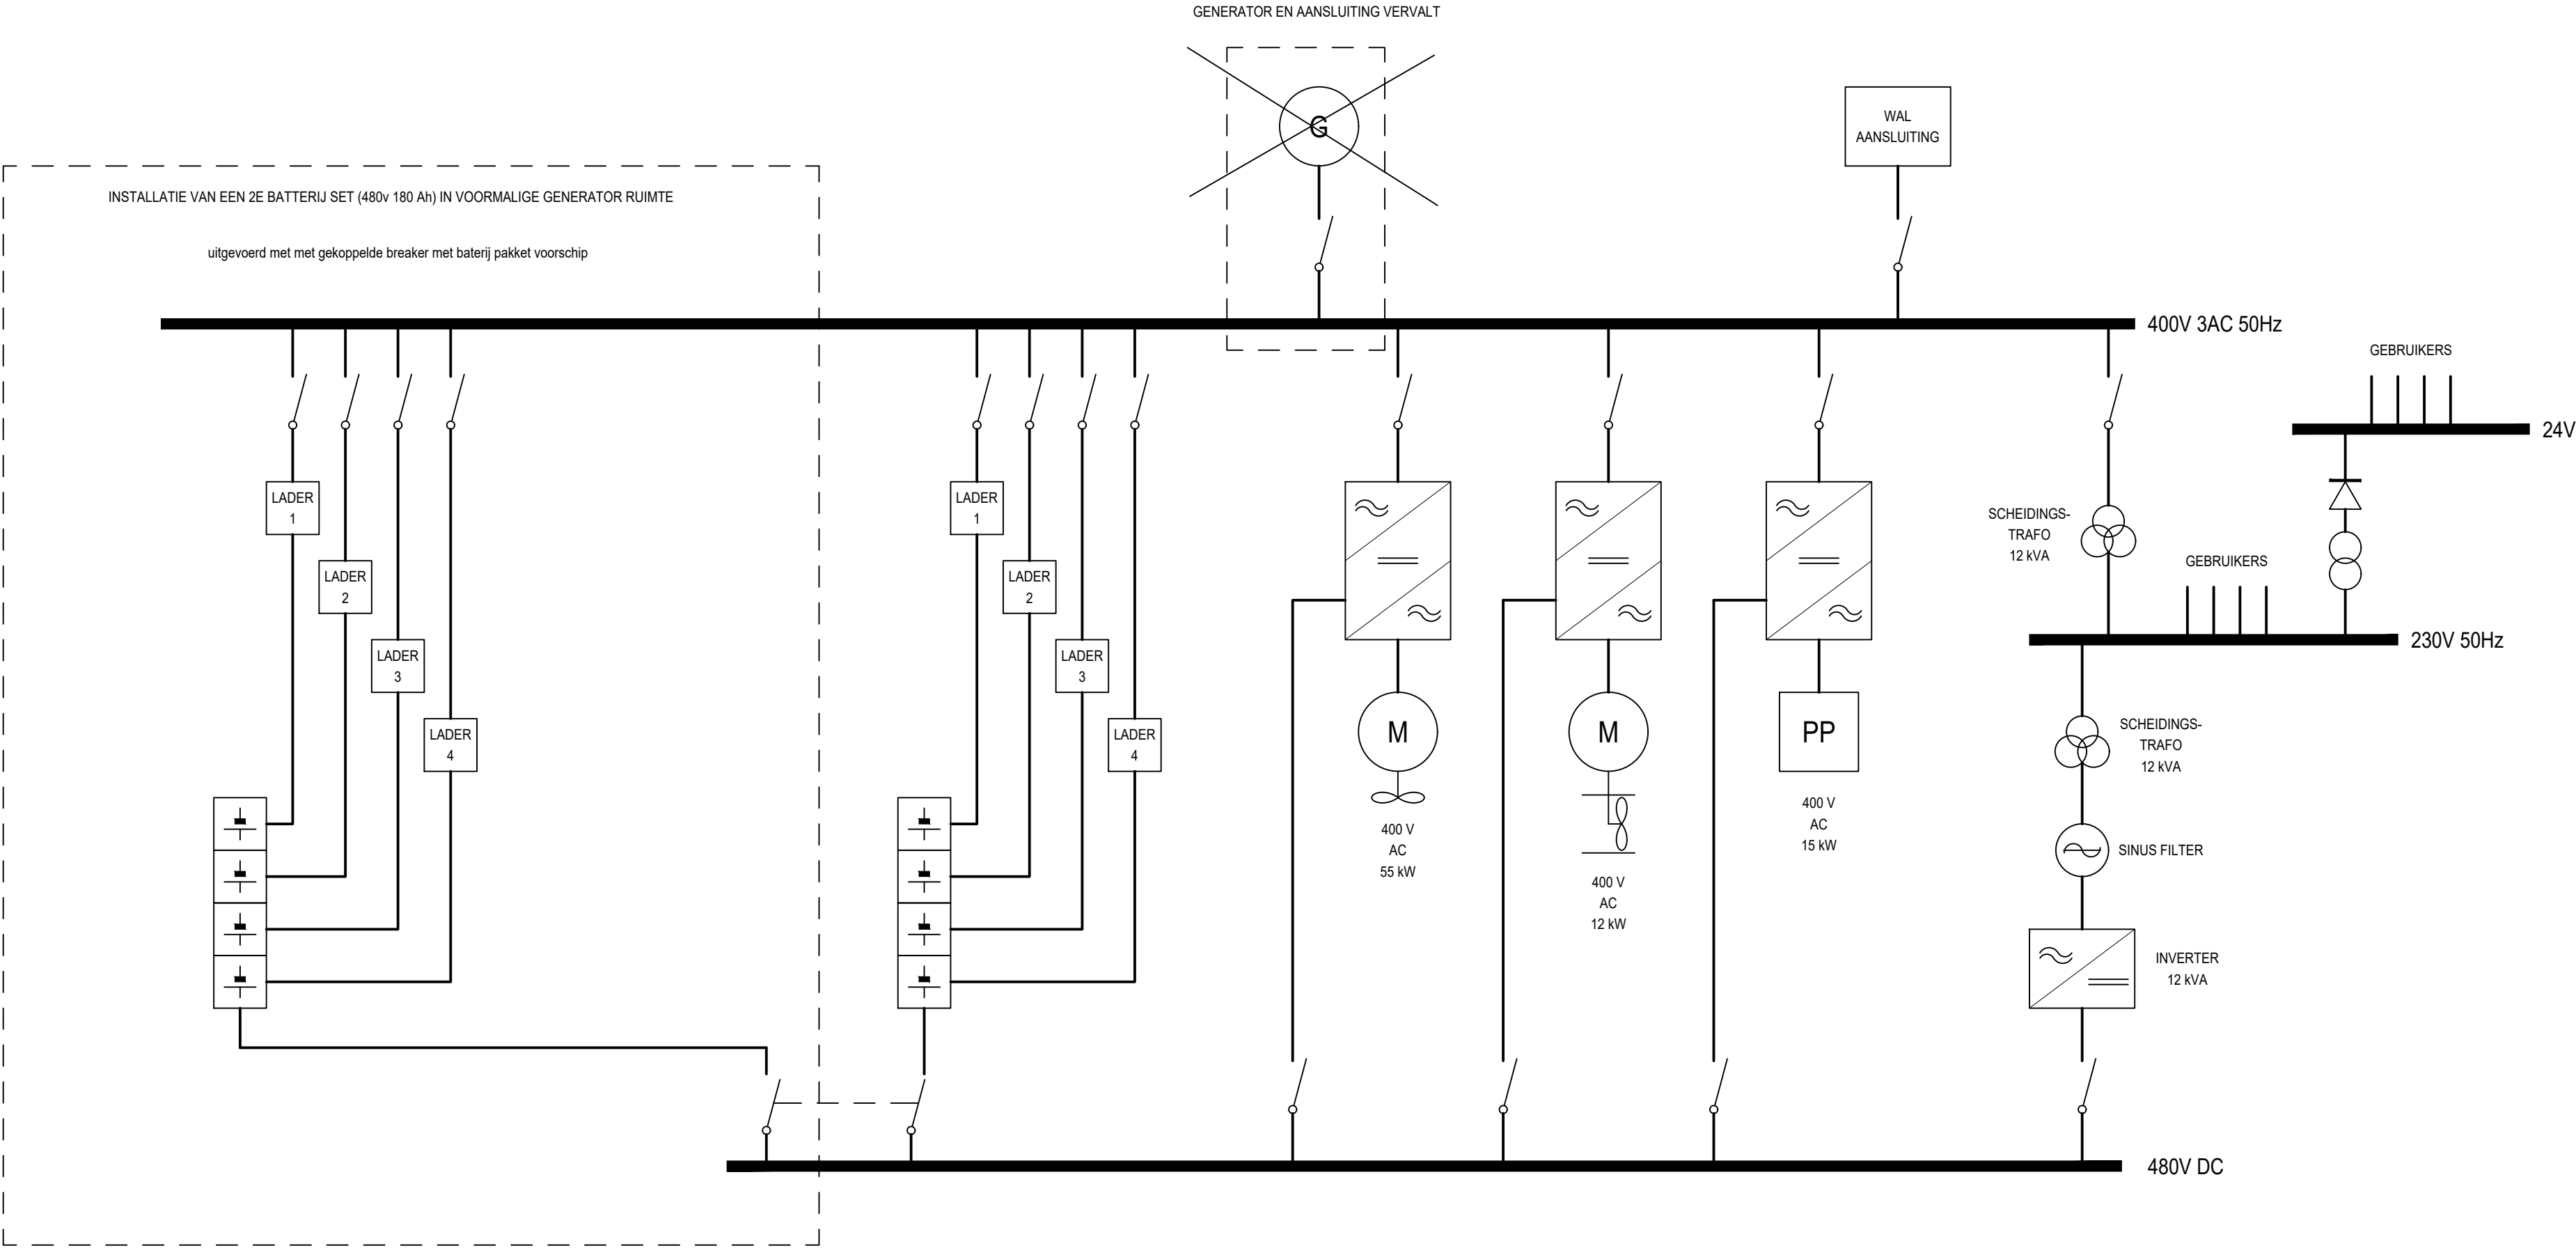

00	20-feb-2024	Verbouwing naar volledig emissie loos vaartuig			
REV.	DATE	REMARKS	DRAWN	CHECK	APPR.
VUYK ENGINEERING			P.O.Box 4002, 3006 AA Rotterdam Phone: +31 (0)10 312 6400 vuyk@vuykrotterdam.com www.vuykrotterdam.com		
DIAGRAM ELEKTRISCHE INSTALLATIE NA VERBOUWING Verbouwing Stroomboot en Ecoboot					
Principal: Stadswerken Gemeente Utrecht			Scale	-	
					
Proj.	23280	Dwg.	015.101	Nr. of Sh. 1	Format A2
NOTICE: This drawing and the information it contains are the property of VUYK ENGINEERING ROTTERDAM and may not be reproduced or used in part or in whole for any purpose except by written permission of this company.					