


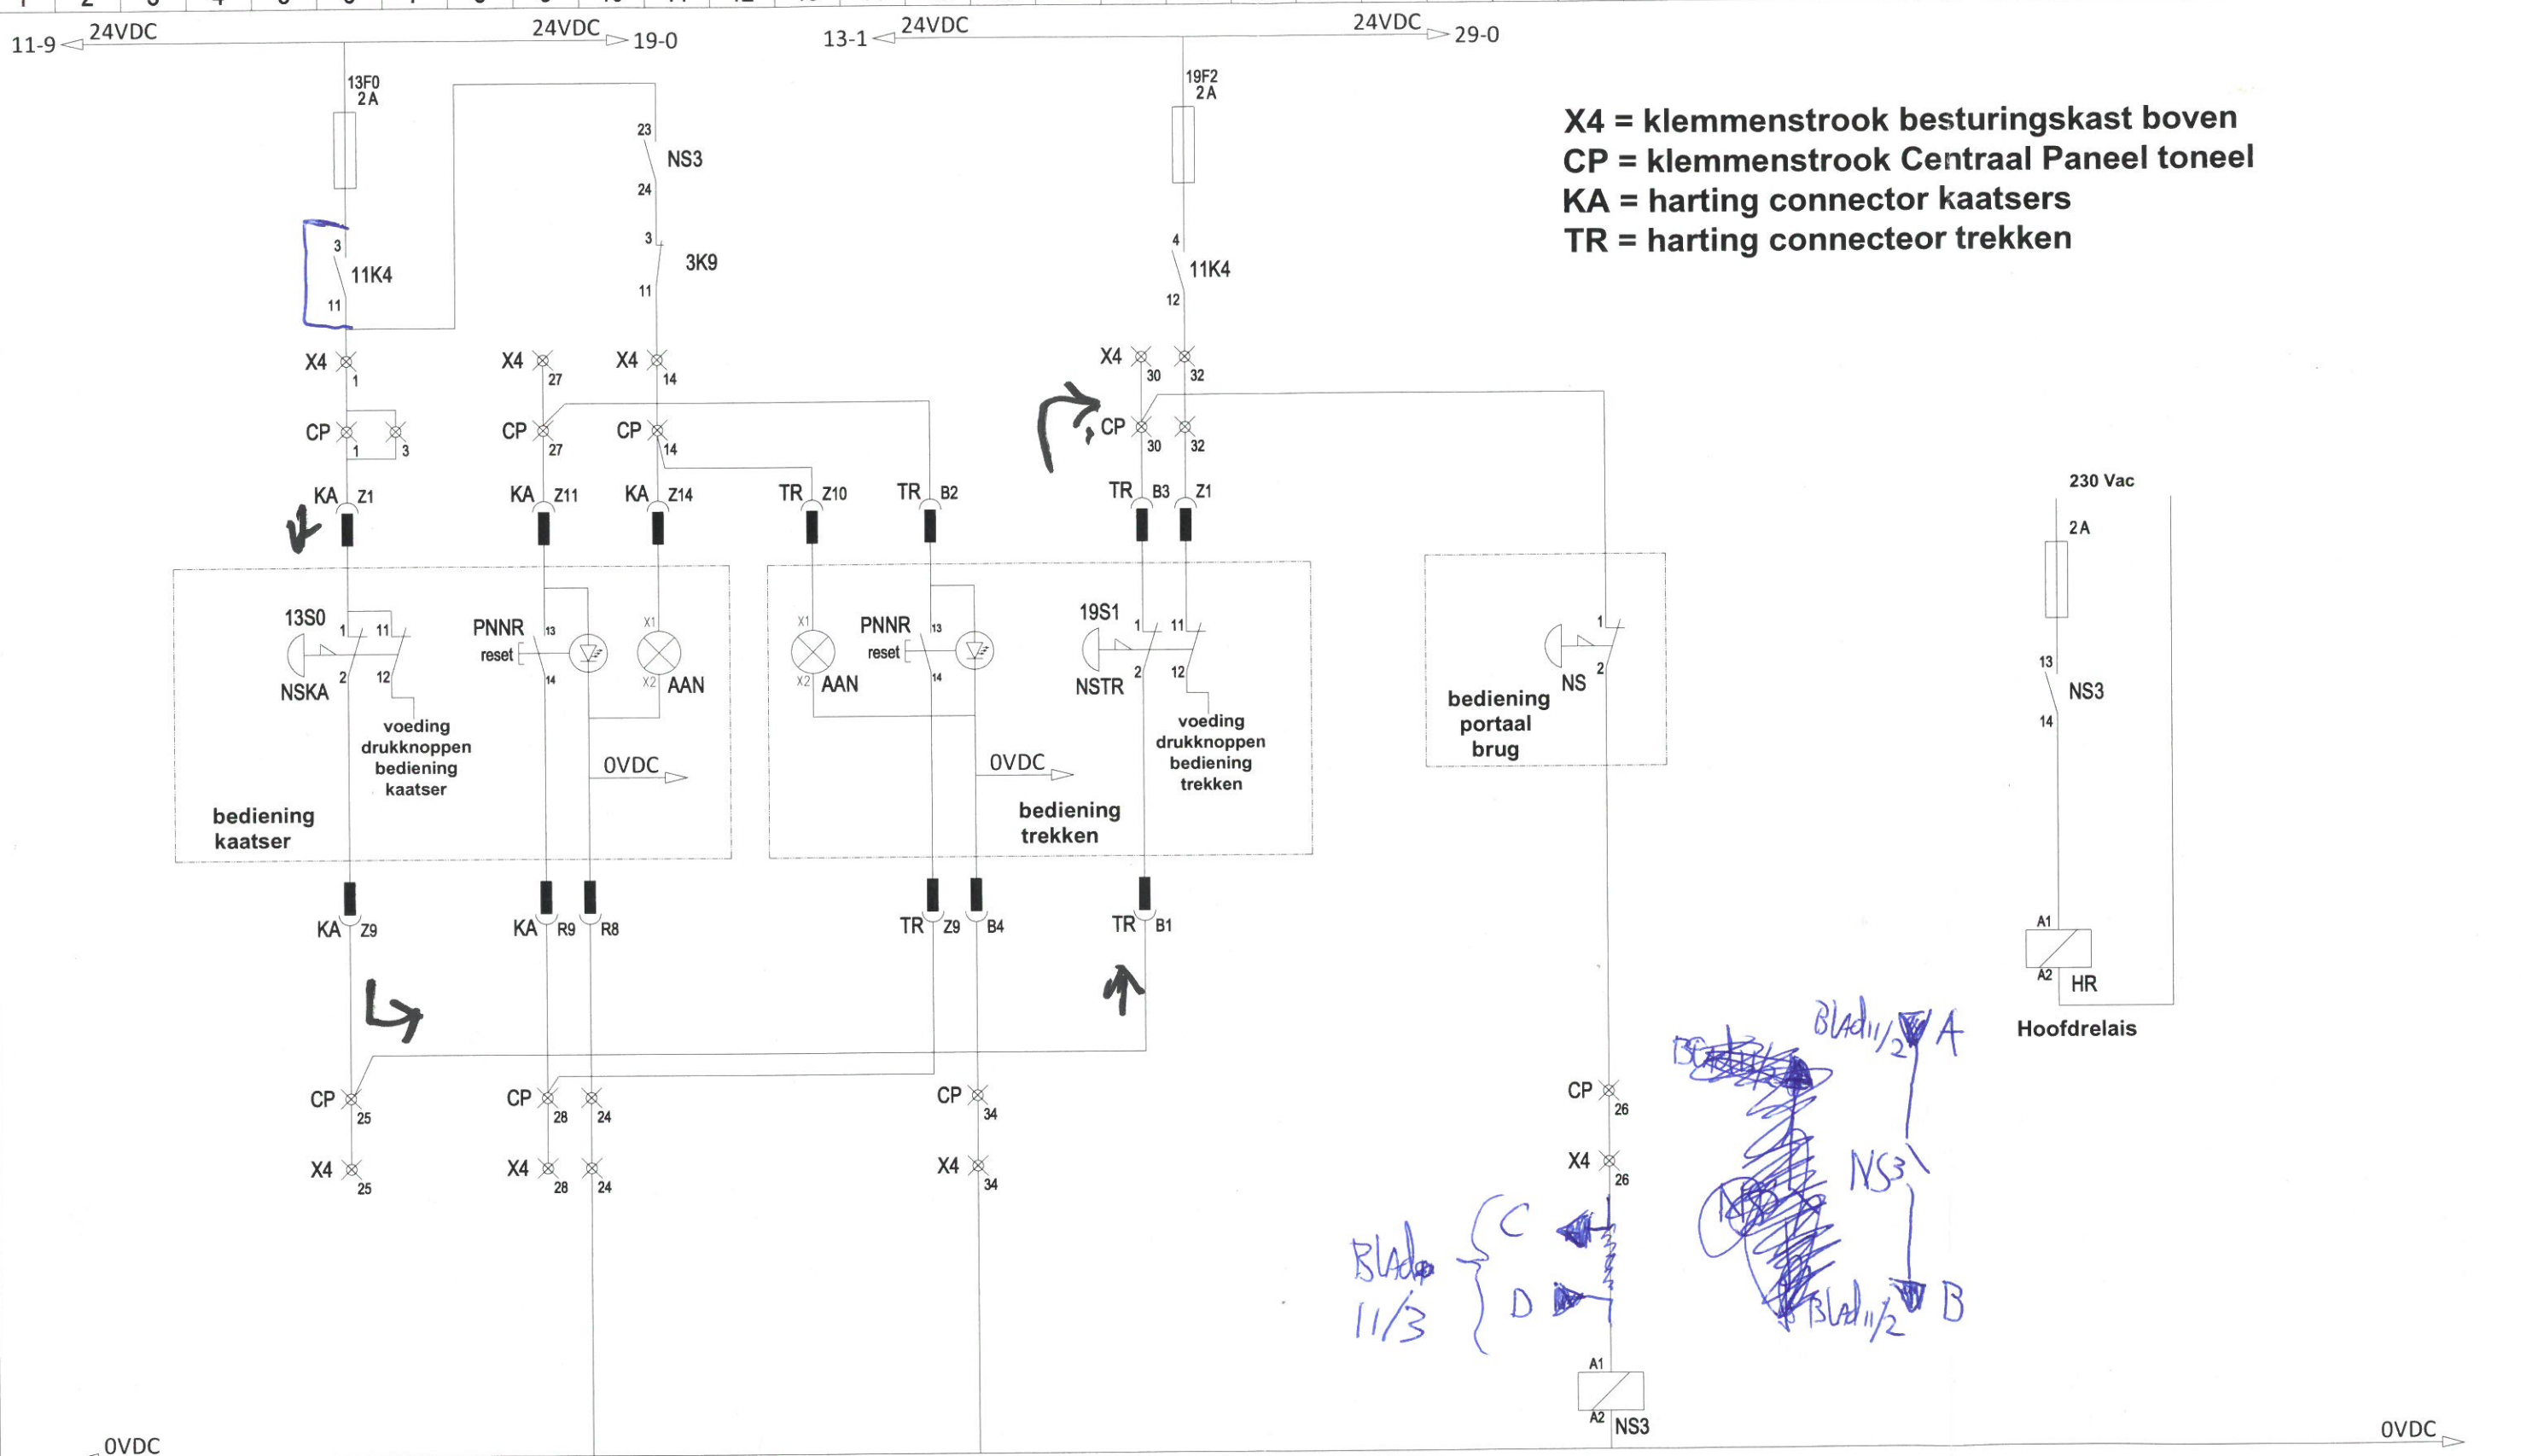

NS aanpassing

Project: Theater Rotterdam
Street: schouwburgplein
Zip code: City: Rotterdam
Tel: Fax:

Titel: Aanpassing NS systeem

Drawn by: AOR
Size: A3
Date print: 16-10-2019

Rev.: Date:
Date: 16-10-2019



Project nr.: PR
Production order: PO-
Page nr.: 000