


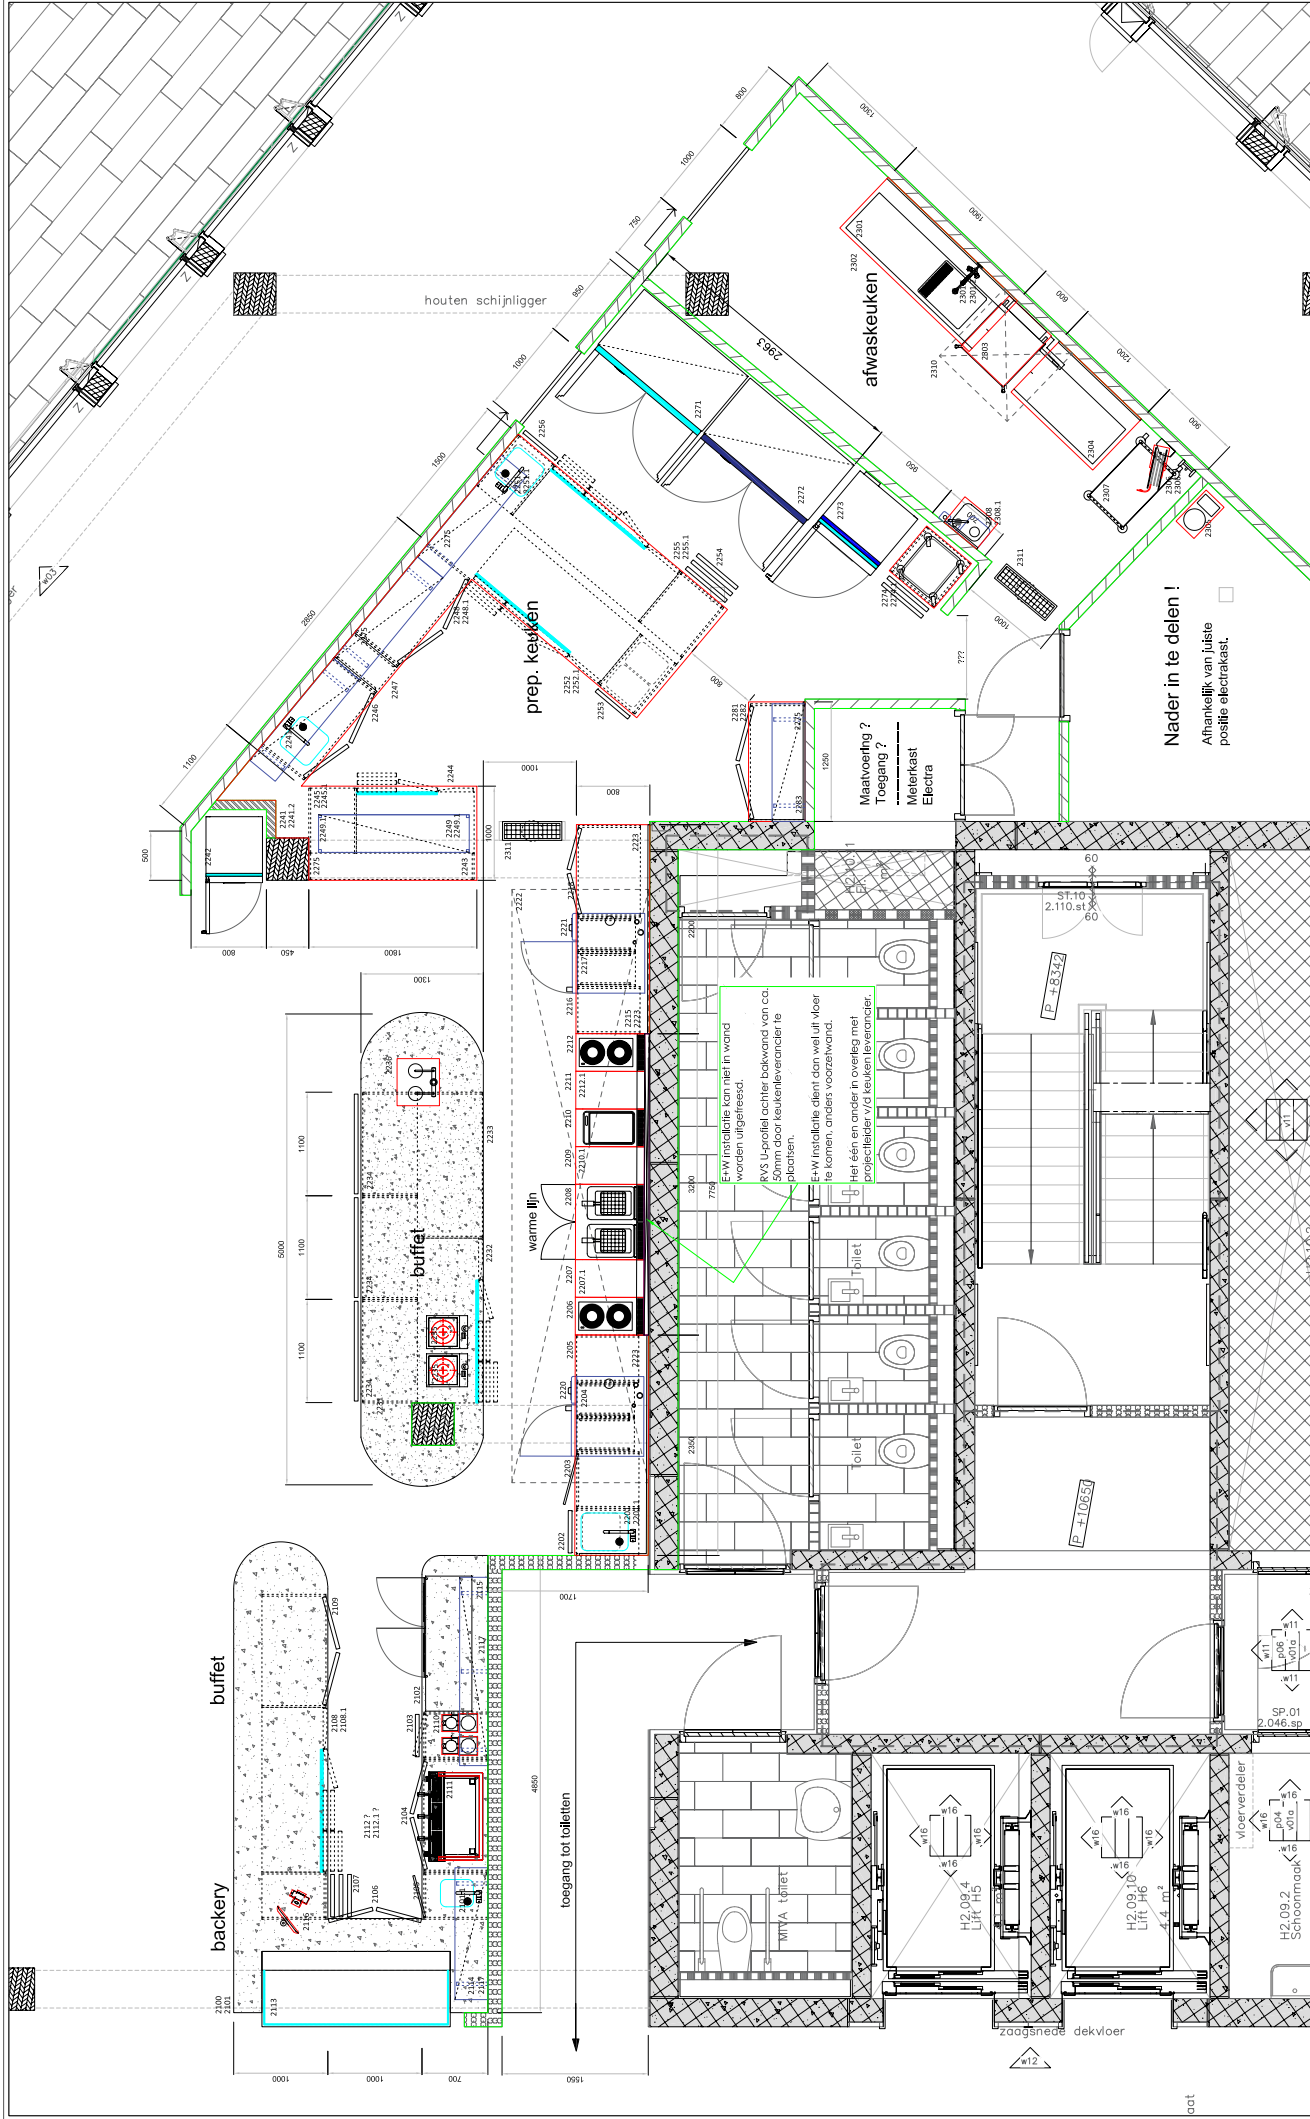

Revision date: 12/7: PDF 202407111 Dordthuis 24/09: Buffet B=1300mm	HORECA DEVELOPMENT    	project: Horeca Development BV Dordthuis Lichtoven 344 5611BJ Elsthoven, The Netherlands Phone: +31 (0)88 3463450 E-mail: info@horecadevelopment.com www.horecadevelopment.com	drawing title: Keukens 2e verdieping start date: 01-05-2024 scale: 1:100 format: A3	last version: 24-09-24 drawing no. HD2421 - X
Horeca Development makes no representation or warranties, express or implied, with respect to the reuse of the data provided herewith, regardless of its format or the means of its transmission. There is no guarantee or representation to the user as to the accuracy, currency, suitability or reliability of this data for any purpose. The user accepts the data 'as is', and assumes all risks associated with its use. By acceptance of this data, the user agrees not to transmit this data or provide access or any part of it to another party unless the user shall include with the data a copy of this disclaimer. Horeca Development assumes no responsibility for actual or consequential damage incurred as a result of any user's reliance on this data.				