


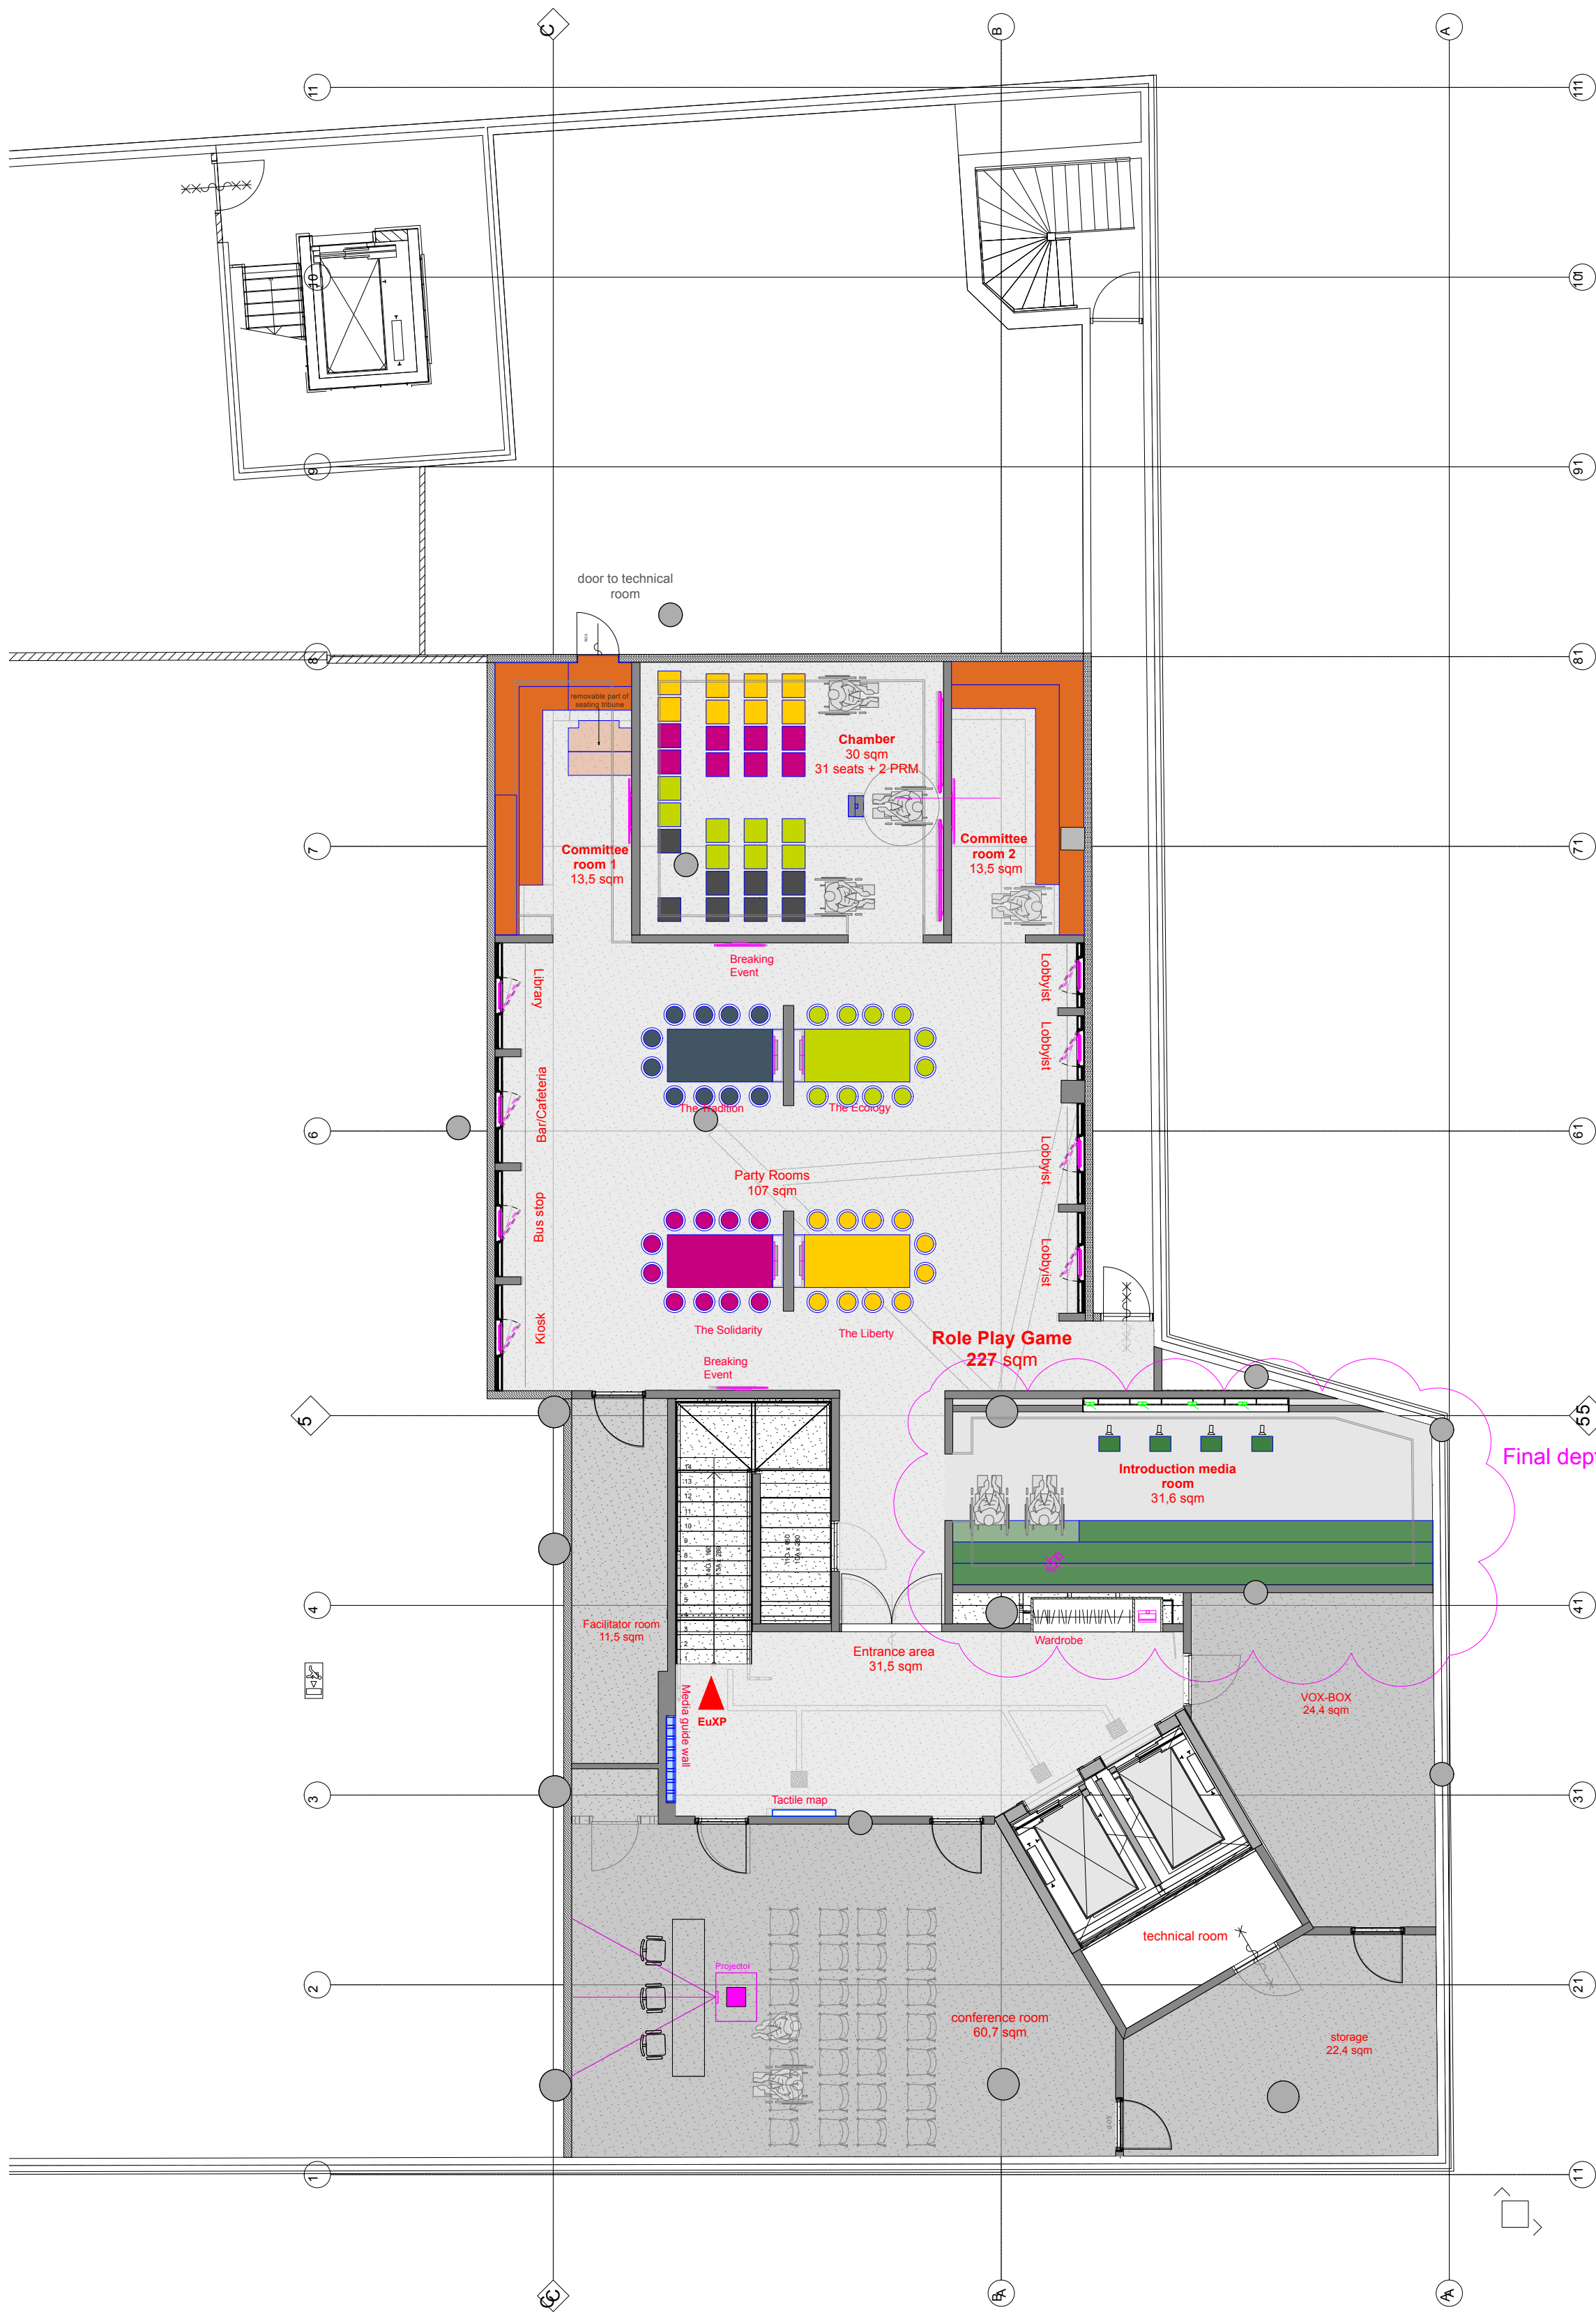

LEGEND	
	Power Socket (power must be switchable - KNX/EIB)
	CAT direct (direct means cable without additional element in between - no switch, no router...)
	CAT
	Power over Ethernet
	Power Socket for light (DALI/DMX control)
	Speaker cable
	DG INLO / OWNER
	DG INLO / OWNER
	DG INLO / OWNER
	DG COMM / Fit-out contractor
	DG COMM / AV Hardware contractor
	ATB planning


PLANNERS / EXPERTS	
Planning	ATELIER BRÜCKNER GMBH
Exhibition	Krefelder Strasse 32
Szenography	70376 Stuttgart Germany
	T. +49 711 5000 77 0
	EUROPA-CONSTRUCTION@ATELIER-BRUECKNER.COM

Media	
Planning	

INDEX			
Ind.	Date	Drawn	Comment
D	17.06.25	as	Detail Design - P&N scope appraisal
C	30.04.25	as	Detail Design - First Issue
B	28.02.25	as	Updated INLO layout
A	26.06.24		Tactile floor markings, removal door to facilitator room

PROJECT TITEL	Europa Experience The Hague
	Grote Marktstraat 18
	2511 Den Haag
	Netherlands

KEY PLAN

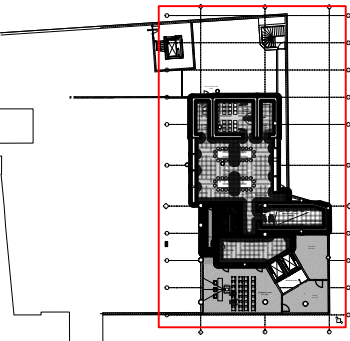

Basement_RPG_Overview

Concept Design

Client

DG COMM

Rue Wiertz, 60

B-1047 Brussels Belgium

T. +32 2 284 43 97

Planning	ATELIER BRÜCKNER GMBH
Exhibition	Krefelder Strasse 32
Szenography	70376 Stuttgart Germany
	T. +49 711 5000 77 0
	EUROPA-CONSTRUCTION@ATELIER-BRUECKNER.COM

paper size	scale	unit	sign
ISO A1	1:100	mm	td

File name			
EE_HAG_ATB_FP_0.2.0.0.01.01_Basement_RPG_Overview			

date	project code	planningphase
30.04.25	EE_HAG	DD

type_hierarchie_no.	Index
FP_0.2.0.0.01.01	D