
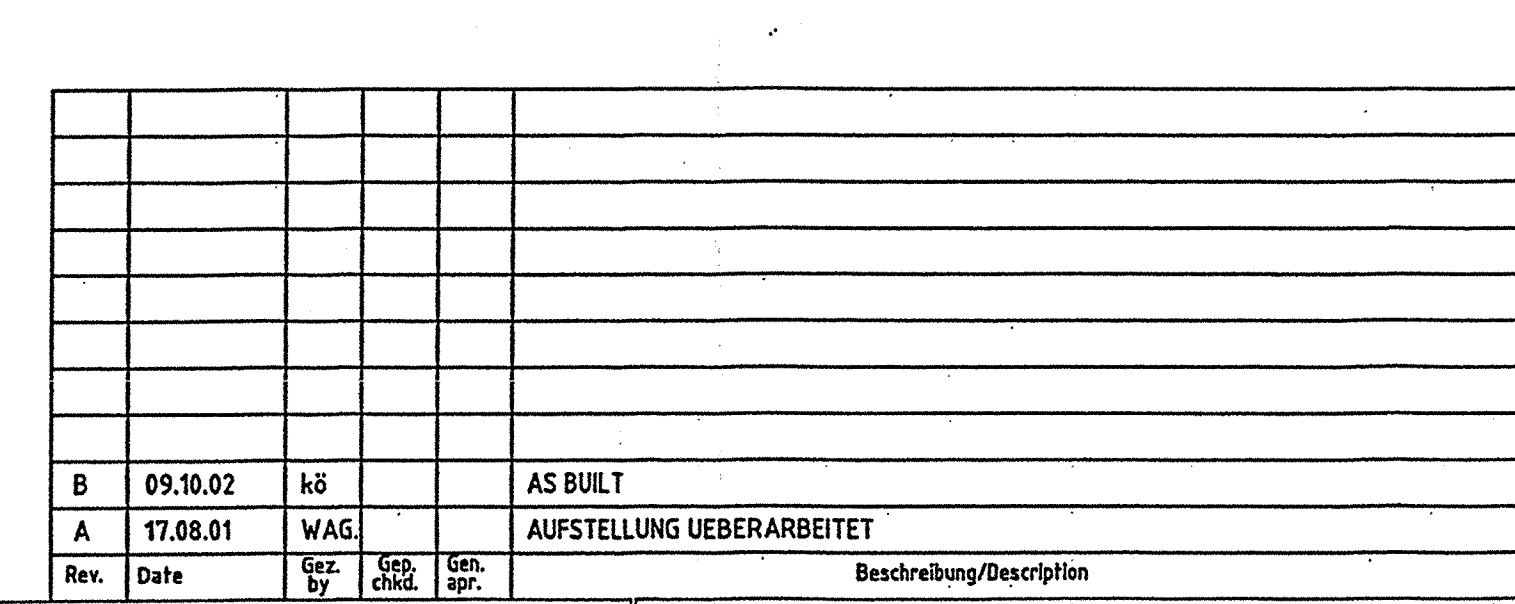


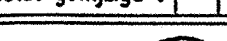

Frei zur Ausführung Construction approval	
--	--

		Anlage/Project:		SUSTEREN	
		Kunde/Client:		ZUIVERINGSCHAP LIMBURG	
HAUT-NO		Relatatie: Department:			
Maat: 150	Opzet Date:	Titel:		OPSTELLING PLAN	
Scale: 1:50	Opzet Date: 15.01	Details:		AANZICHT NOORD AS 1-2	
Gepl. Draad: KOENIG		SLIBDROOGINGSTALLATIE		BLOONR 1 VAN 8	
Keur. Chid:					
VATECH WABAG		NTA		K2500832	300 000 623
Flasbeet System		Archiv		Auftrag/Job	Project-Zeichnungs-Nr./Drawing Rev.

lootst gewijsd :		gecontr.:			
		Zuiveringschap Limburg		projectnr : tek.nr :	
Adria Theresiaaen 99 Postbus 314 6040 AH Roermond Telefoon 0475-394444 Telefax 0475-311605				bladnr : -- van --	
getekend geconroleerd		school : 1 ; 50 formaat : A0		archiefnummer :	